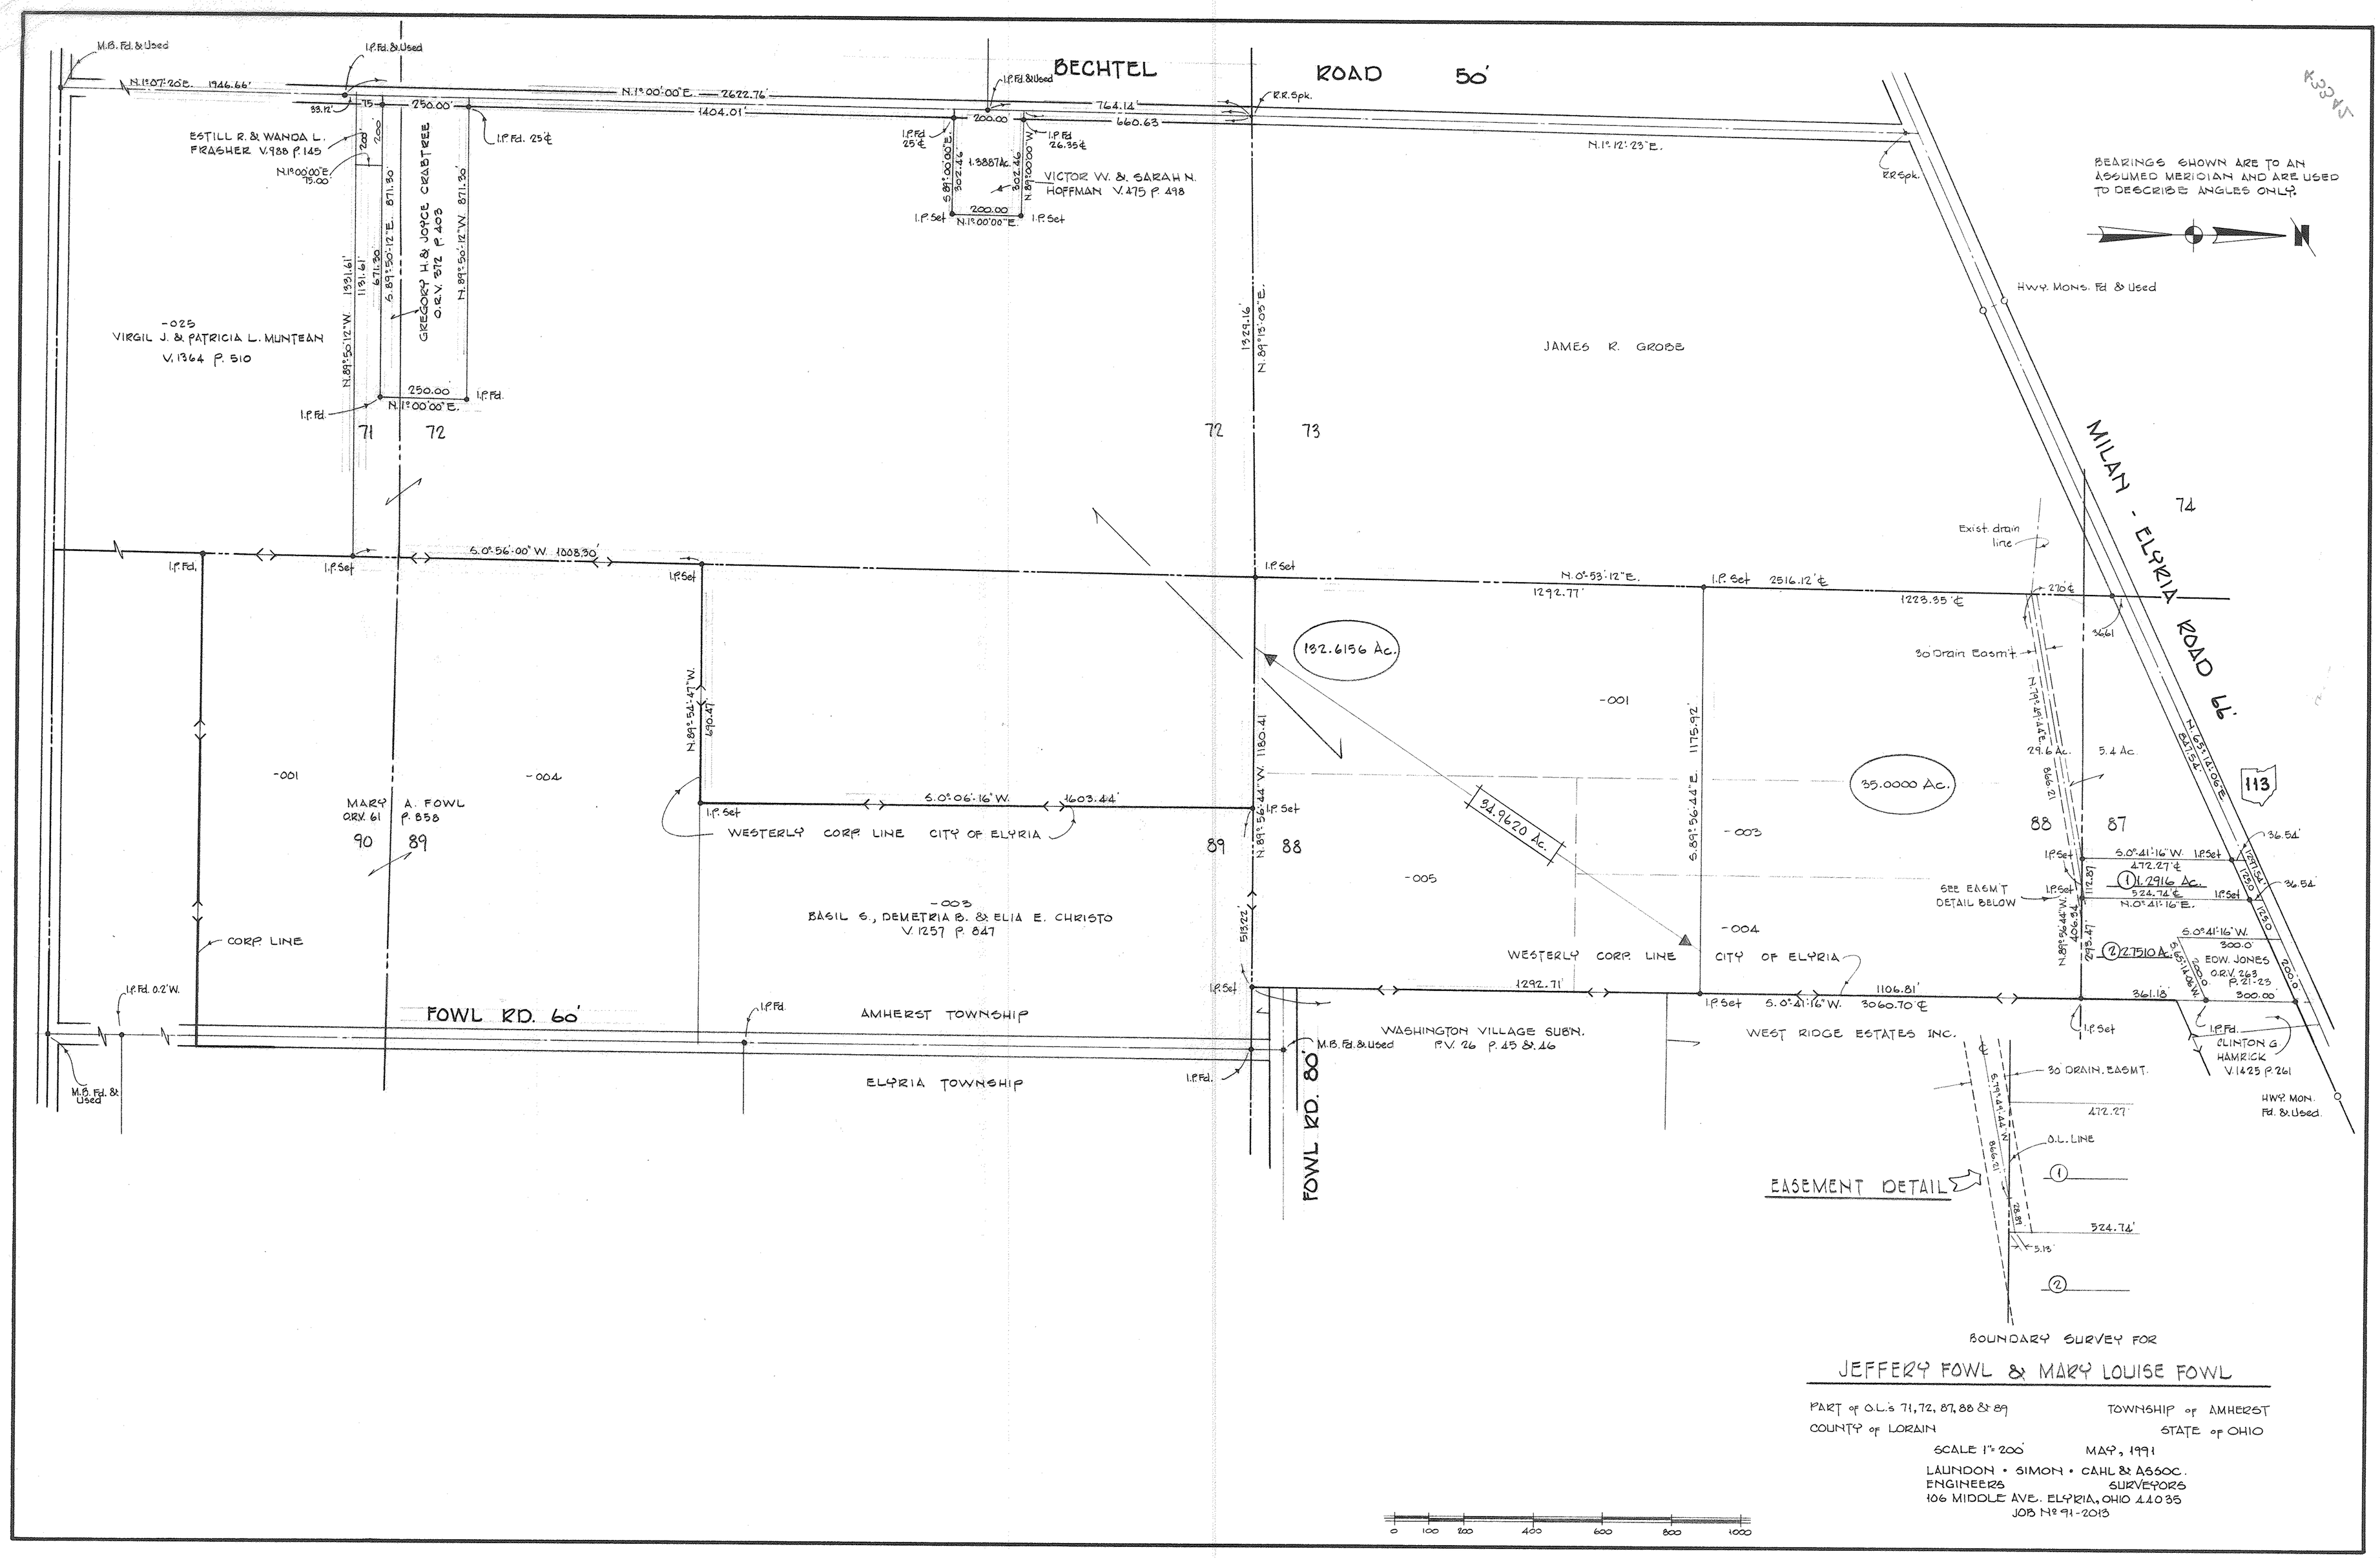
BECHTEL ROAD 50'
M.B. Fd. & Used
I.P. Fd. & Used
N.1°07'20"E. 1946.66'
N.1°00'00"E. 2622.76'
764.14'
1404.01'
660.63'
R.R. Spk.
ESTILL R. & WANDA L. FRASHER V.988 P.145
N.1°00'00"E. 75.00'
GREGORY H. & JOYCE CRABTREE O.R.V. 372 P.403
VICTOR W. & SARAH N. HOFFMAN V.475 P.498
1.3887 Ac.
N.1°12'23"E.
BEARINGS SHOWN ARE TO AN ASSUMED MERIDIAN AND ARE USED TO DESCRIBE ANGLES ONLY.
-025
VIRGIL J. & PATRICIA L. MUNTEAN V.1364 P.510
JAMES R. GROBE
Hwy. Mons. Fd. & Used
MILAN - ELYRIA ROAD 66'
132.6156 Ac.
34.9620 Ac.
35.0000 Ac.
Exist. drain line
30' Drain Easmt.
MARY A. FOWL ORV. 61 P.858
WESTERLY CORP. LINE CITY OF ELYRIA
BASIL G., DEMETRIA B. & ELIA E. CHRISTO V.1257 P.847
CORP. LINE
FOWL RD. 60'
AMHERST TOWNSHIP
ELYRIA TOWNSHIP
WASHINGTON VILLAGE SUBN. P.V. 26 P.45 & 46
WEST RIDGE ESTATES INC.
SEE EASM'T DETAIL BELOW
1.2916 Ac.
2.7510 Ac.
EDW. JONES O.R.V. 263 P.21-23
CLINTON G. HAMRICK V.1425 P.261
30' DRAIN. EASM'T.
O.L. LINE
EASEMENT DETAIL
BOUNDARY SURVEY FOR
JEFFERY FOWL & MARY LOUISE FOWL
PART of O.L.'s 71, 72, 87, 88 & 89
TOWNSHIP of AMHERST
COUNTY of LORAIN
STATE of OHIO
SCALE 1" = 200'
MAY, 1991
LAUNDON • SIMON • CAHL & ASSOC.
ENGINEERS SURVEYORS
106 MIDDLE AVE. ELYRIA, OHIO 44035
JOB № 91-2013