04-00-023-105-041 thru -050
106 thru -115
057
060
-143
-144
139 thru -143
04-00-023-C

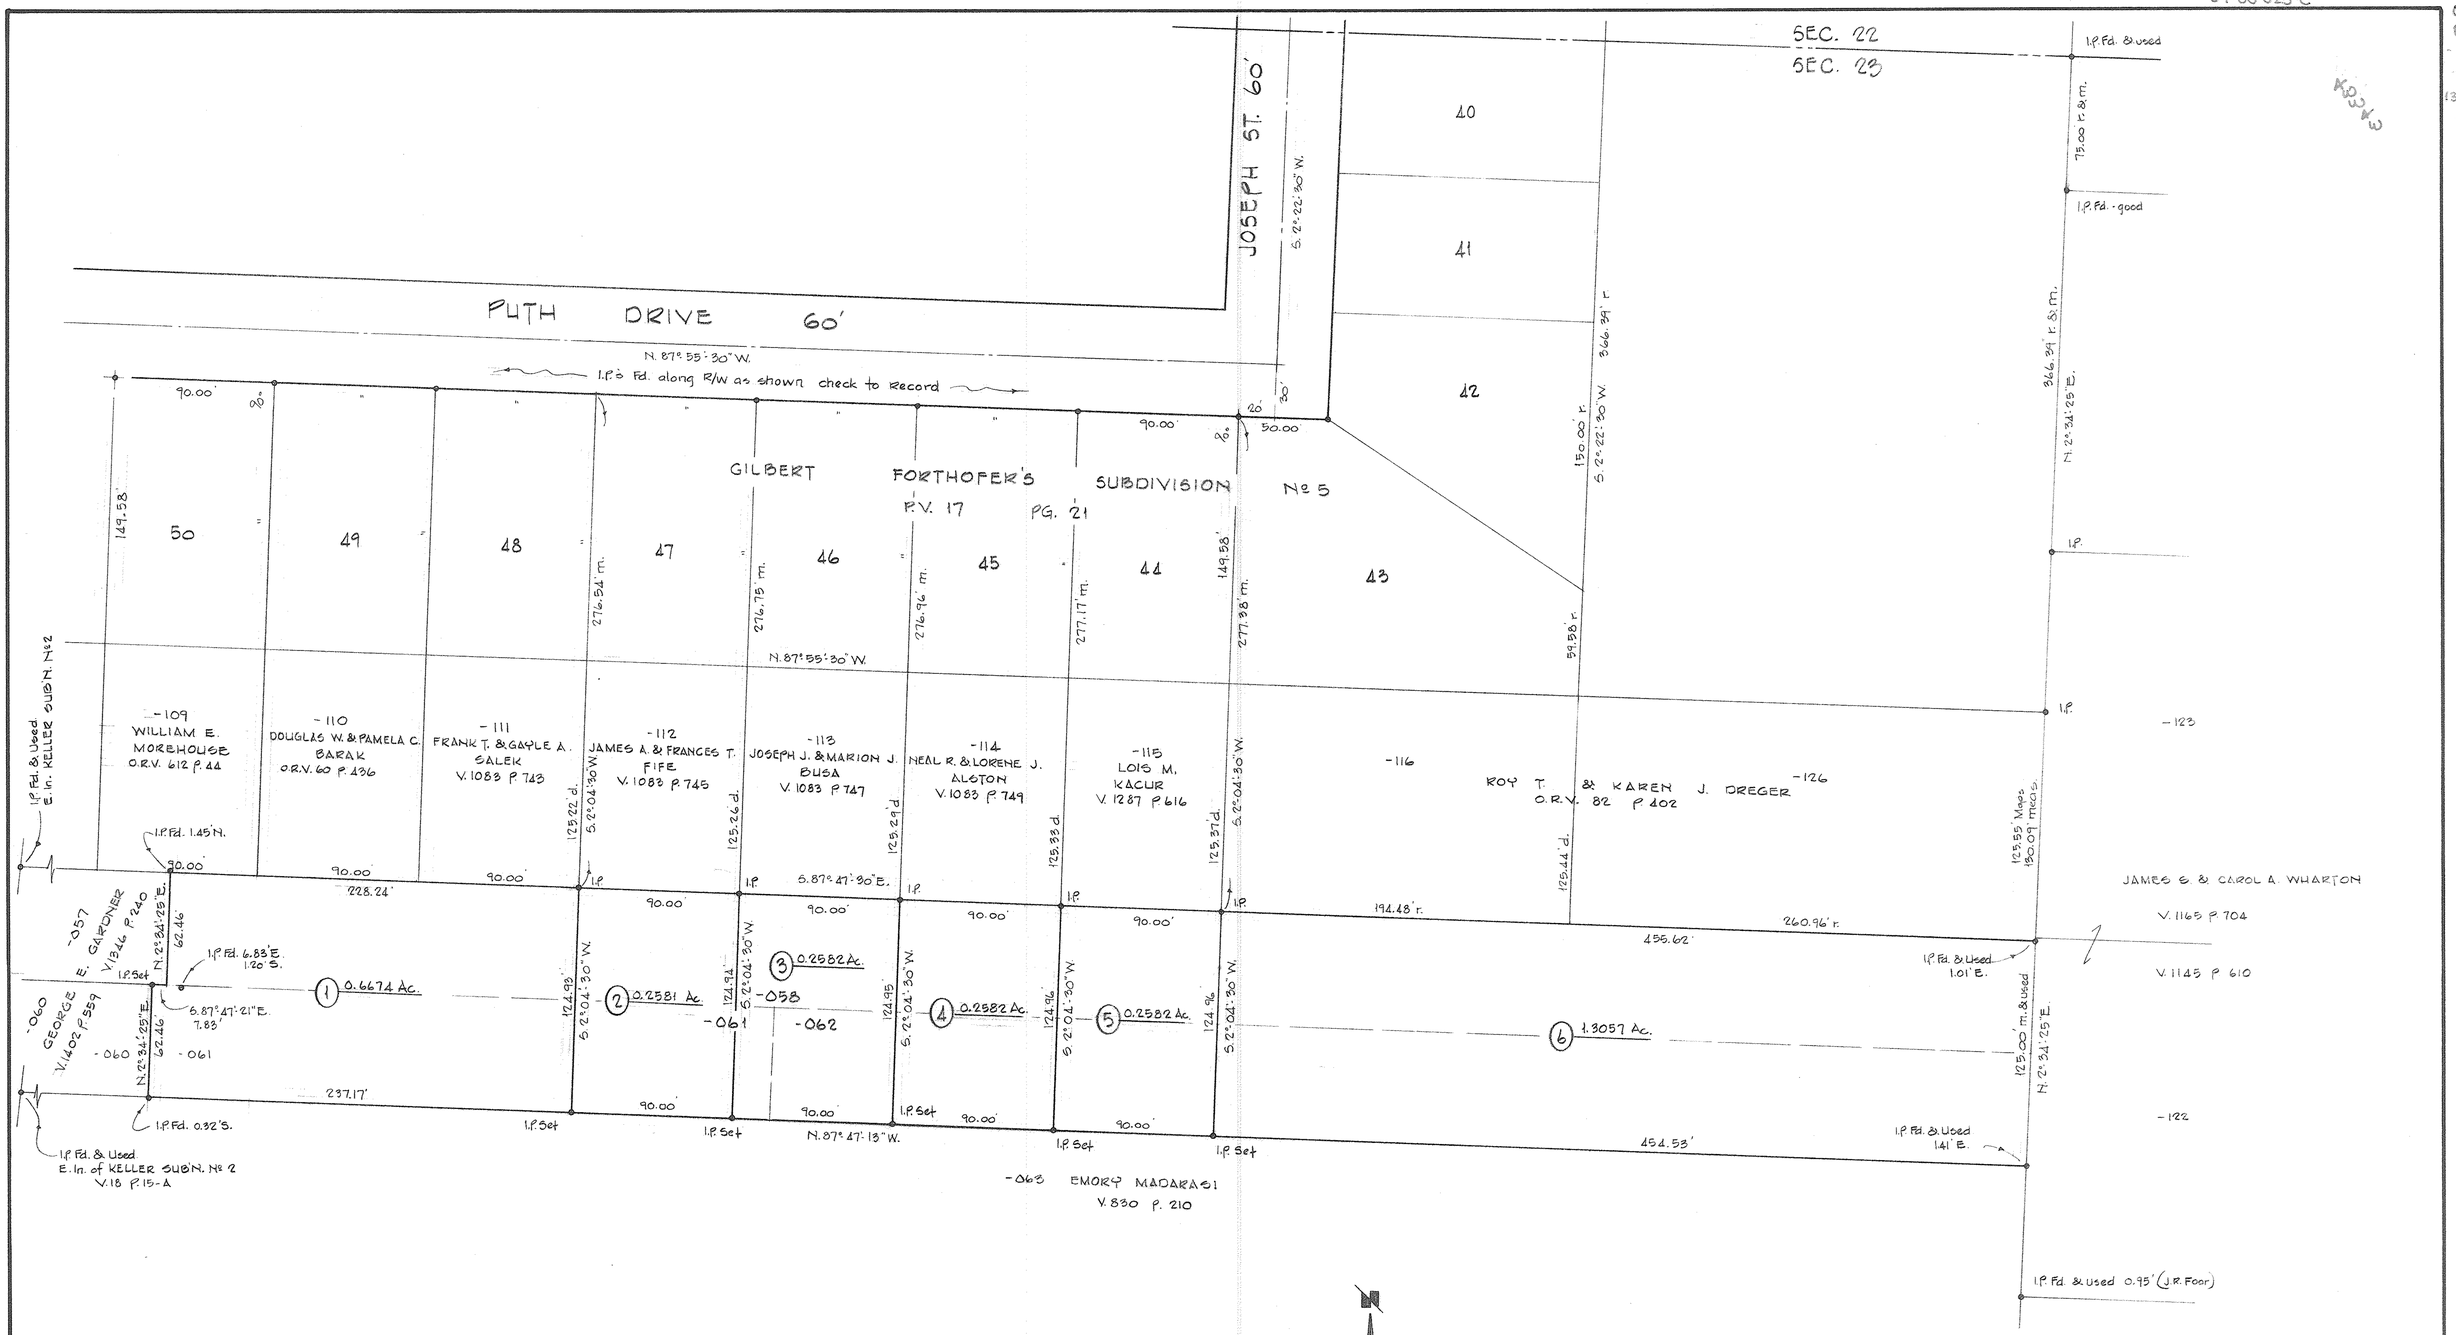

SURVEY & PARCEL SPLIT OF LANDS OF

(-058) J. THOMAS HOLOWECKY & (-061 & -062) GEORGE E. GARDNER

PART OF ORIGINAL SECTION Nº 22 OF AVON TOWNSHIP CITY OF AVON
COUNTY OF LORAIN STATE OF OHIO
DECEMBER, 1993 SCALE 1"=40'

BY

LAUNDON • SIMON • CAHL & ASSOC.
ENGINEERS SURVEYORS
JOB Nº 93-2485

301