BOUNDARY SURVEY

PART OF SHEFFIELD TOWNSHIP ORIGINAL LOT NO. 74
PART OF ELYRIA TOWNSHIP ORIGINAL LOT NO. 6 - BURRELL & DAY TRACT
CITY OF ELYRIA & VILLAGE OF SHEFFIELD COUNTY OF LORAIN STATE OF OHIO

PREPARED BY
KS ASSOCIATES INC.
ENGINEERS SURVEYORS
DAVID L. ELWELL REG. SURV. NO. 6333

STATE OF OHIO — DAVID L. ELWELL 6333 — REGISTERED SURVEYOR

93-642

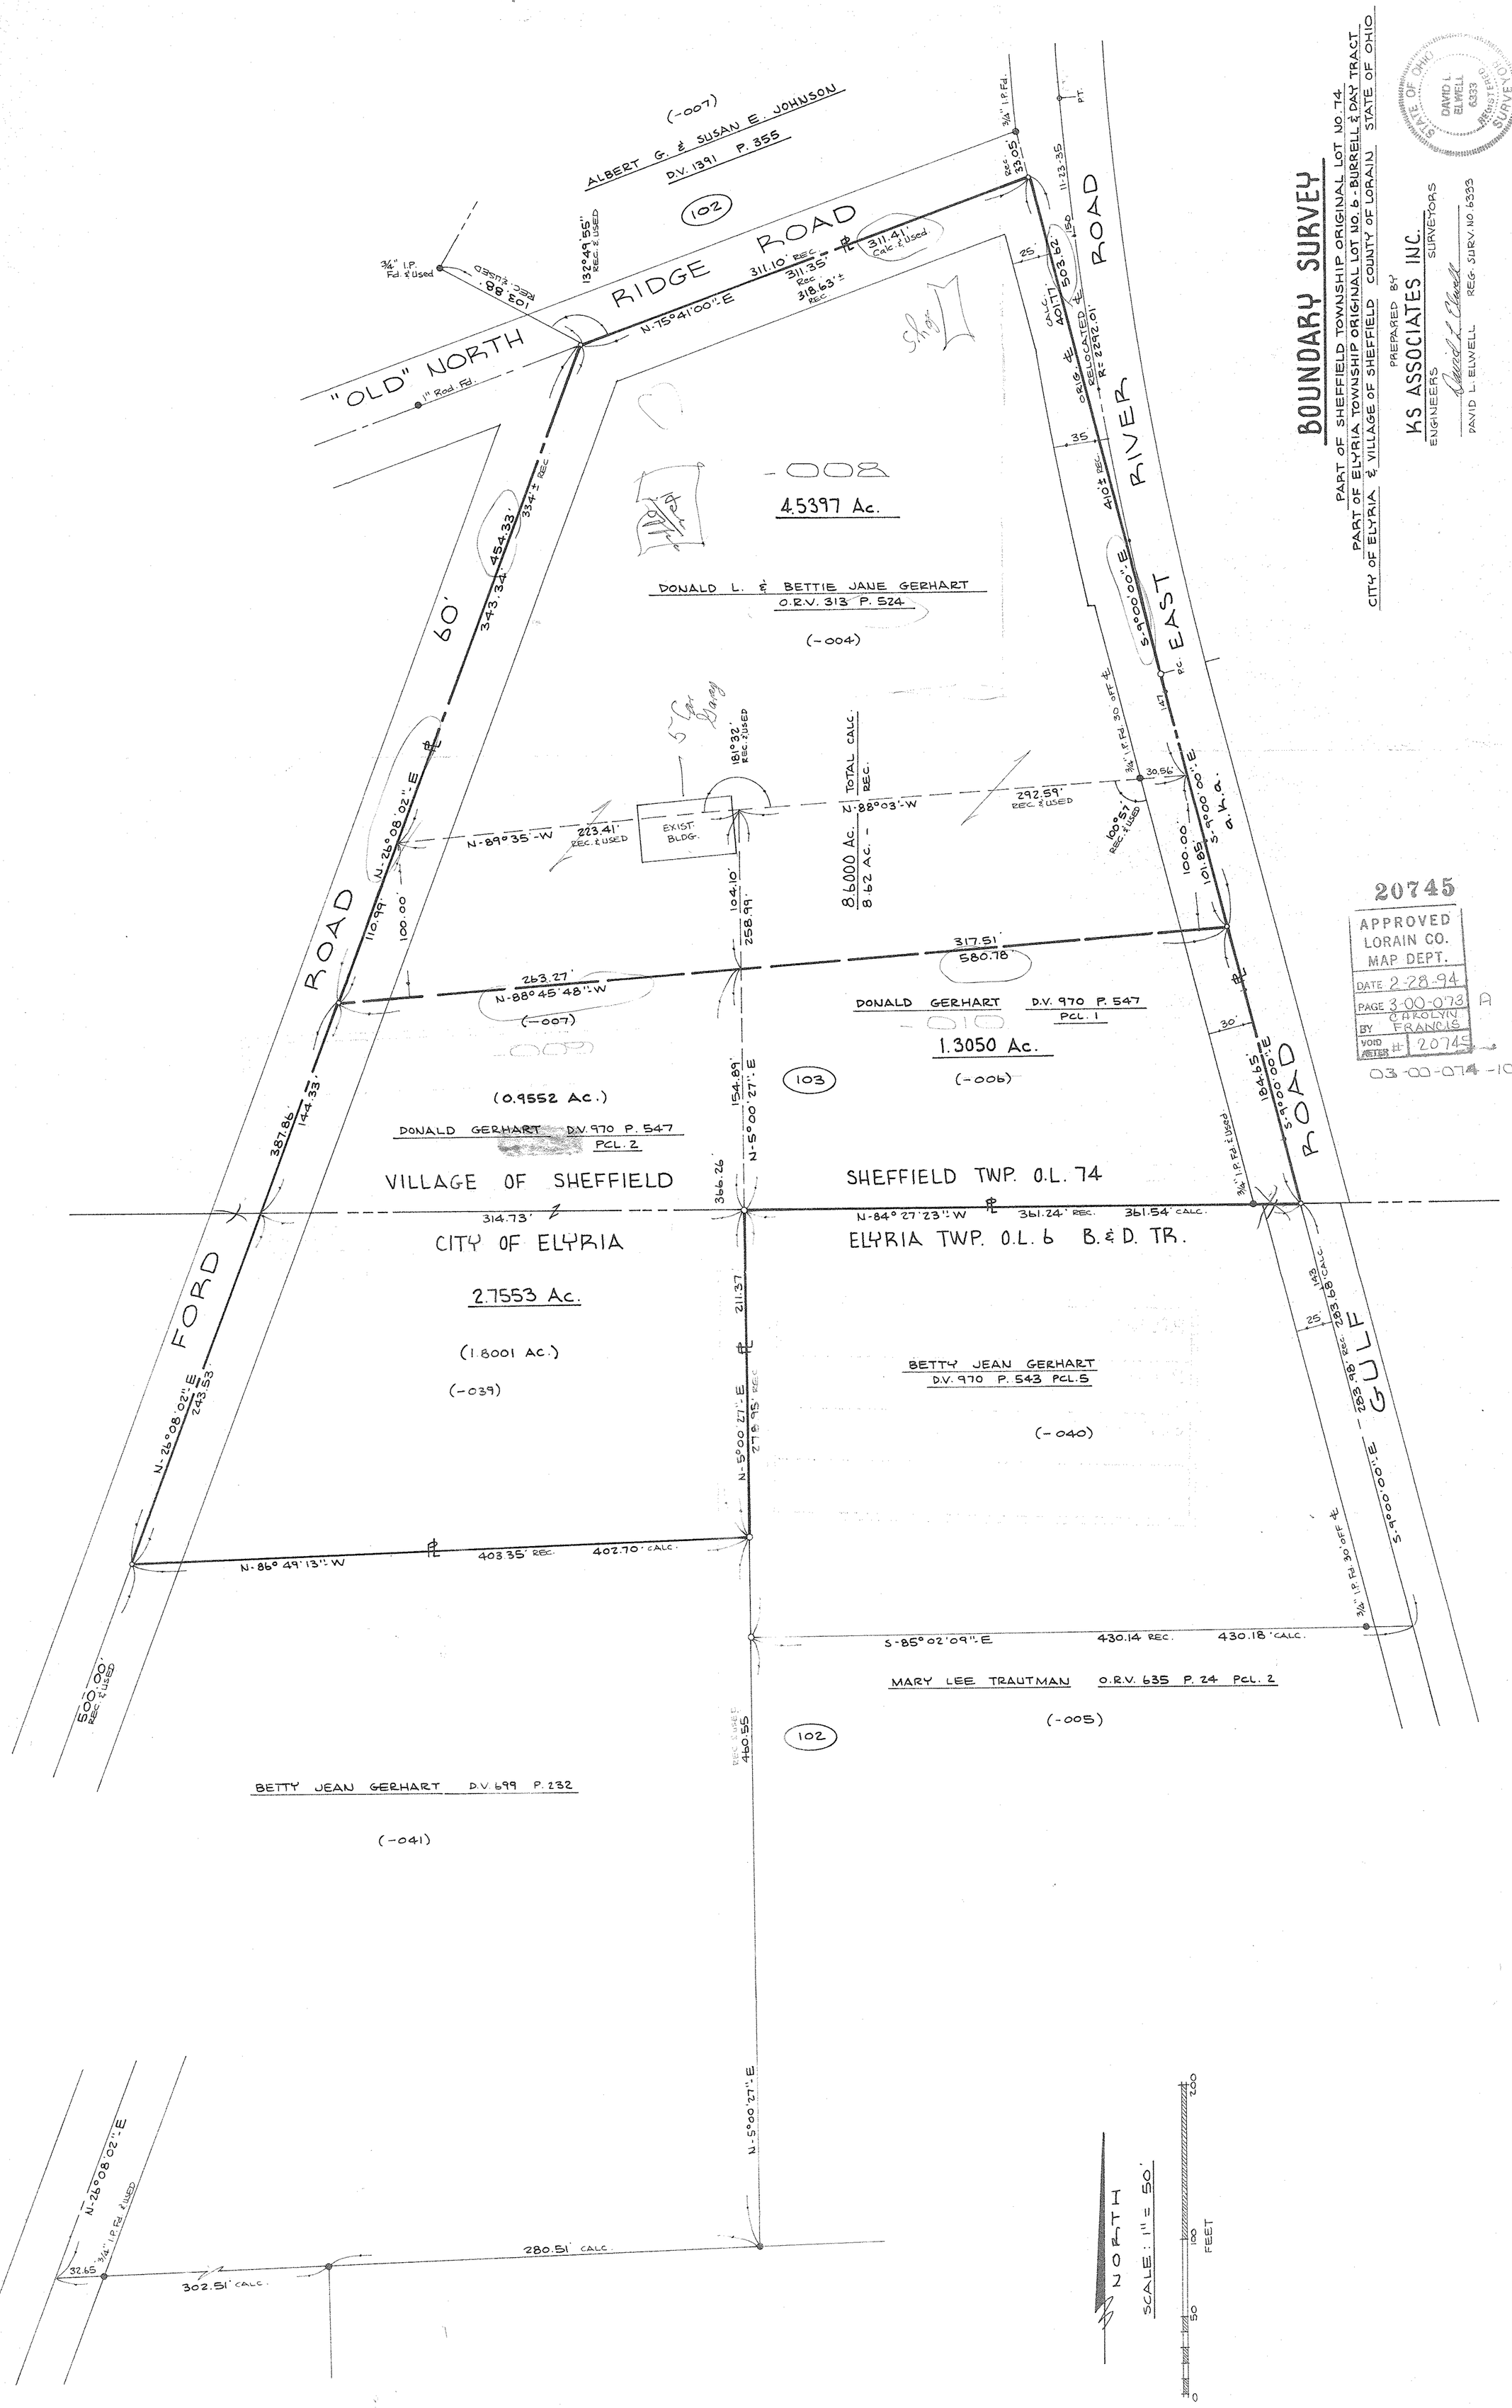

20745
APPROVED
LORAIN CO.
MAP DEPT.
DATE 2-28-94
PAGE 3-00-073 A
BY CAROLYN FRANCIS
VOID AFTER # 20749

03-00-074-103-