

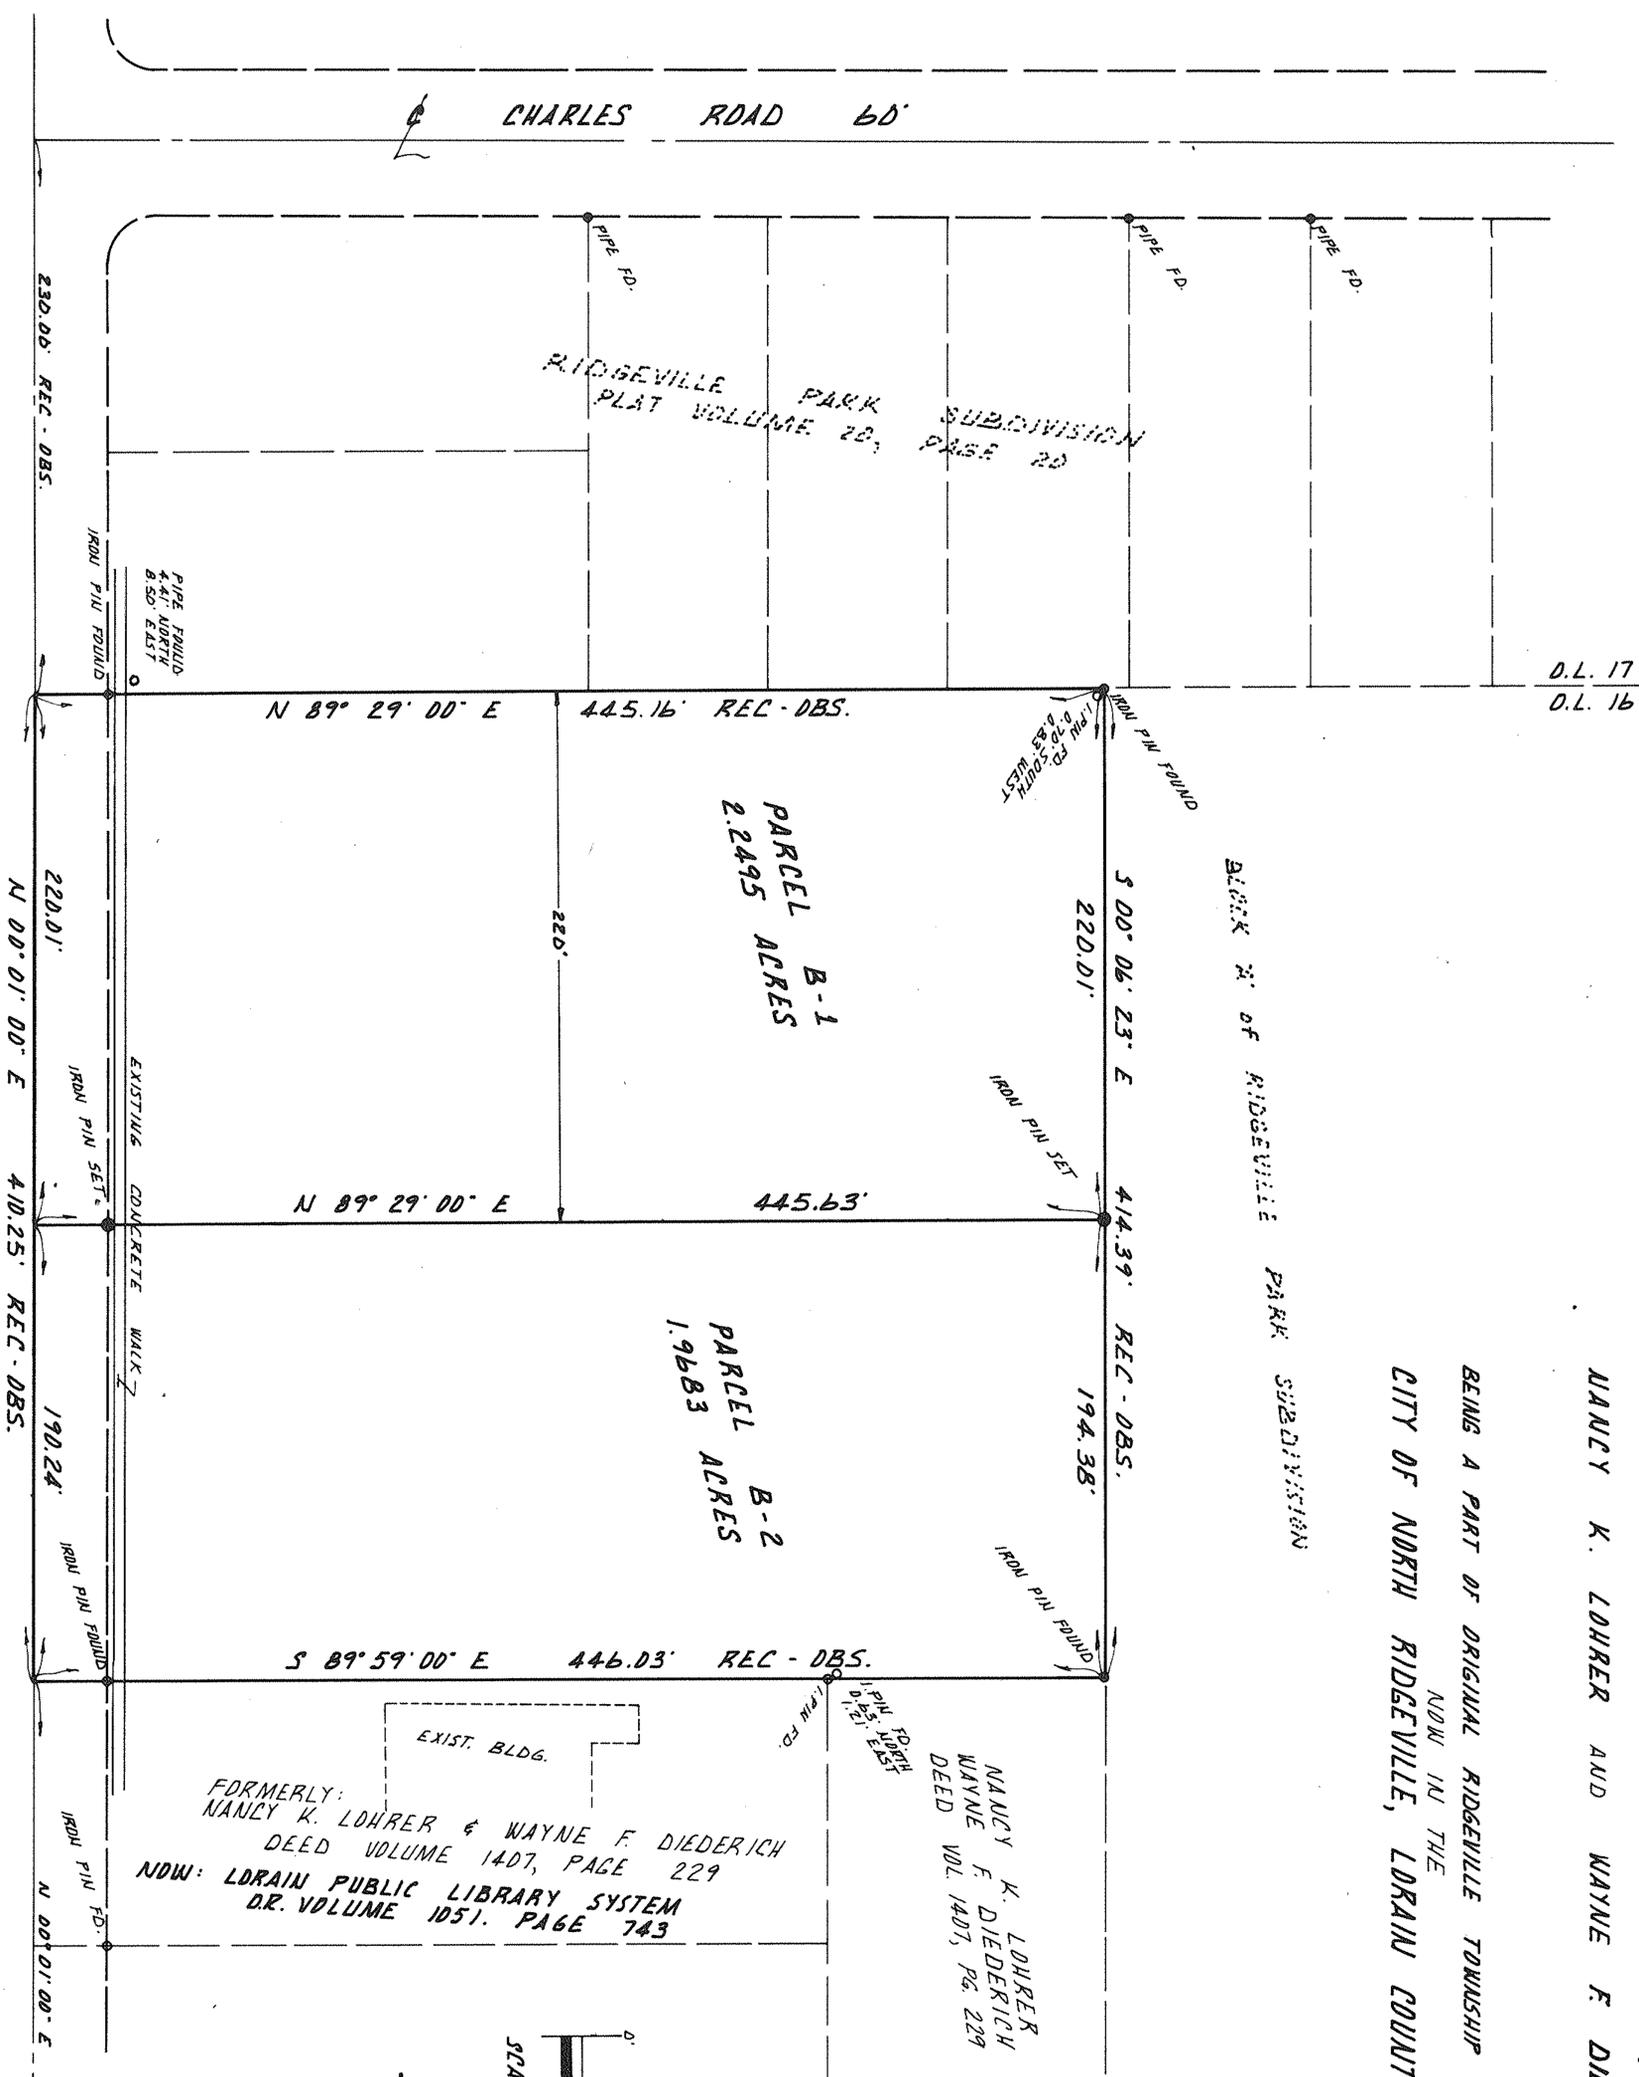


**PLAT OF SURVEY AND PARCEL SPLIT**  
 MADE FOR AND AT THE INSTANCE OF  
**NANCY K. LOHRER AND WAYNE F. DIEDERICH**  
 BEING A PART OF ORIGINAL RIDGEVILLE TOWNSHIP LOT 16 IS  
 NOW IN THE  
**CITY OF NORTH RIDGEVILLE, LORAIN COUNTY, OHIO**

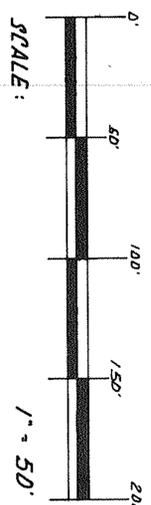

I DECLARE THIS PLAT TO BE A TRUE REPRESENTATION OF AN ACTUAL FIELD SURVEY MADE BY ME IN OCTOBER, 1995, REFERENCED TO THE STANDARDS SET FORTH IN D.C. 4732-37 AND CORRECT TO THE BEST OF MY KNOWLEDGE AND BELIEF. DISTANCES ARE GIVEN IN FEET AND DECIMAL PARTS THEREOF. THE BEARING OF RECORD FOR THE CENTERLINE OF JAYCOX ROAD, PROPERTY CORNERS WERE FOUND OR SET AS INDICATED.

**ZWICK ASSOCIATES, INC.**  
 ENGINEERS • SURVEYORS  
 1344 WEST BAGLEY ROAD  
 BEREA, OHIO 44017-2912  
 218/991-1492  
 FAX 991-1828

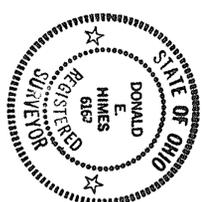

CENTER RIDGE ROAD 65'

JAYCOX ROAD 60'

CHARLES ROAD 60'