Plat of Survey
for
Rhea Cowie

Township 2N, Range 19W
Being a part of Original Lot 29 within Tract 5,
Rochester Township, Lorain County, Ohio

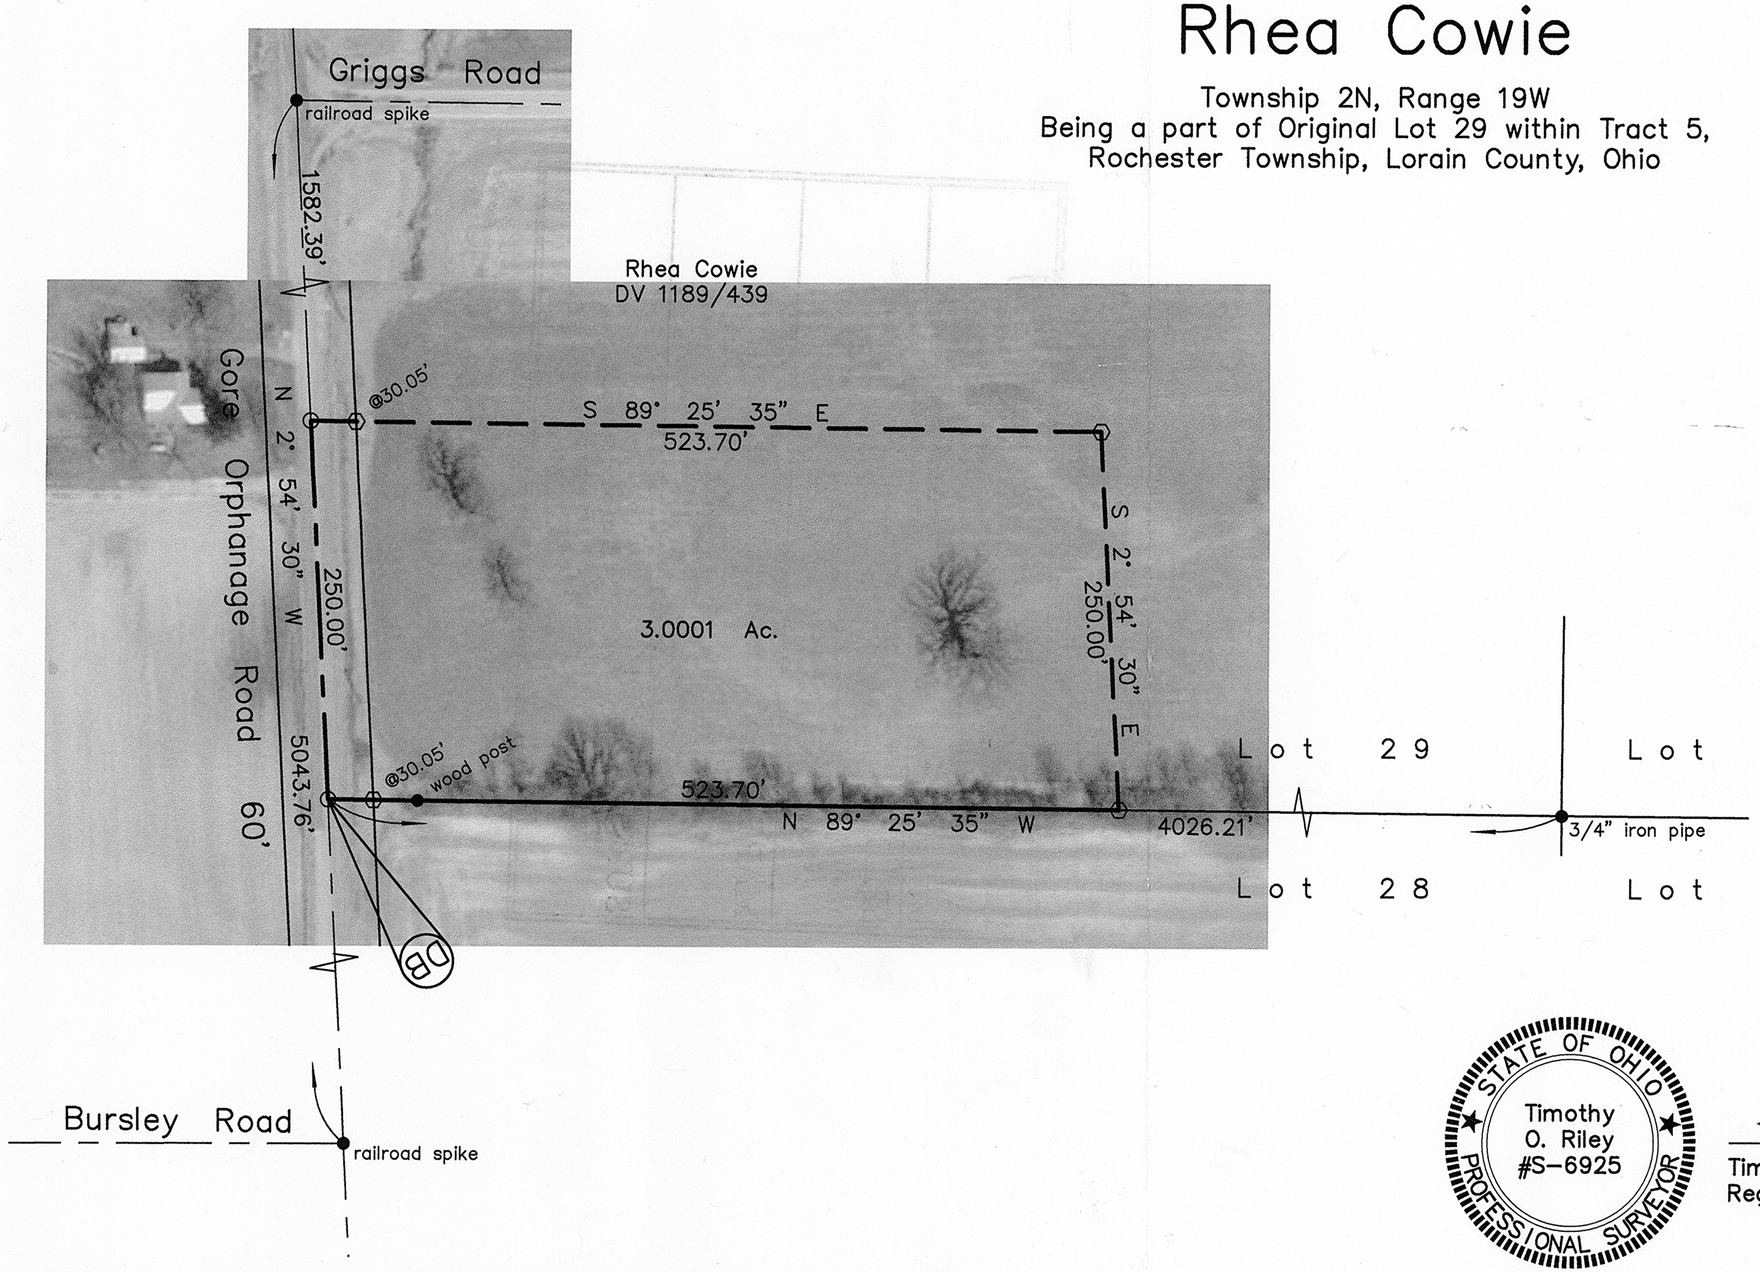

02799
APPROVED
LORAIN CO.
MAP DEPT
DATE 1-29-10
20-05-029-000-001
PAGE 20-B
BY JHatfield
#10-02799

STATE OF OHIO
Timothy
O. Riley
#S-6925
PROFESSIONAL SURVEYOR

Timothy Riley
Timothy Riley
Reg. Surveyor No. 6925

GPS NAD83 Geoid 03

○ 9/16" hex bar set
● Monument found
○ Nail Set
[M] Monument Box
0 1 2 3
Inch Scale
E/C 1:10000

Timothy Riley
ENGINEER - SURVEYOR
Norwalk, Ohio

Date: 12-16-2009	Dwn By: CAD
Scale: 1" = 100'	Ckd By: TOR
Lot 29, Tract 5, Rochester Twp	
Job No. 32009	Gore Orphanage Rd