05-00-061-104-016
-017
-034

5-00-061-A

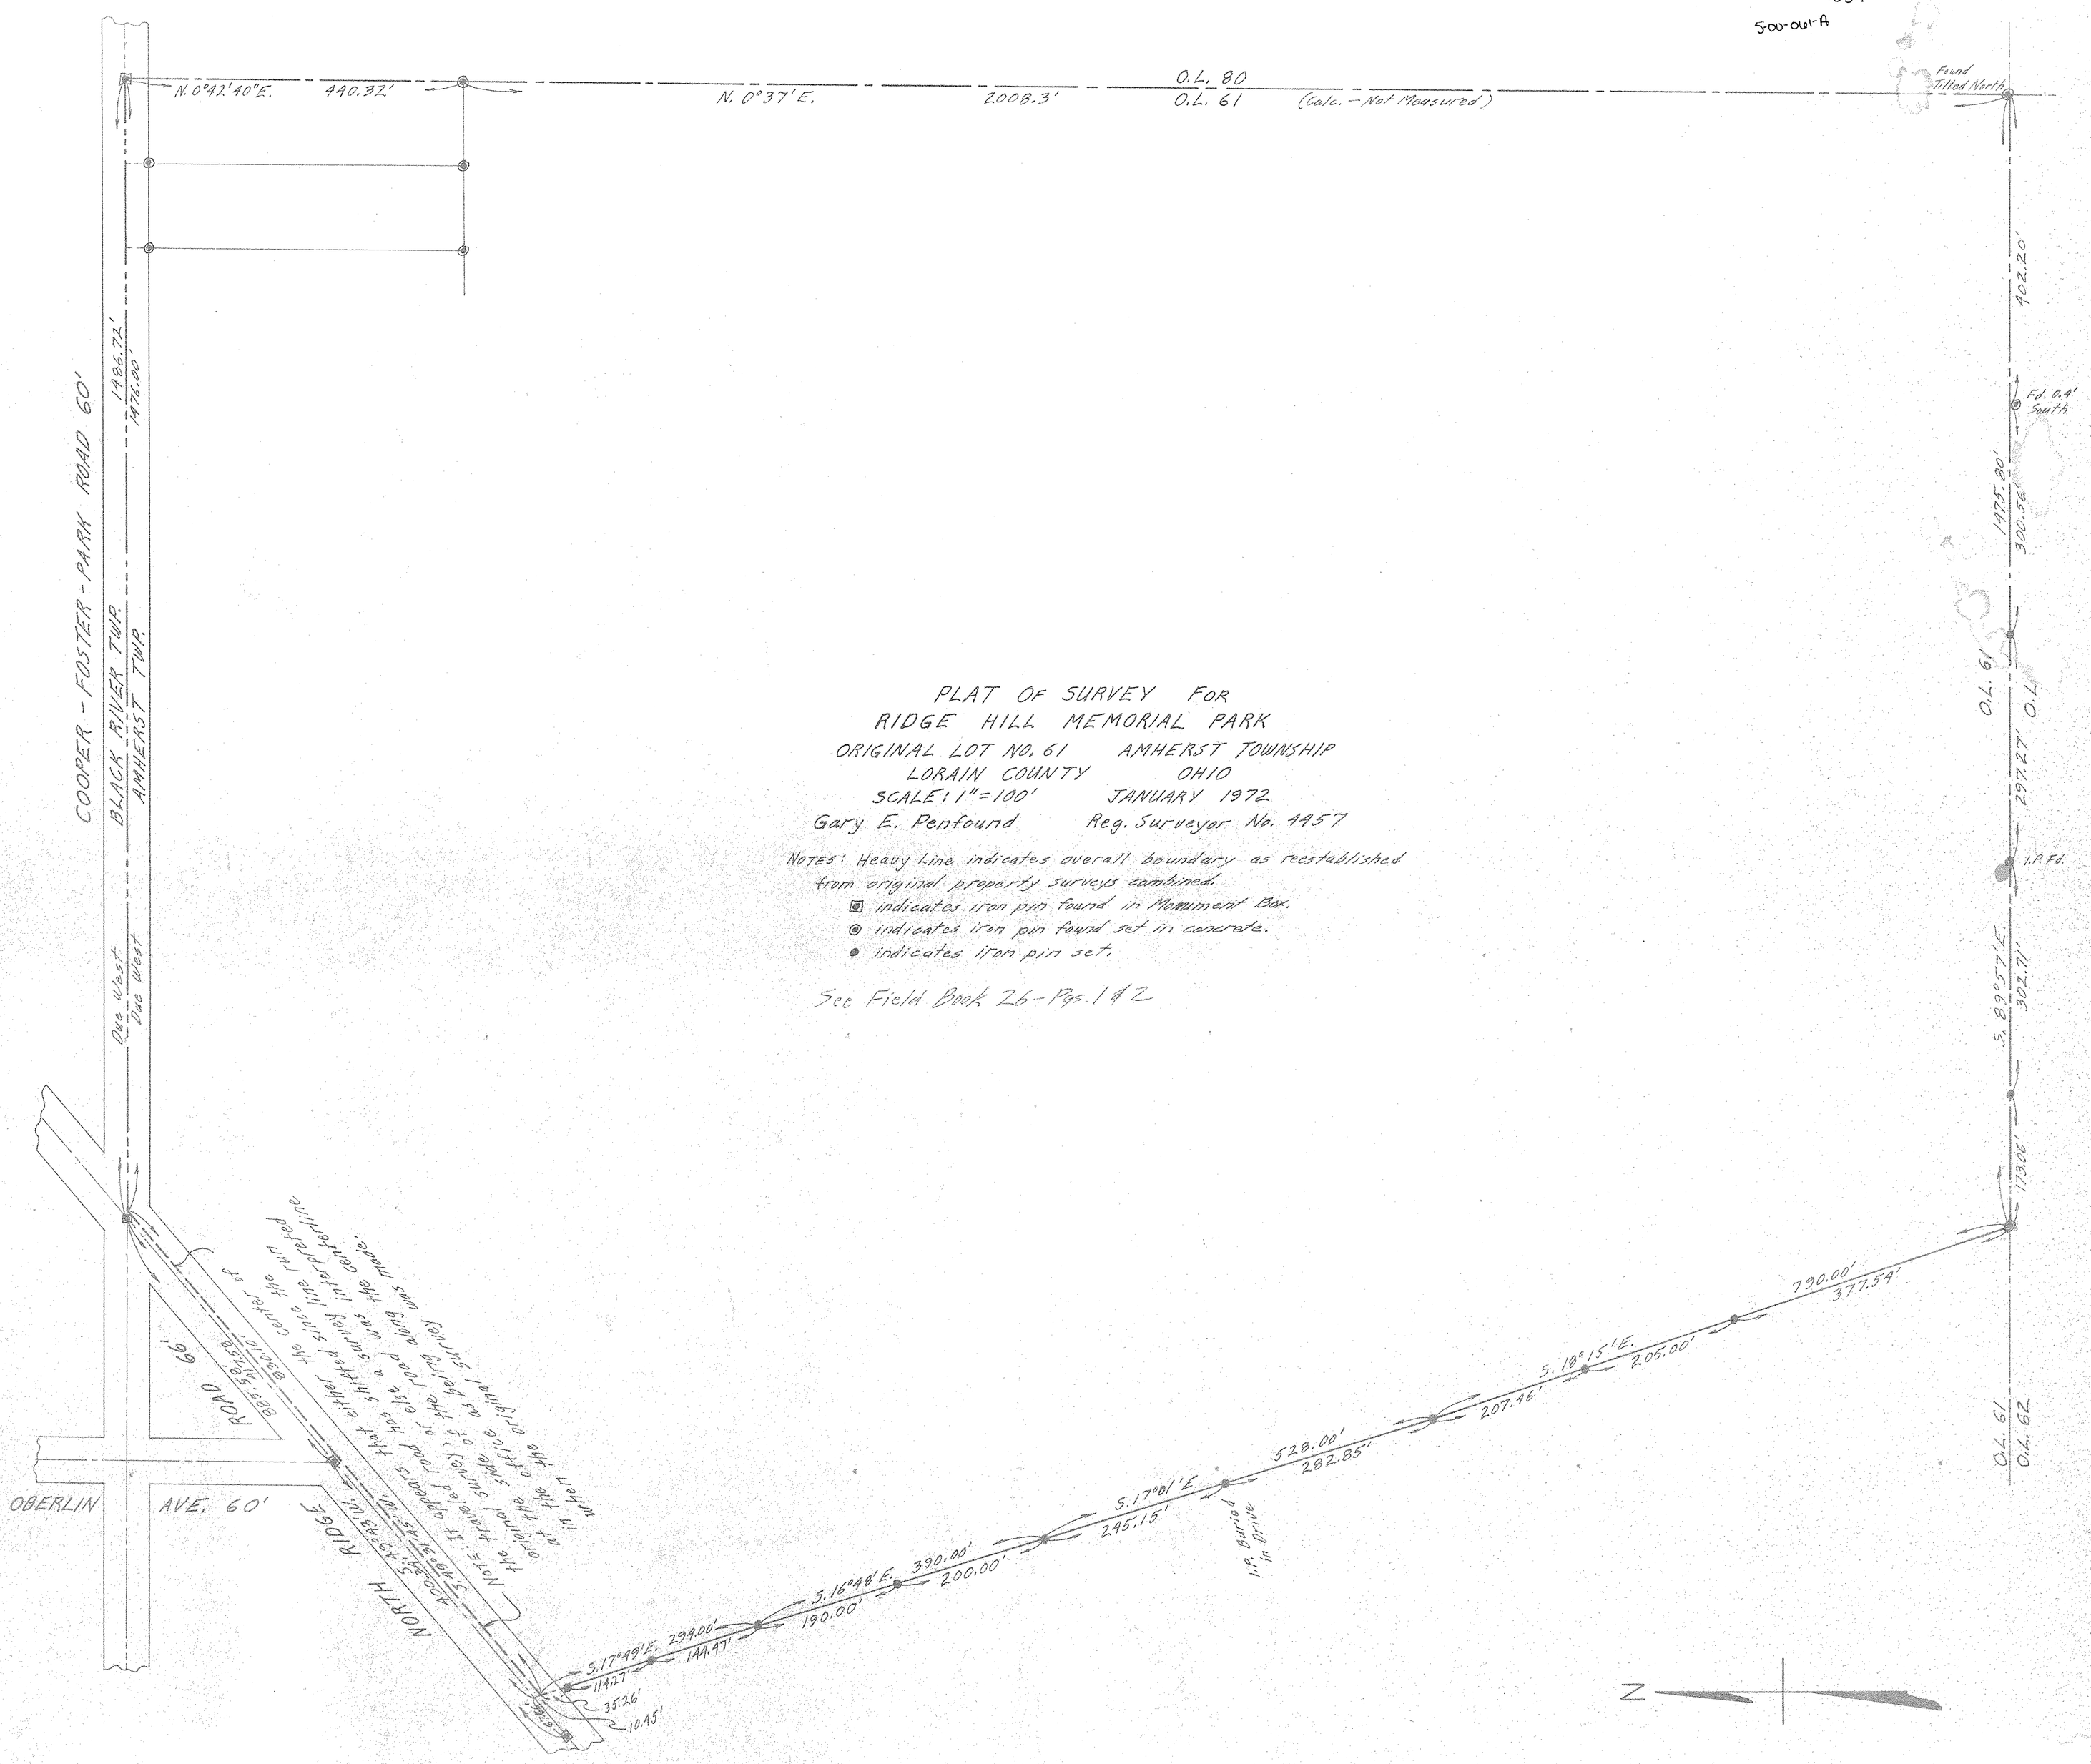

PLAT OF SURVEY FOR
RIDGE HILL MEMORIAL PARK
ORIGINAL LOT NO. 61 AMHERST TOWNSHIP
LORAIN COUNTY OHIO
SCALE: 1" = 100' JANUARY 1972
Gary E. Penfound Reg. Surveyor No. 1457

NOTES: Heavy Line indicates overall boundary as reestablished from original property surveys combined.
▣ indicates iron pin found in Monument Box.
◎ indicates iron pin found set in concrete.
● indicates iron pin set.

See Field Book 26 - Pgs. 1 & 2