



JOHN H. GRITTNER PLAT
P.V. 11 PG. 20

JAMES J. FORRO

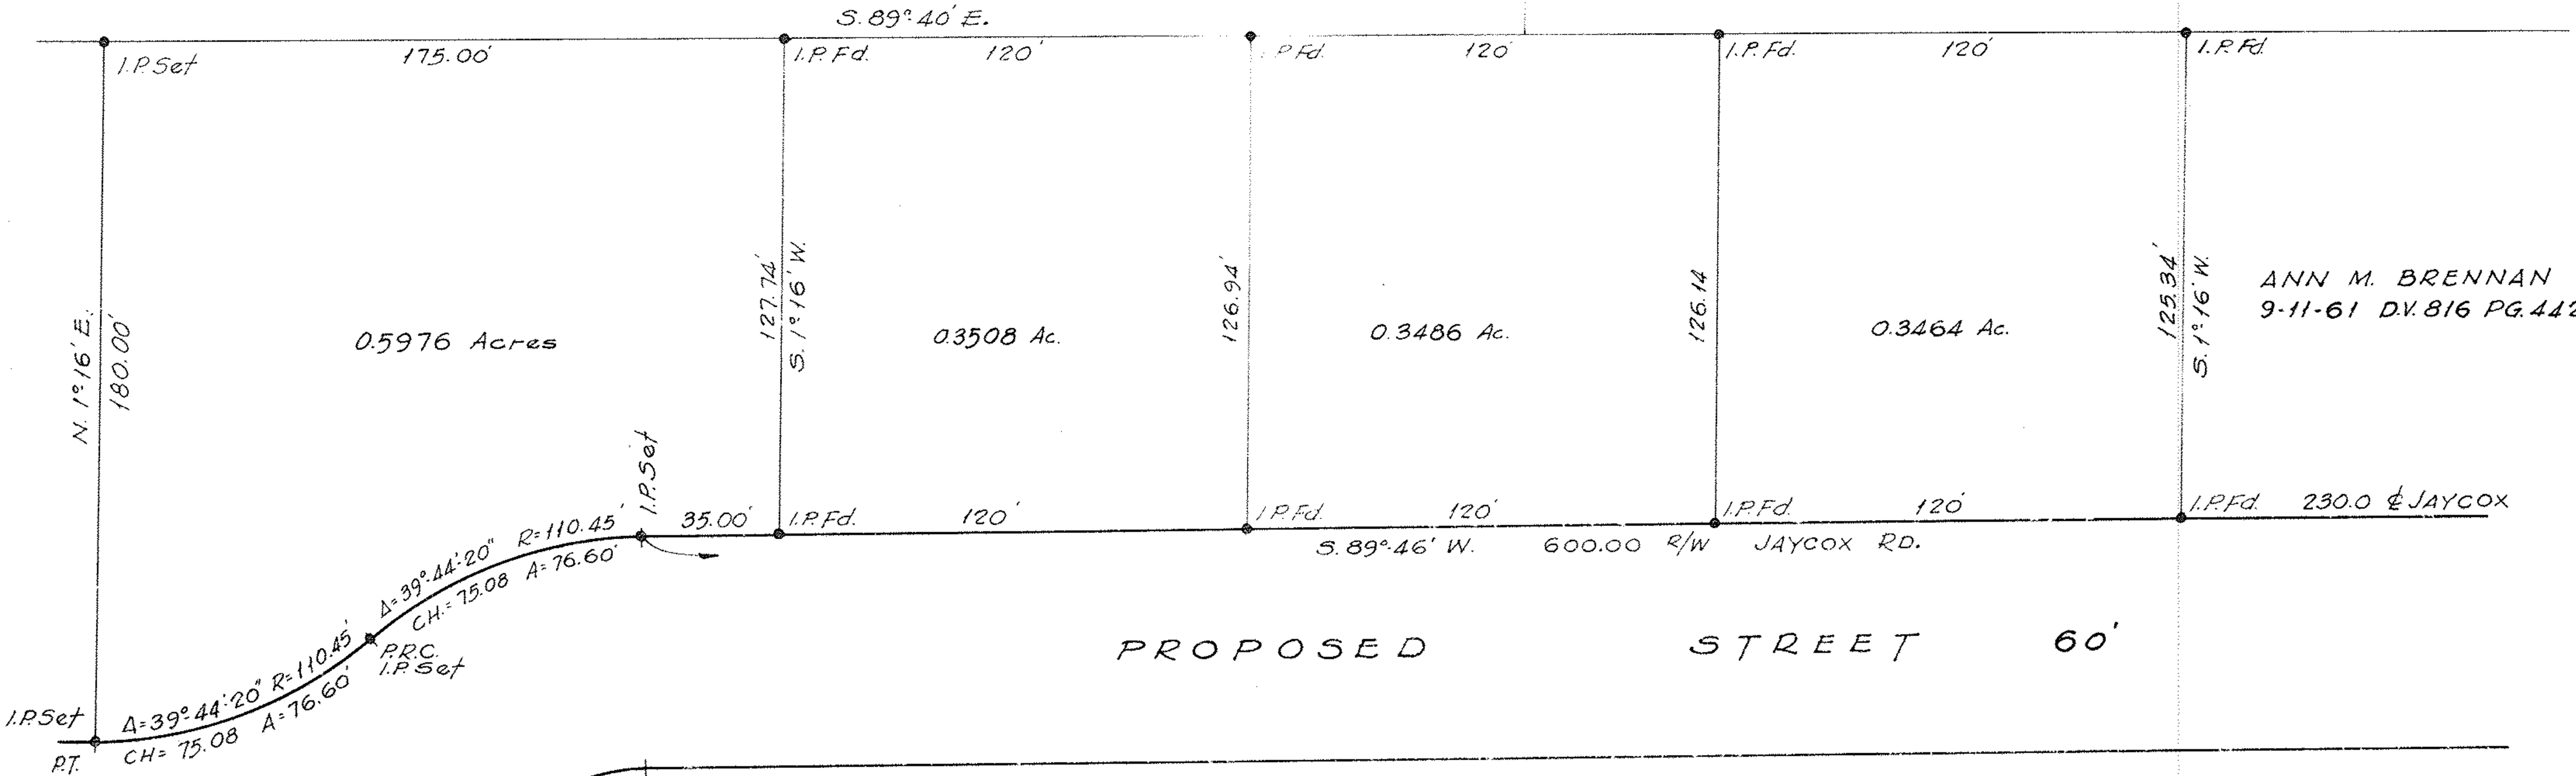

ANN M. BRENNAN
9-11-61 D.V. 816 PG. 442

PROPOSED STREET 60'

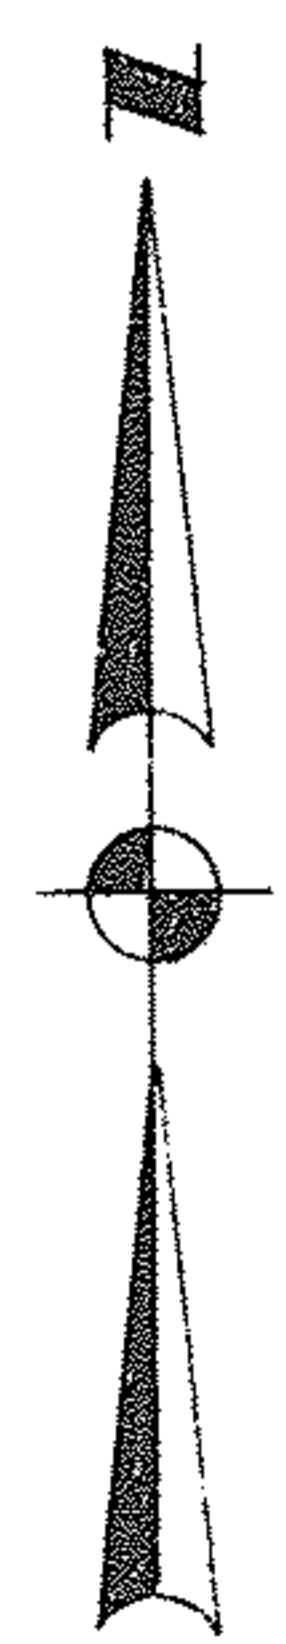

SURVEY FOR
JOSEPH P. & ROSE M. KELLER

PART OF ORIG. SEC. 23 AVON TOWNSHIP
CITY OF AVON - LORAIN COUNTY - OHIO
SCALE 1"=40' FEB., 1974
LAUNDON • SIMON • CAHL AND ASSOC.
ENGINEERS - SURVEYORS

JOB 74-213