


SURVEYOR'S CERTIFICATE:


THIS IS TO CERTIFY THAT I HAVE PERSONALLY EXAMINED THE PREMISES INDICATED ON THIS DRAWING AND HAVE FOUND NO ENCROACHMENTS EITHER ONTO OR FROM THE SUBJECT PROPERTY, AND THAT ALL BUILDINGS AND STRUCTURES LIE WITHIN THE PRESCRIBED LIMITS OF THE ZONING REGULATIONS AND CODIFIED ORDINANCES OF THE CITY OF AVON LAKE, OHIO

Michael G. Hura
 MICHAEL G. HURA
 REGISTERED SURVEYOR

DATED: 1-30-72

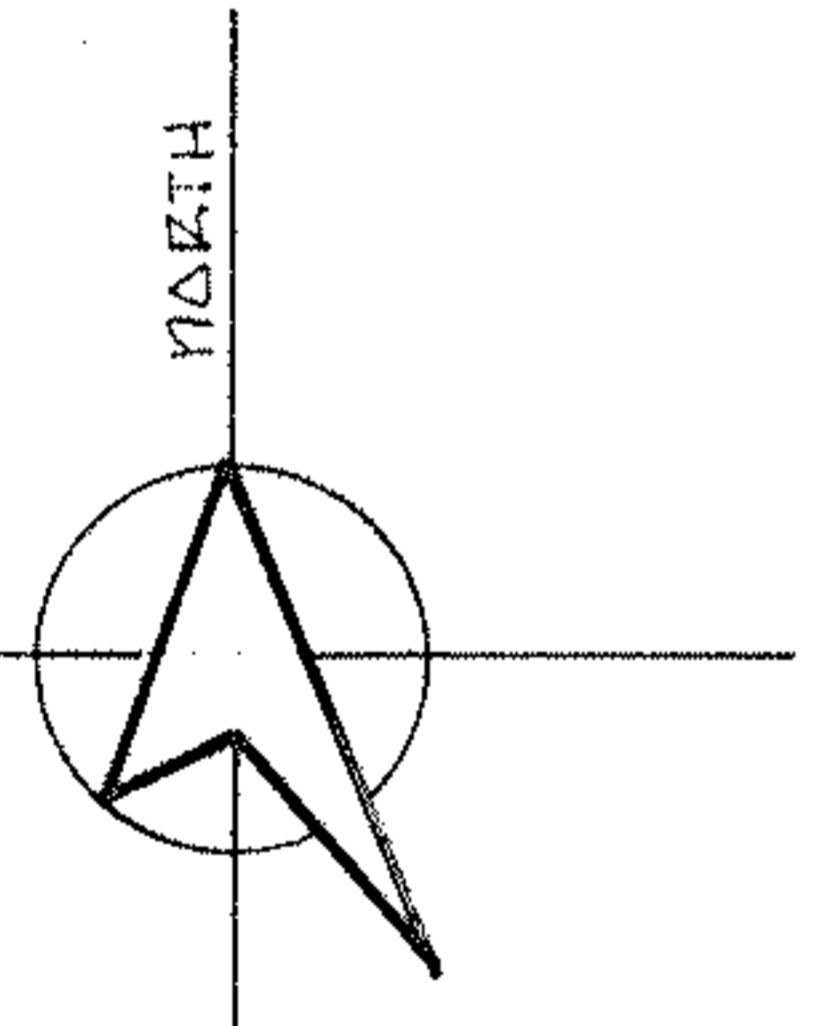

IDENTIFICATION SURVEY:
 MADE FOR AND AT THE INSTANCE OF
 JOHN HANCOCK MUTUAL LIFE INSURANCE CO.,
 THE MEADOWS, INC., AND
 TITLE SECURITY CORPORATION
 7.69 - ACRE PARCEL OF LAND
 PART OF AVON TOWNSHIP SECTION 6,
 LORAIN COUNTY, OHIO
 NOW CITY OF AVON LAKE, OHIO
 STREET ADDRESS 216 MOORE ROAD
 JANUARY 30 1972 - SCALE 1" = 60'

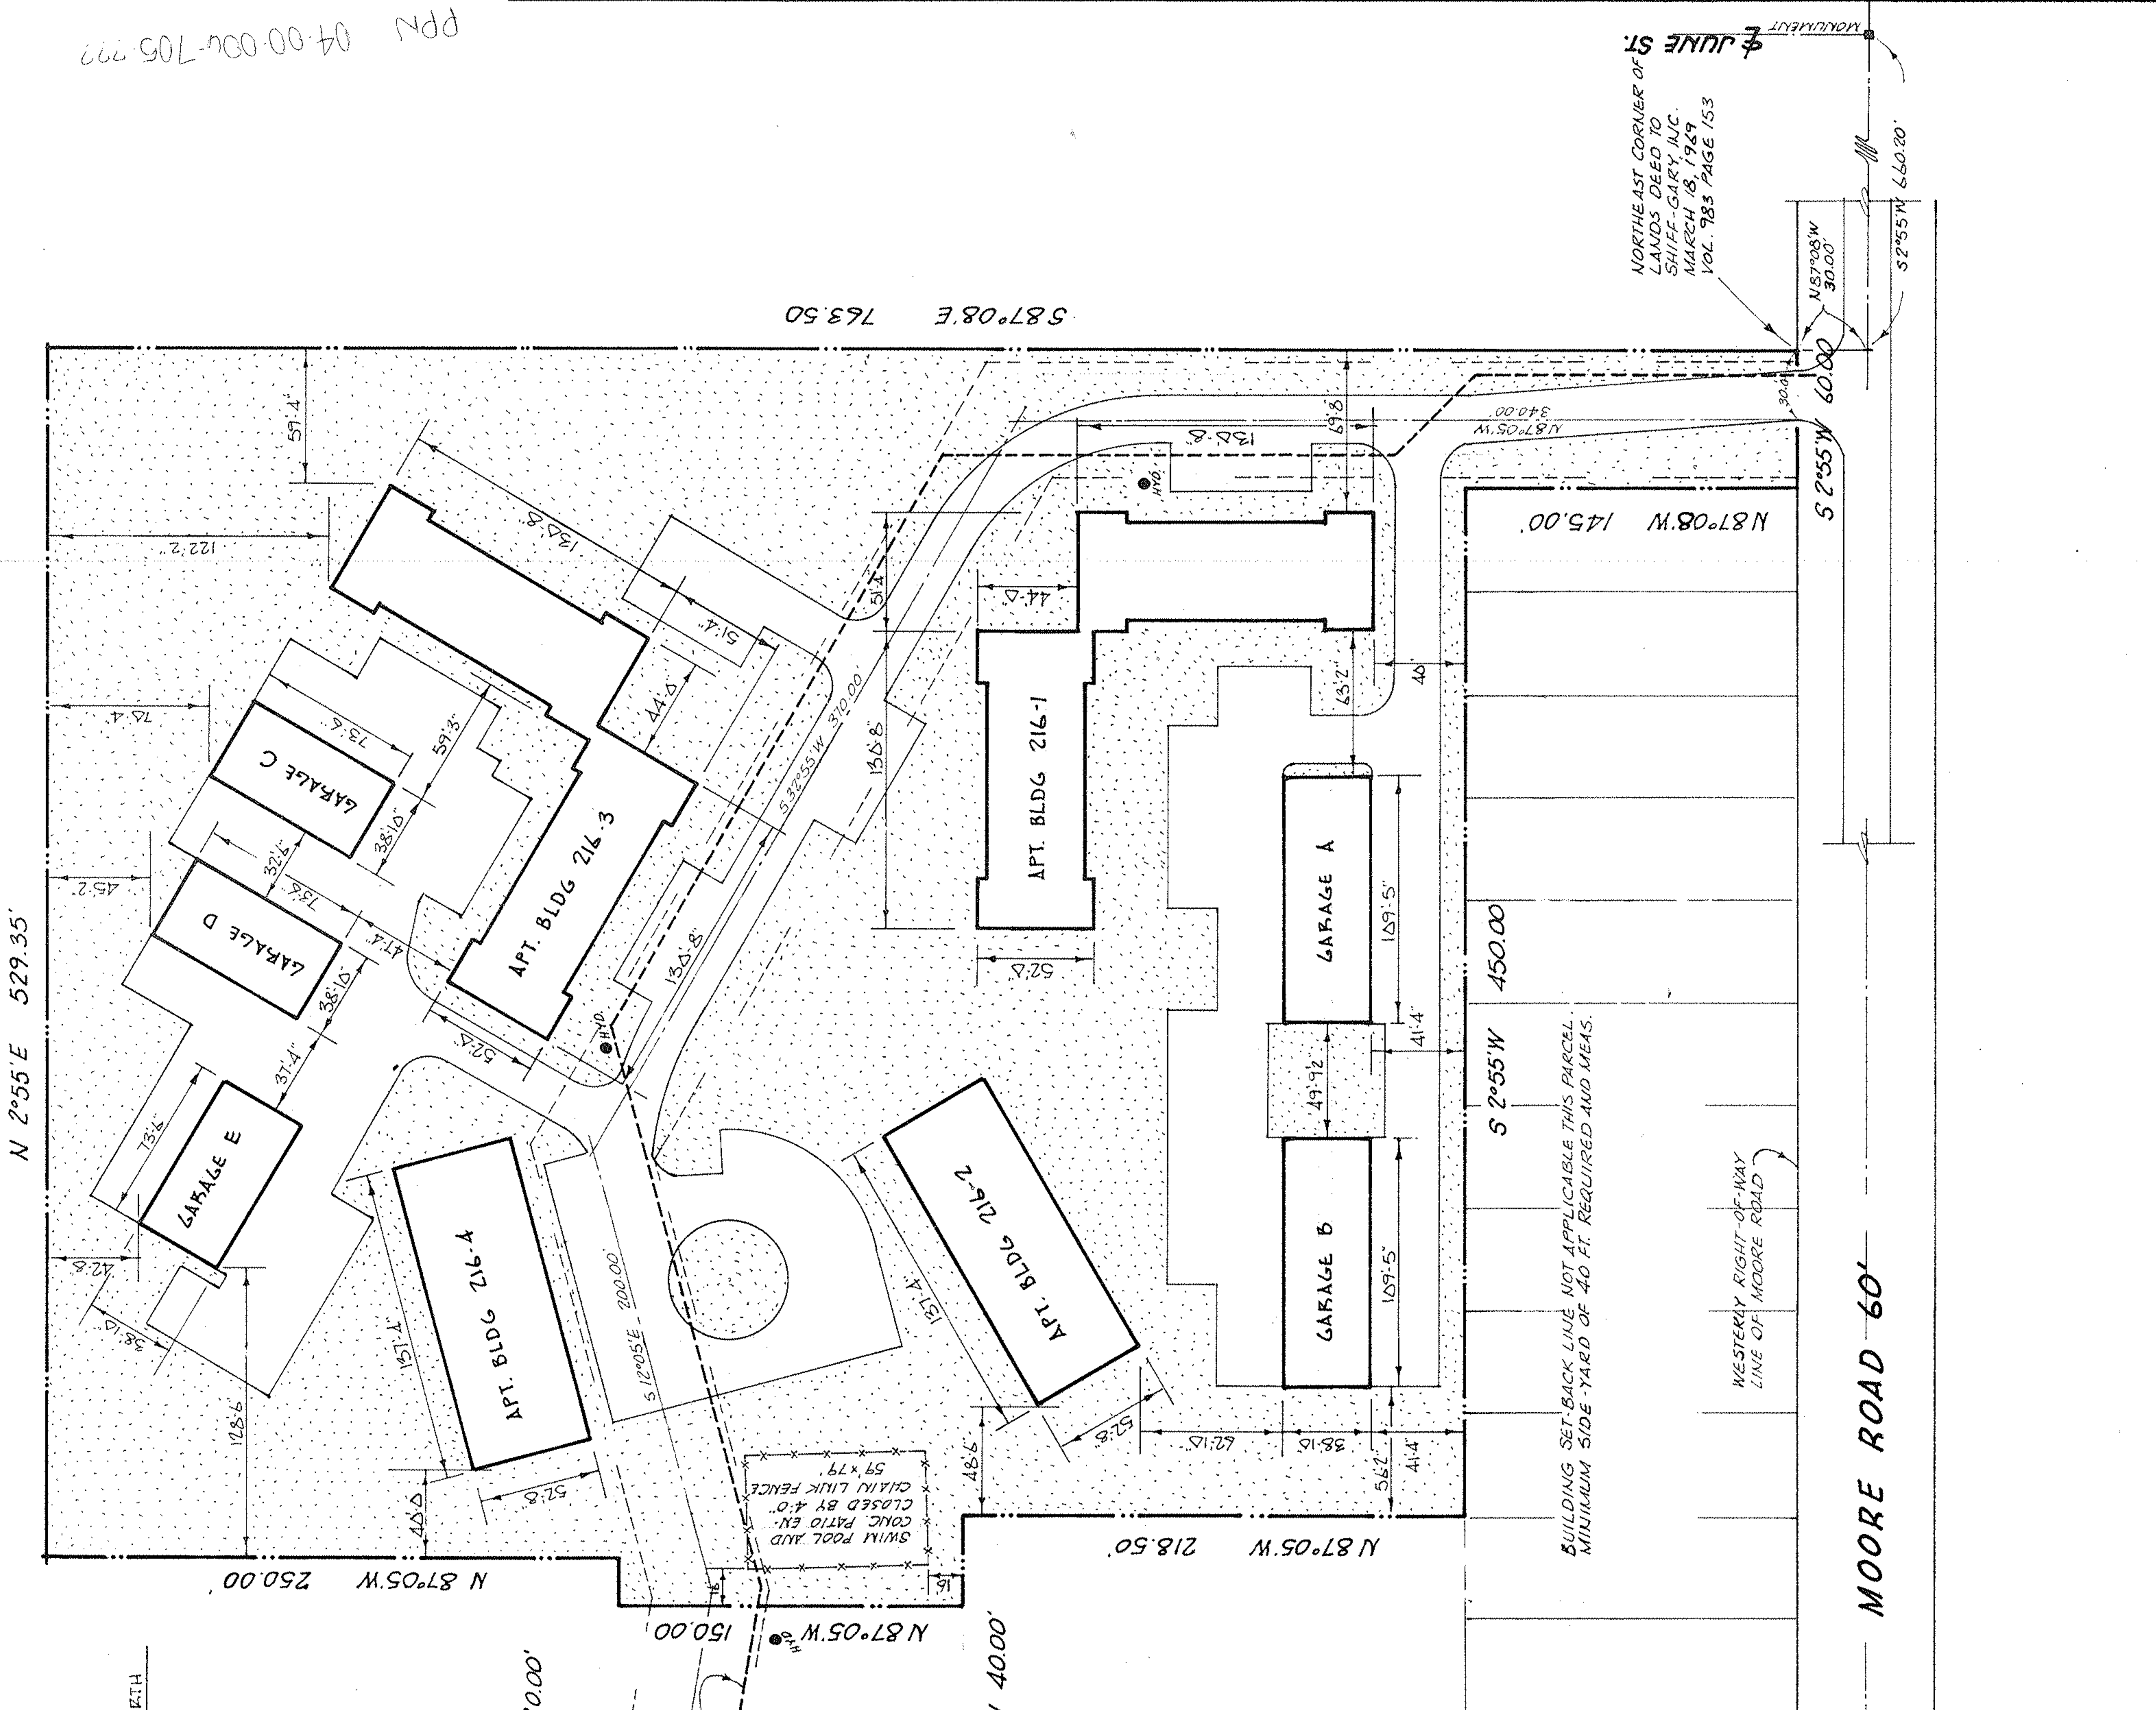

PPN 04-00-006-705 222
 MP 04-00-006-705 HI
 43389