03-00-109-124-018
3-00-109-B

PPN 03-00-109-124-018

MAP PG 3-00-109-B

43393

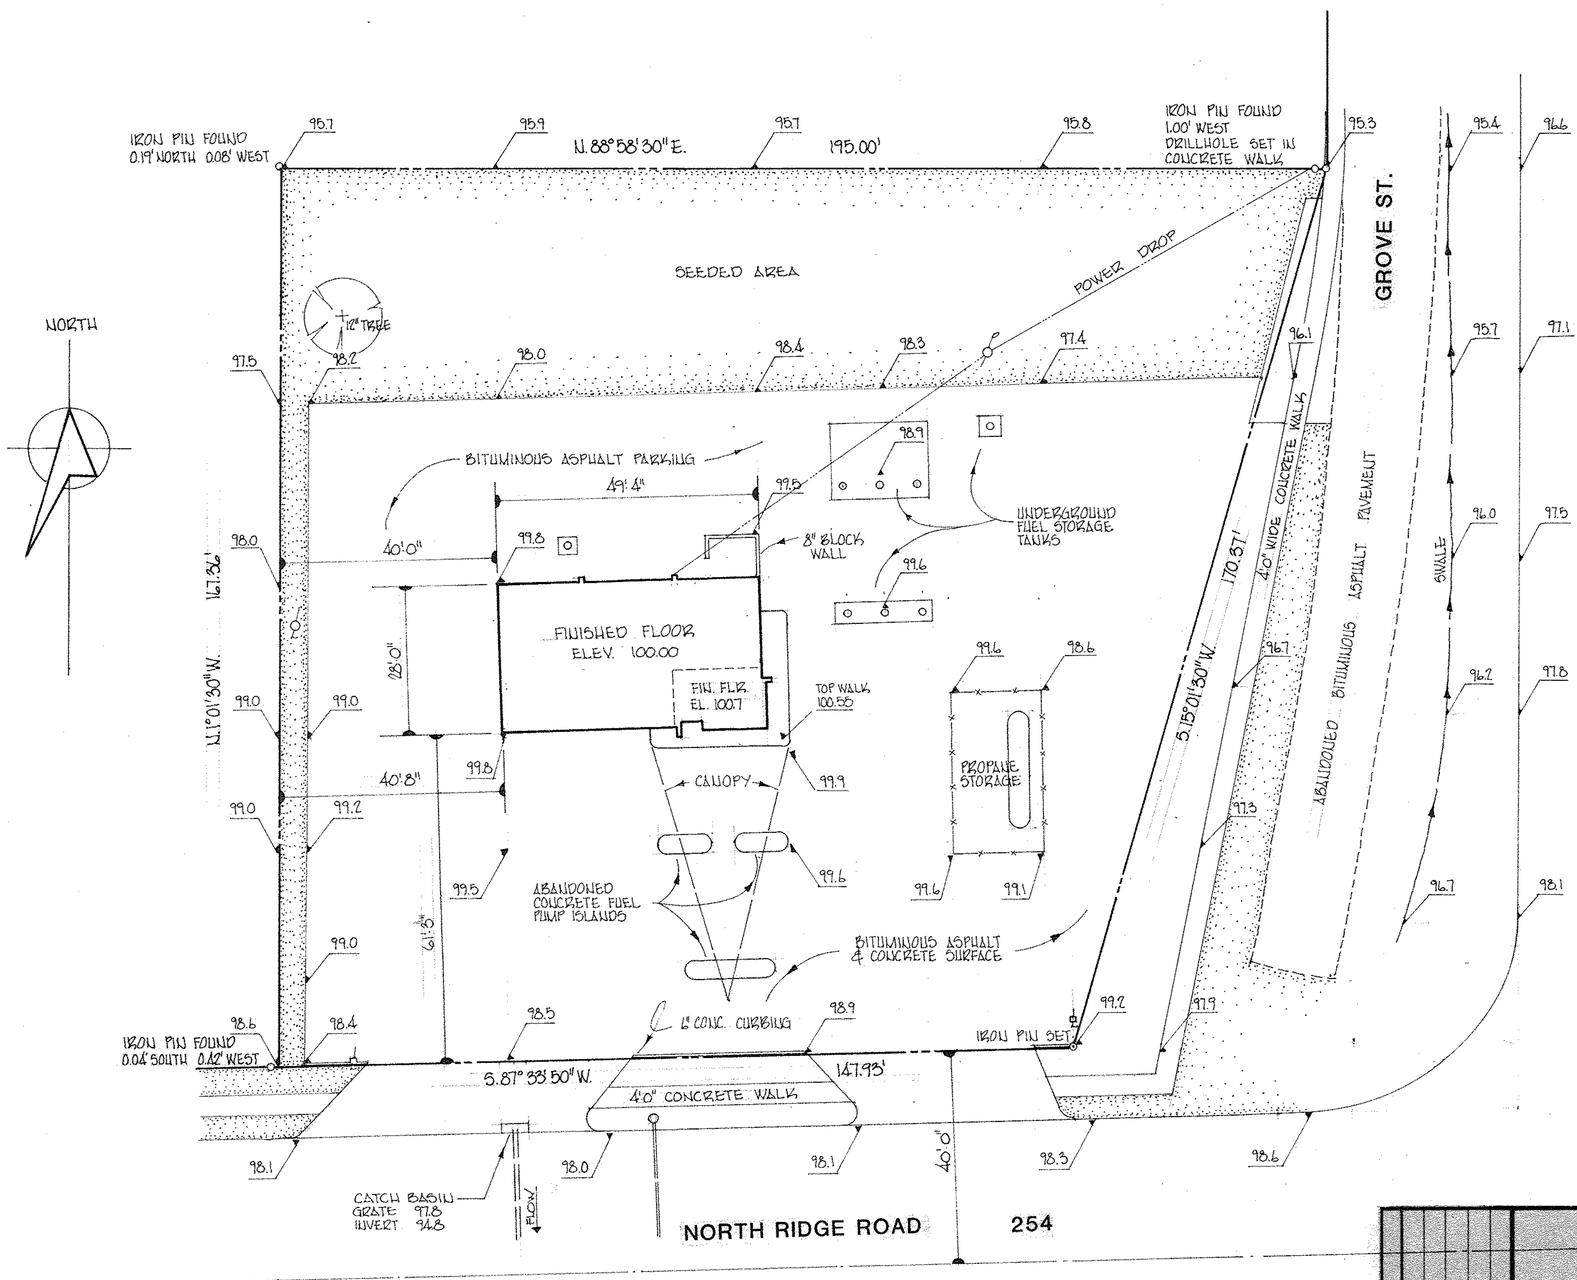

SCALE 1" = 20'

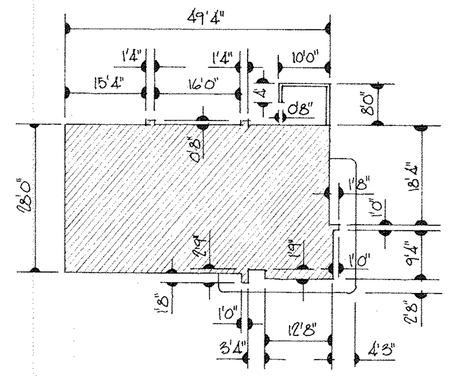

BUILDING DIMENSIONS
SCALE 1" = 20'

NOTES

- BENCH MARK: FINISHED FLOOR OF EXISTING BUILDING ELEVATION 100.00 ASSUMED DATUM
- THE INFORMATION SHOWN HEREON WAS OBTAINED ON NOVEMBER 18, 1980.

STATE OF OHIO
PHILLIP A. ROSEBECK
No. 6695
REGISTERED SURVEYOR

Michael G. Hura and Associates
3409 LIBERTY AVENUE, VERMILION, OHIO 44089
A DIVISION OF NATIONAL SURVEY SERVICES, INC.

PREPARED FOR OSBORNE BROTHERS WELDING SUPPLY

PERIMETER SURVEY & TOPOGRAPHY

PARTS OF SUBLOTS 1, 2, 3 & 4 OF RIDGELAND ALLOTMENT, ORIGINAL SHEFFIELD TOWNSHIP LOT 109, LORAIN COUNTY, OHIO.

REVISIONS DATE - AREA
1
2
3
4
5

REFERENCE DRAWINGS

DATE 12-24-80
DRAWN FDR
SCALE NOTED

DRAWING NUMBER

sheet no. 1 of 1