
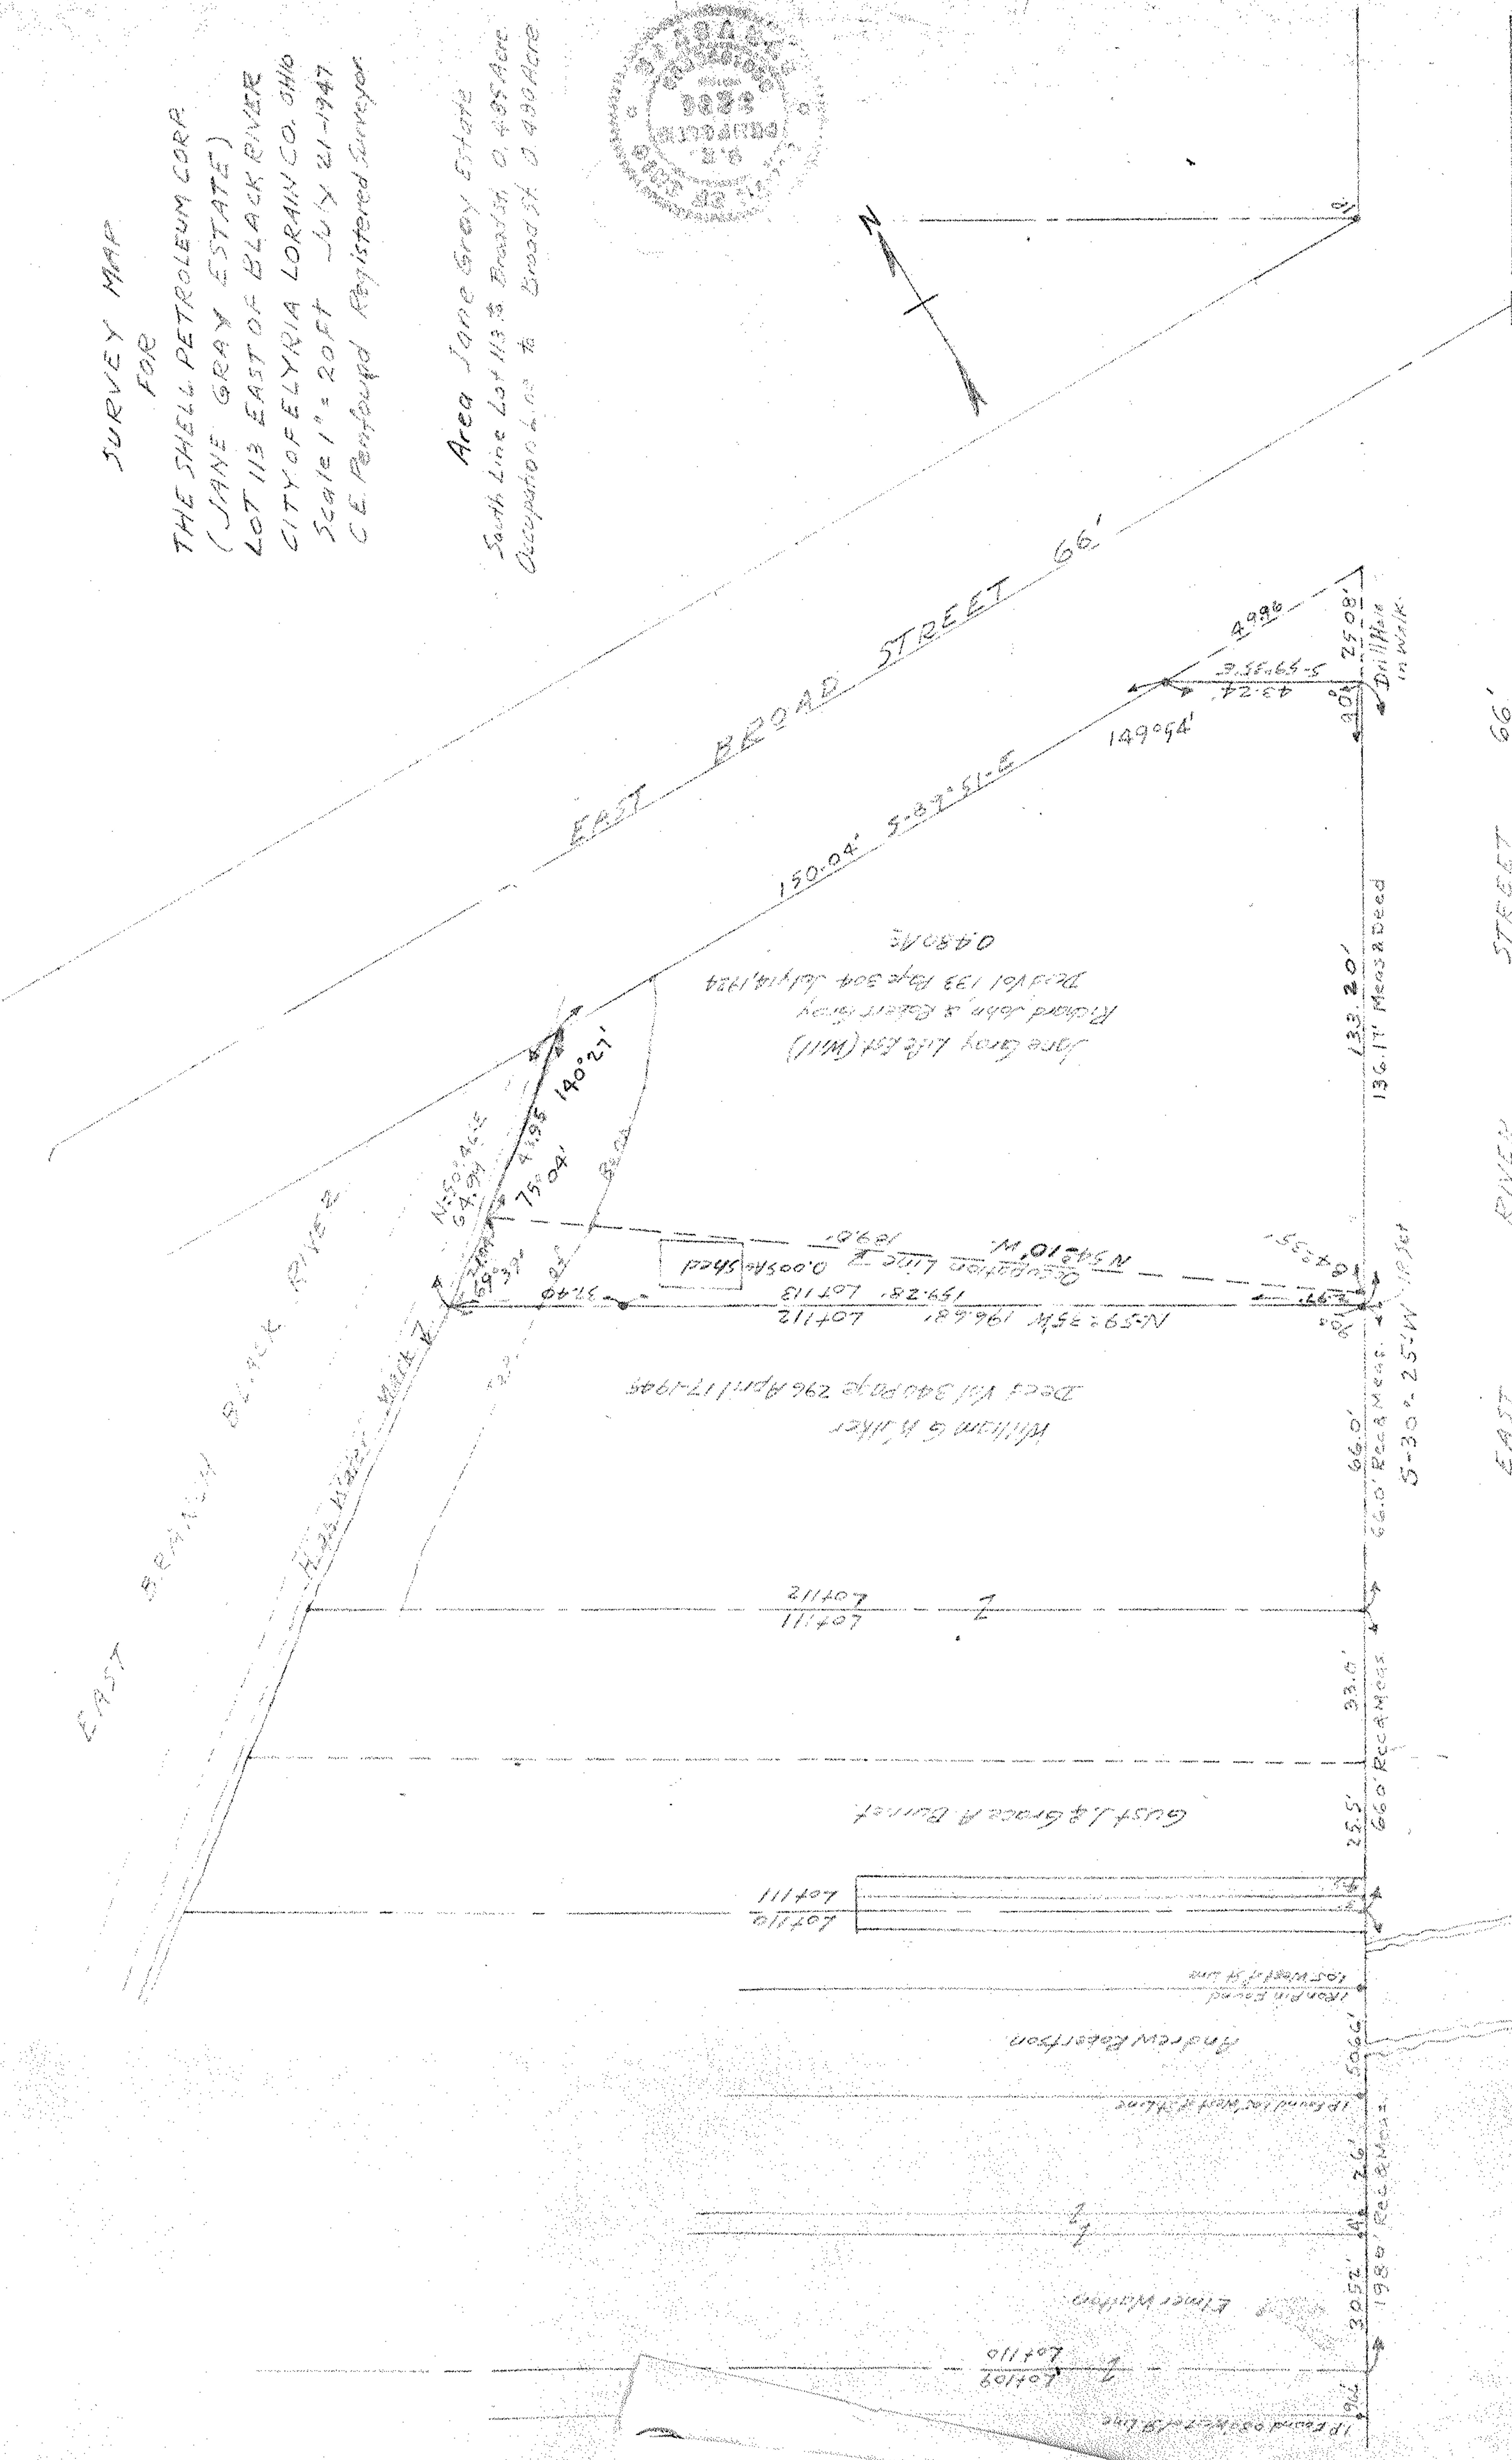


**SURVEY MAP
FOR**

THE SHELL PETROLEUM CORP.
(JANE GRAY ESTATE)
LOT 113 EAST OF BLACK RIVER
CITY OF ELYRIA LORAIN CO. OHIO
Scale 1" = 20 FT JULY 21-1947
C.E. Penfound Registered Surveyor

Area Jane Gray Estate
South Line Lot 113 & Broad St. 0.485 Acre
Occupation Line to Broad St. 0.480 Acre

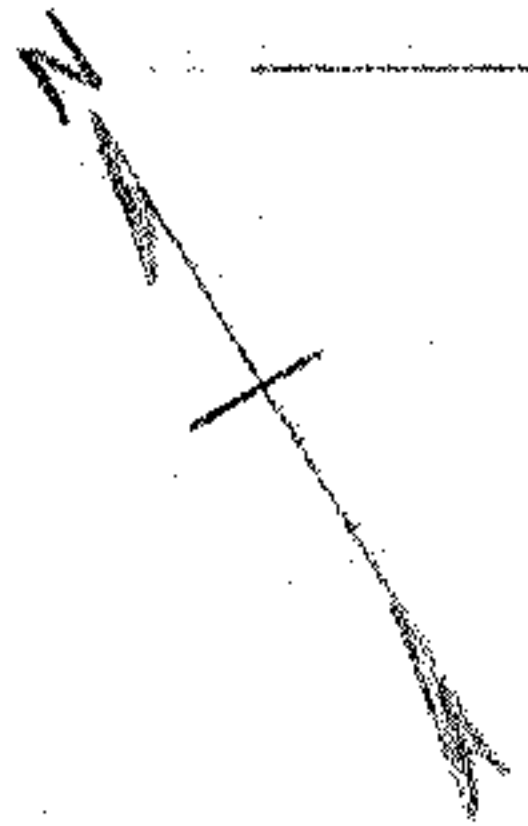

069-25-113-000-002
069-25-112-000-001
MAP PG: 69-121