PLAT OF TOPOGRAPHIC SURVEY FOR STATE OF OHIO DEPARTMENT OF PUBLIC WORKS BUREAU OF UNEMPLOYMENT COMPENSATION OFFICE BUILDING SITE

ELYRIA CITY LORAIN COUNTY OHIO

SCALE: 3/32" = 1'-0" APRIL 1963

GARY E. PENFOUND REG. SURVEYOR NO. 4457

Alternate Bench Mark
Arrow on hydrant at
SE corner Middle Avenue
& Fifth St. Alley
Elevation 734.17

NOTES AND SYMBOLS

Elevations are based on U.S.G.S. Monument on North side of Lincoln. Datum is Mean Sea Level.

Contour Interval is One half Foot.

7.0 Indicates percent of grade and direction of flow.

G denotes outside location of Gas house service valve.

W denotes outside location of Water house service valve.

Elevations of manholes and catch basins determined by field measurements. All elevations of manhole rims and catch basin grates, and all pipe invert elevations within manholes and catch basins, were determined by field observations.

Locations of house sanitary sewer taps were obtained from Elyria City Engineer's Department records.
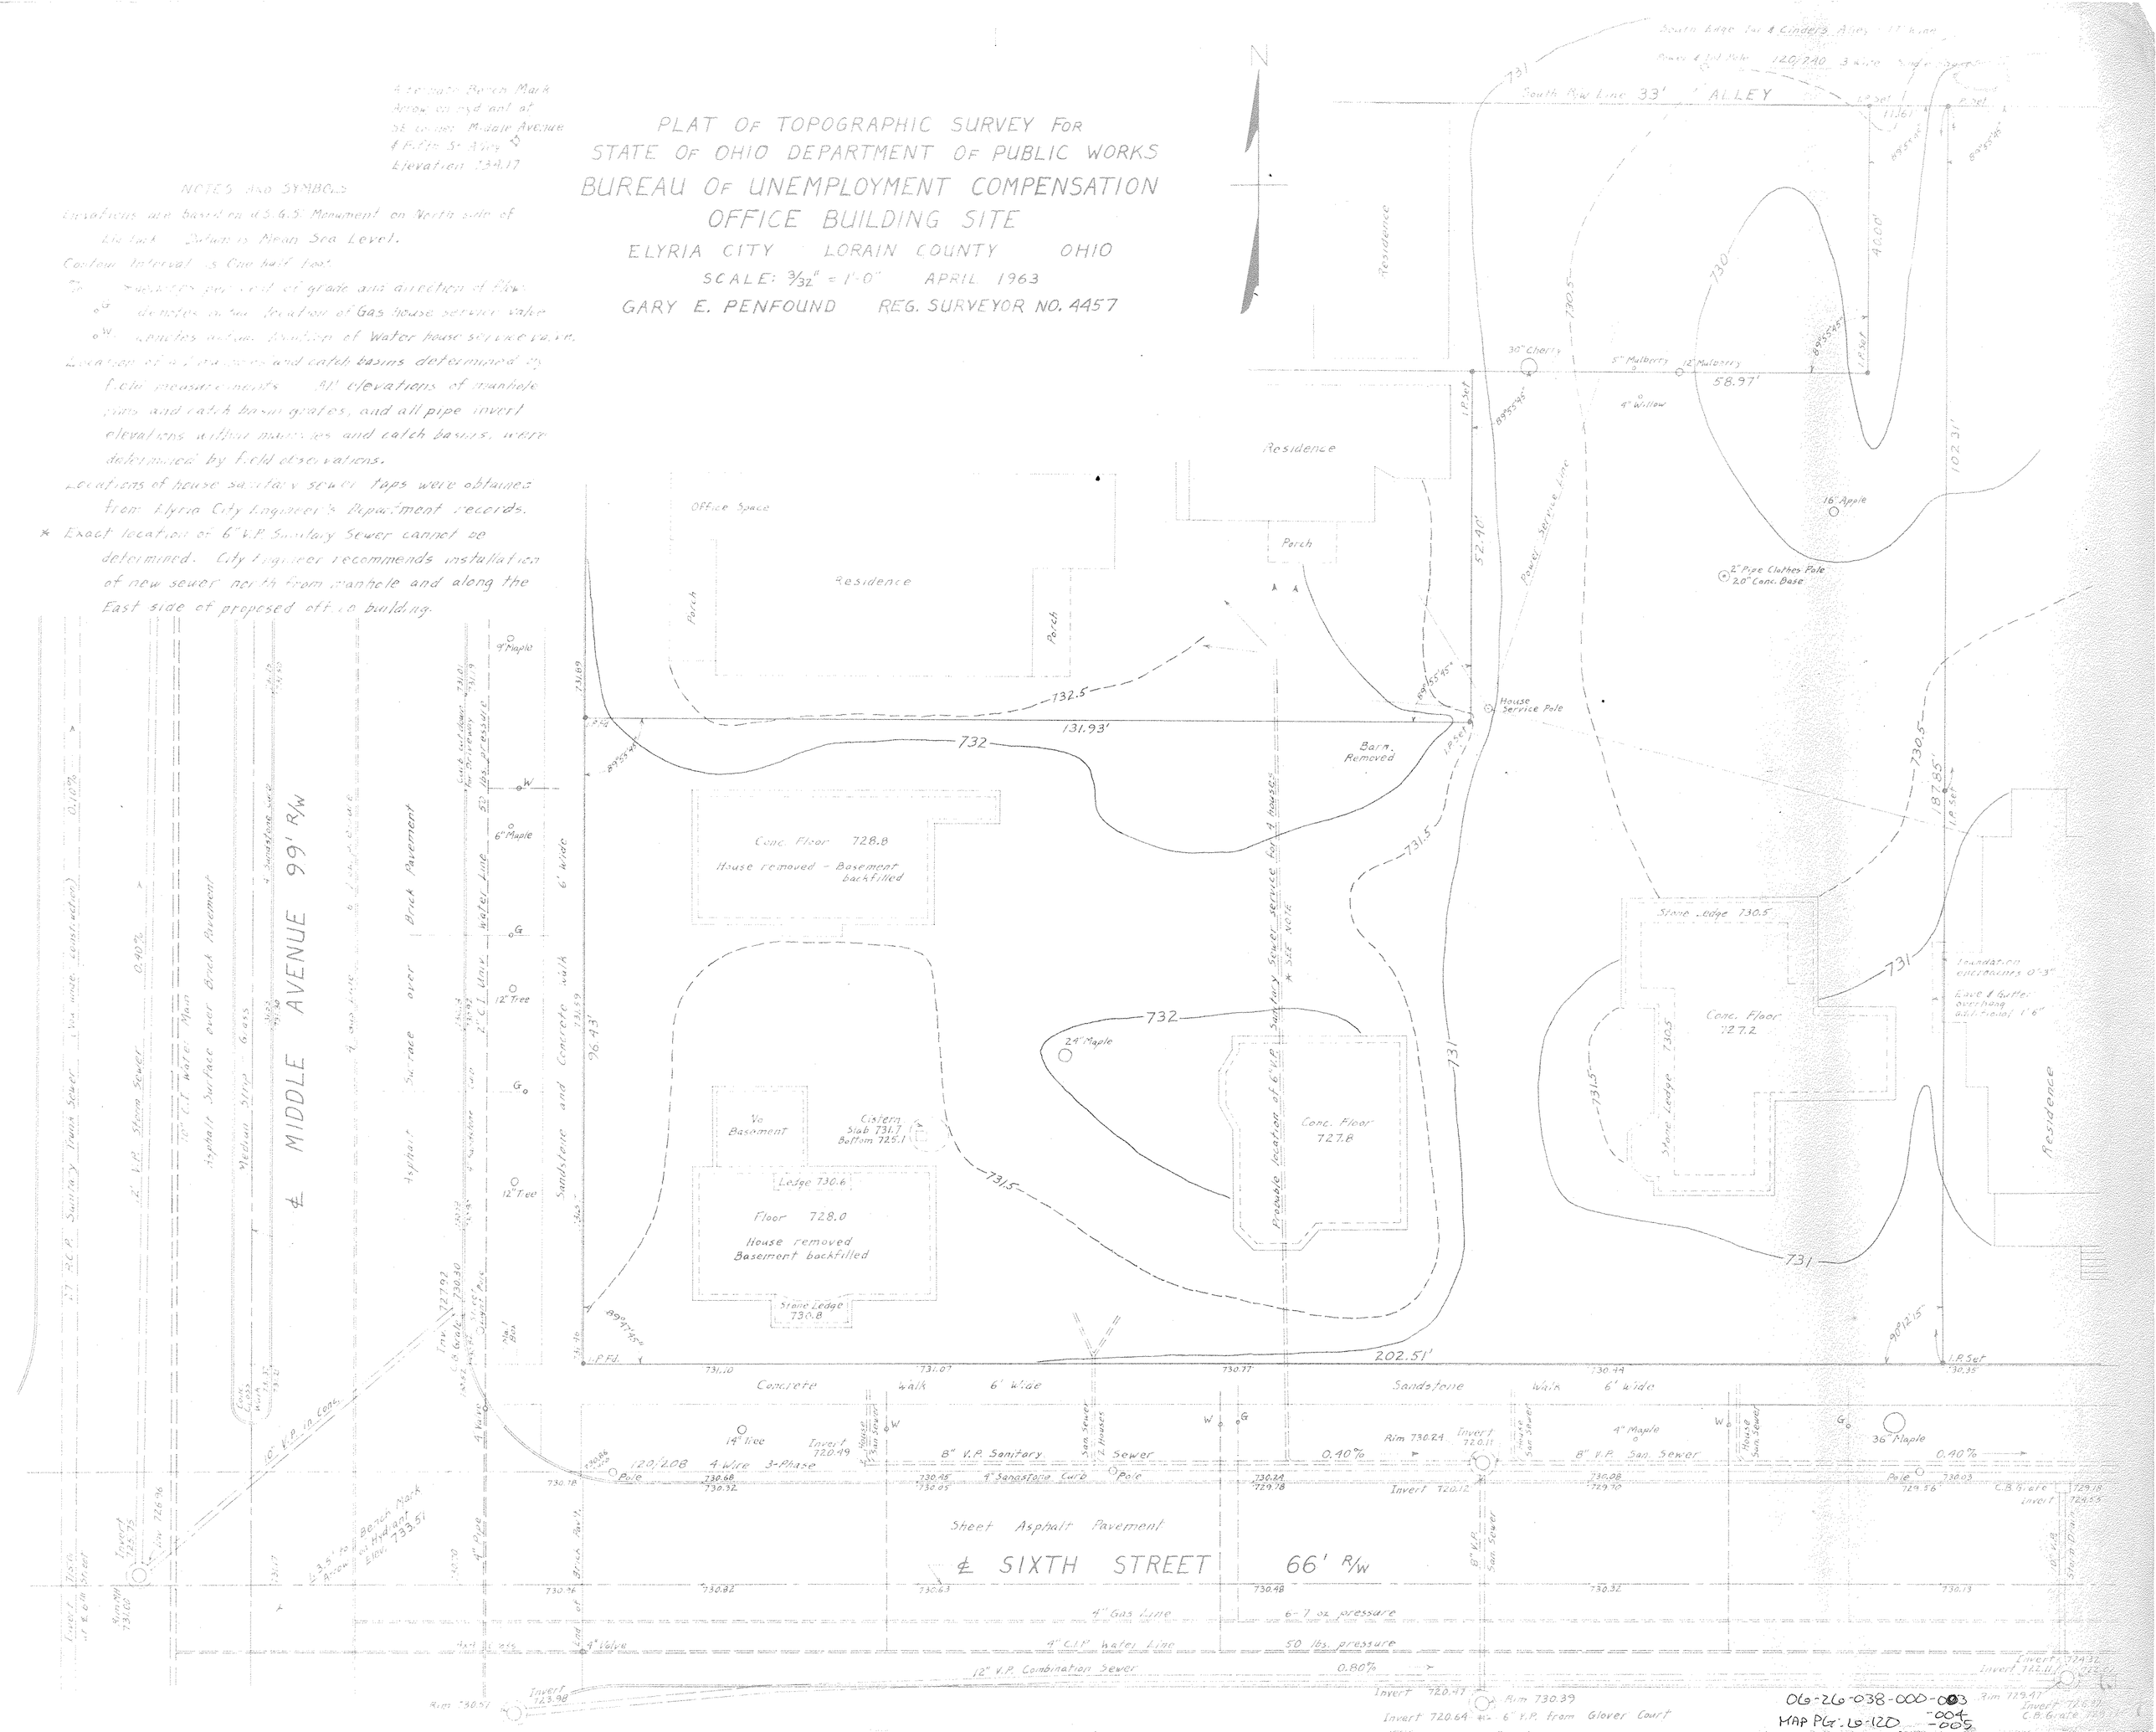
* Exact location of 6" V.P. Sanitary Sewer cannot be determined. City Engineer recommends installation of new sewer north from manhole and along the East side of proposed office building.