PLAT OF SURVEY FOR
HAROLD H. WESEBAUM

PARTS OF ORIGINAL LOT NO. 54 AND UNALLOTTED LAND - EAST OF BLACK RIVER - ELYRIA TOWNSHIP
ELYRIA CITY LORAIN COUNTY OHIO

SCALE: 1" = 20' SEPTEMBER 1965

Gary E. Penfound Registered Surveyor No. 4457

See Field Book 21 - Page 61

NOTE: Measurements on 12 Car Garage taken to and along main wooden frame. Corrugated Sheeting extends about one inch beyond frame.

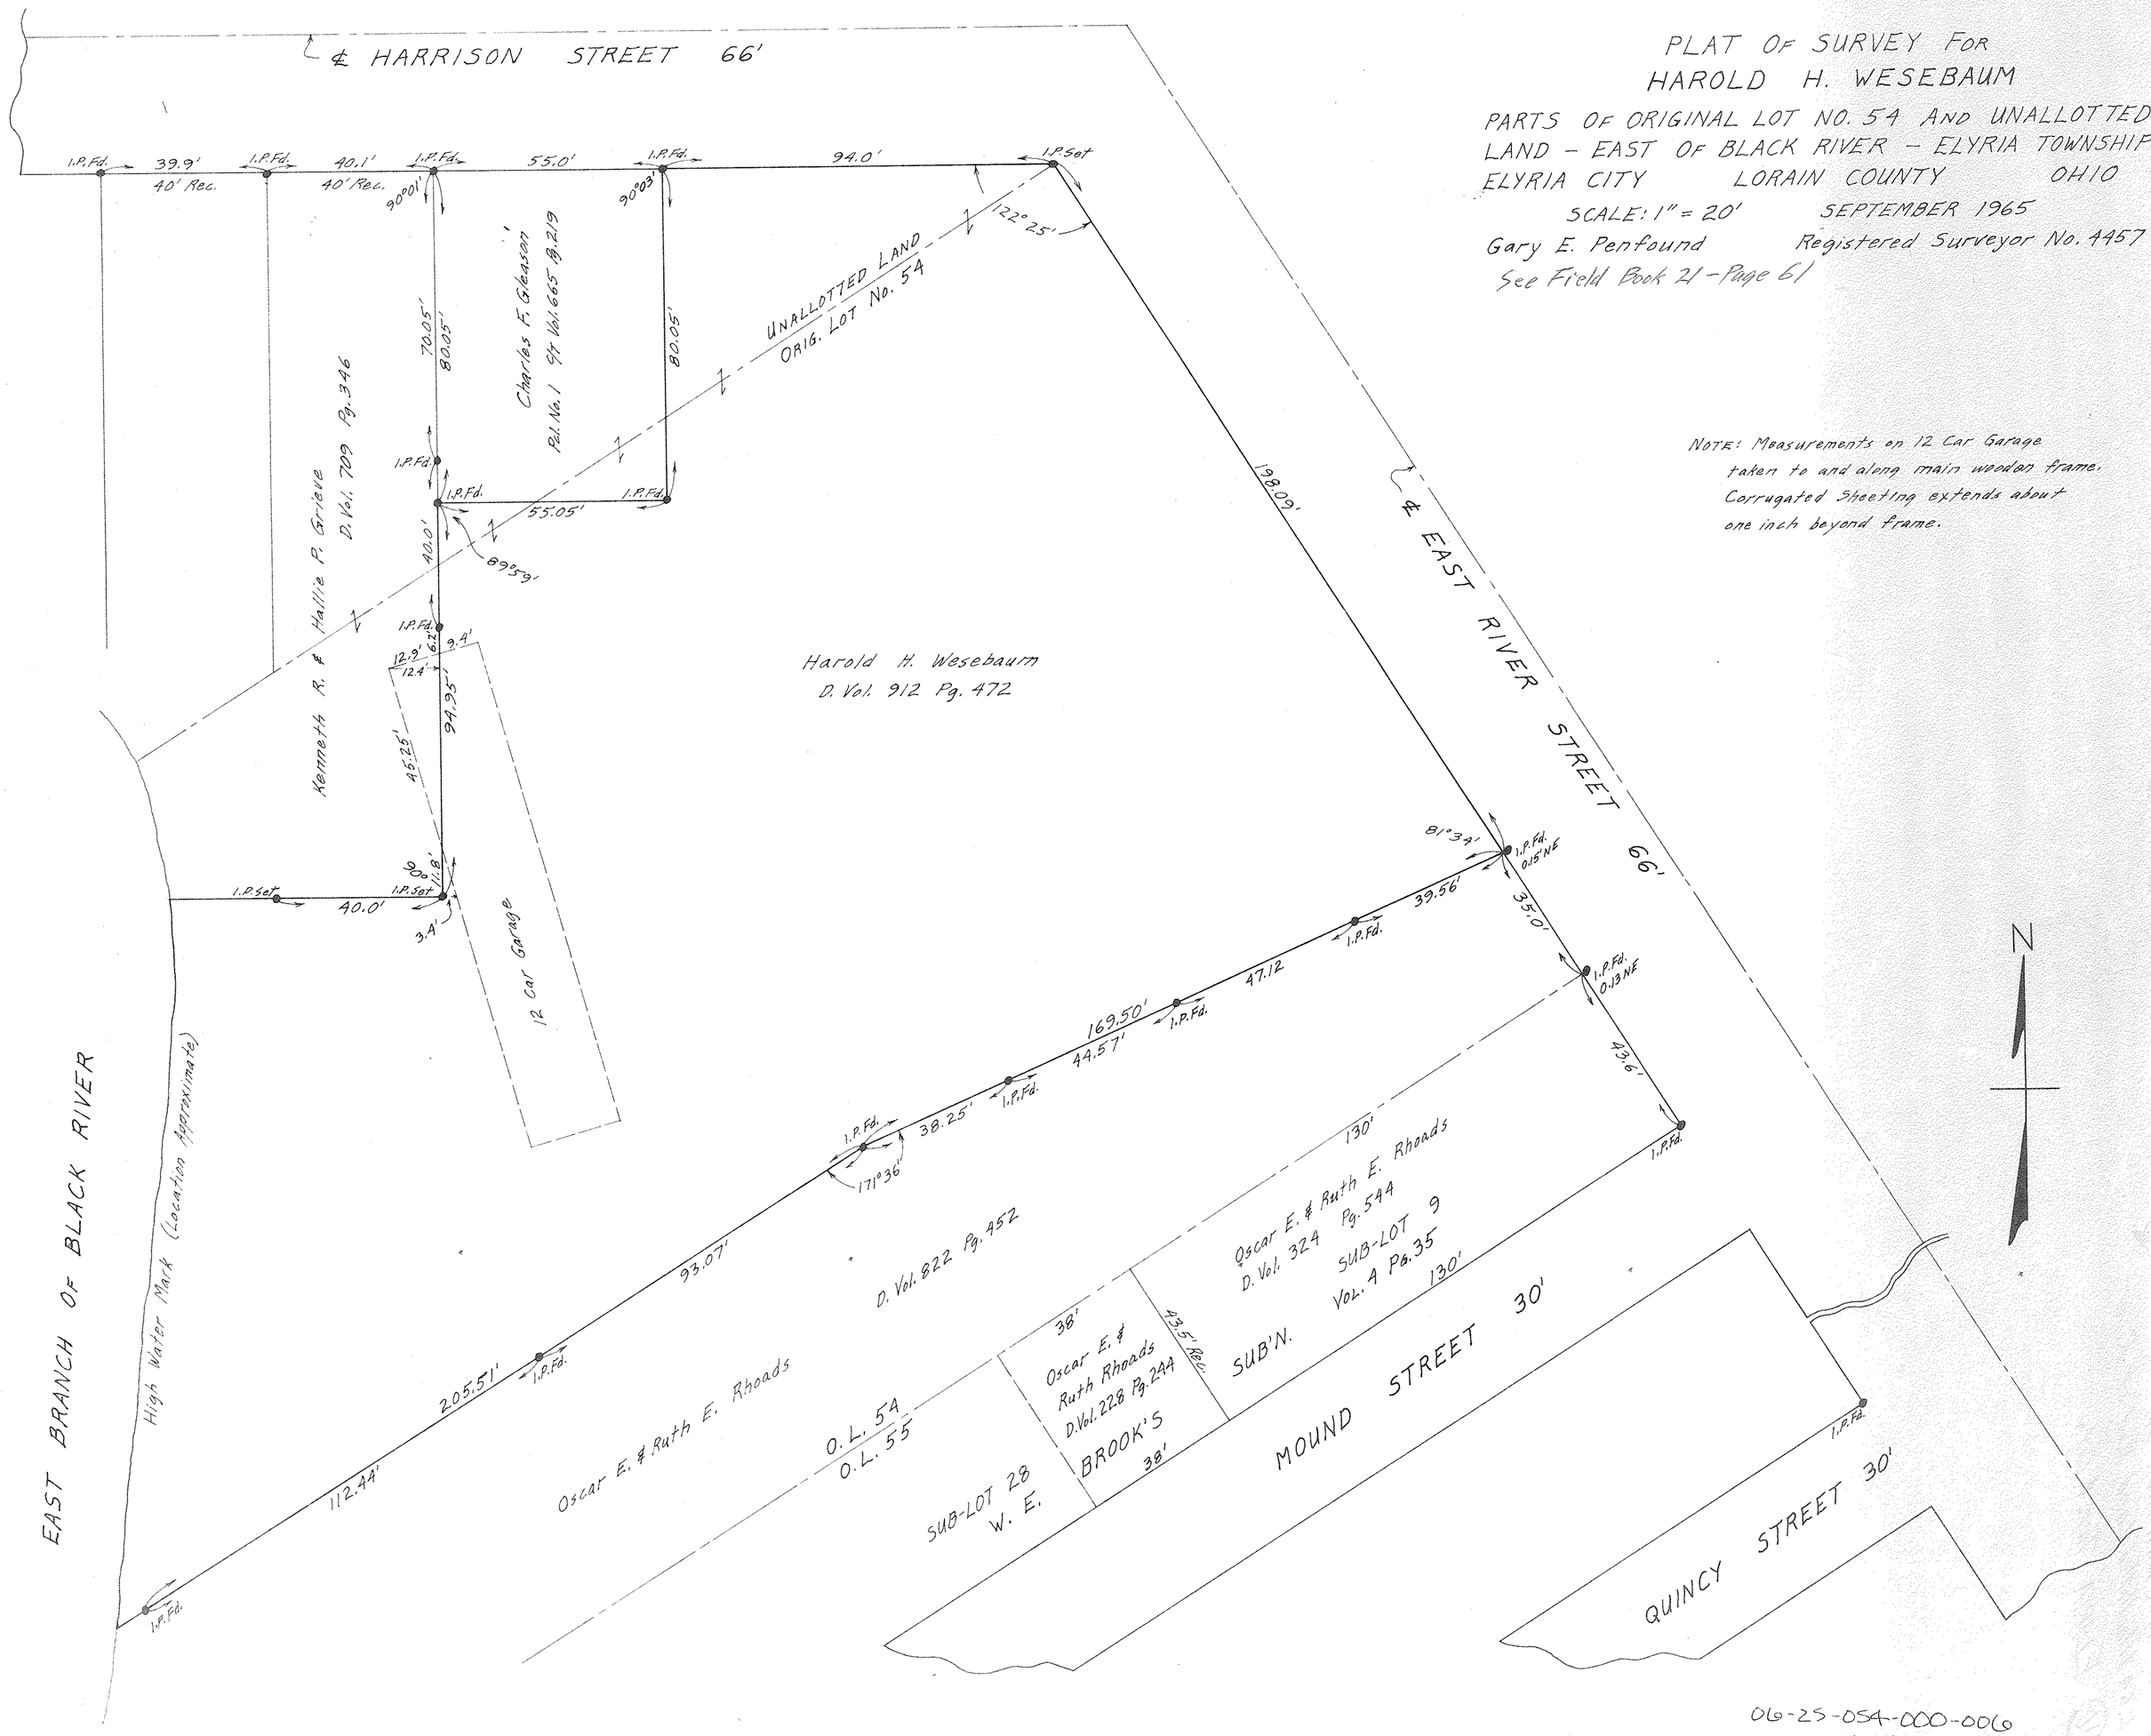

06-25-054-000-0006
MAP PG: 6-103