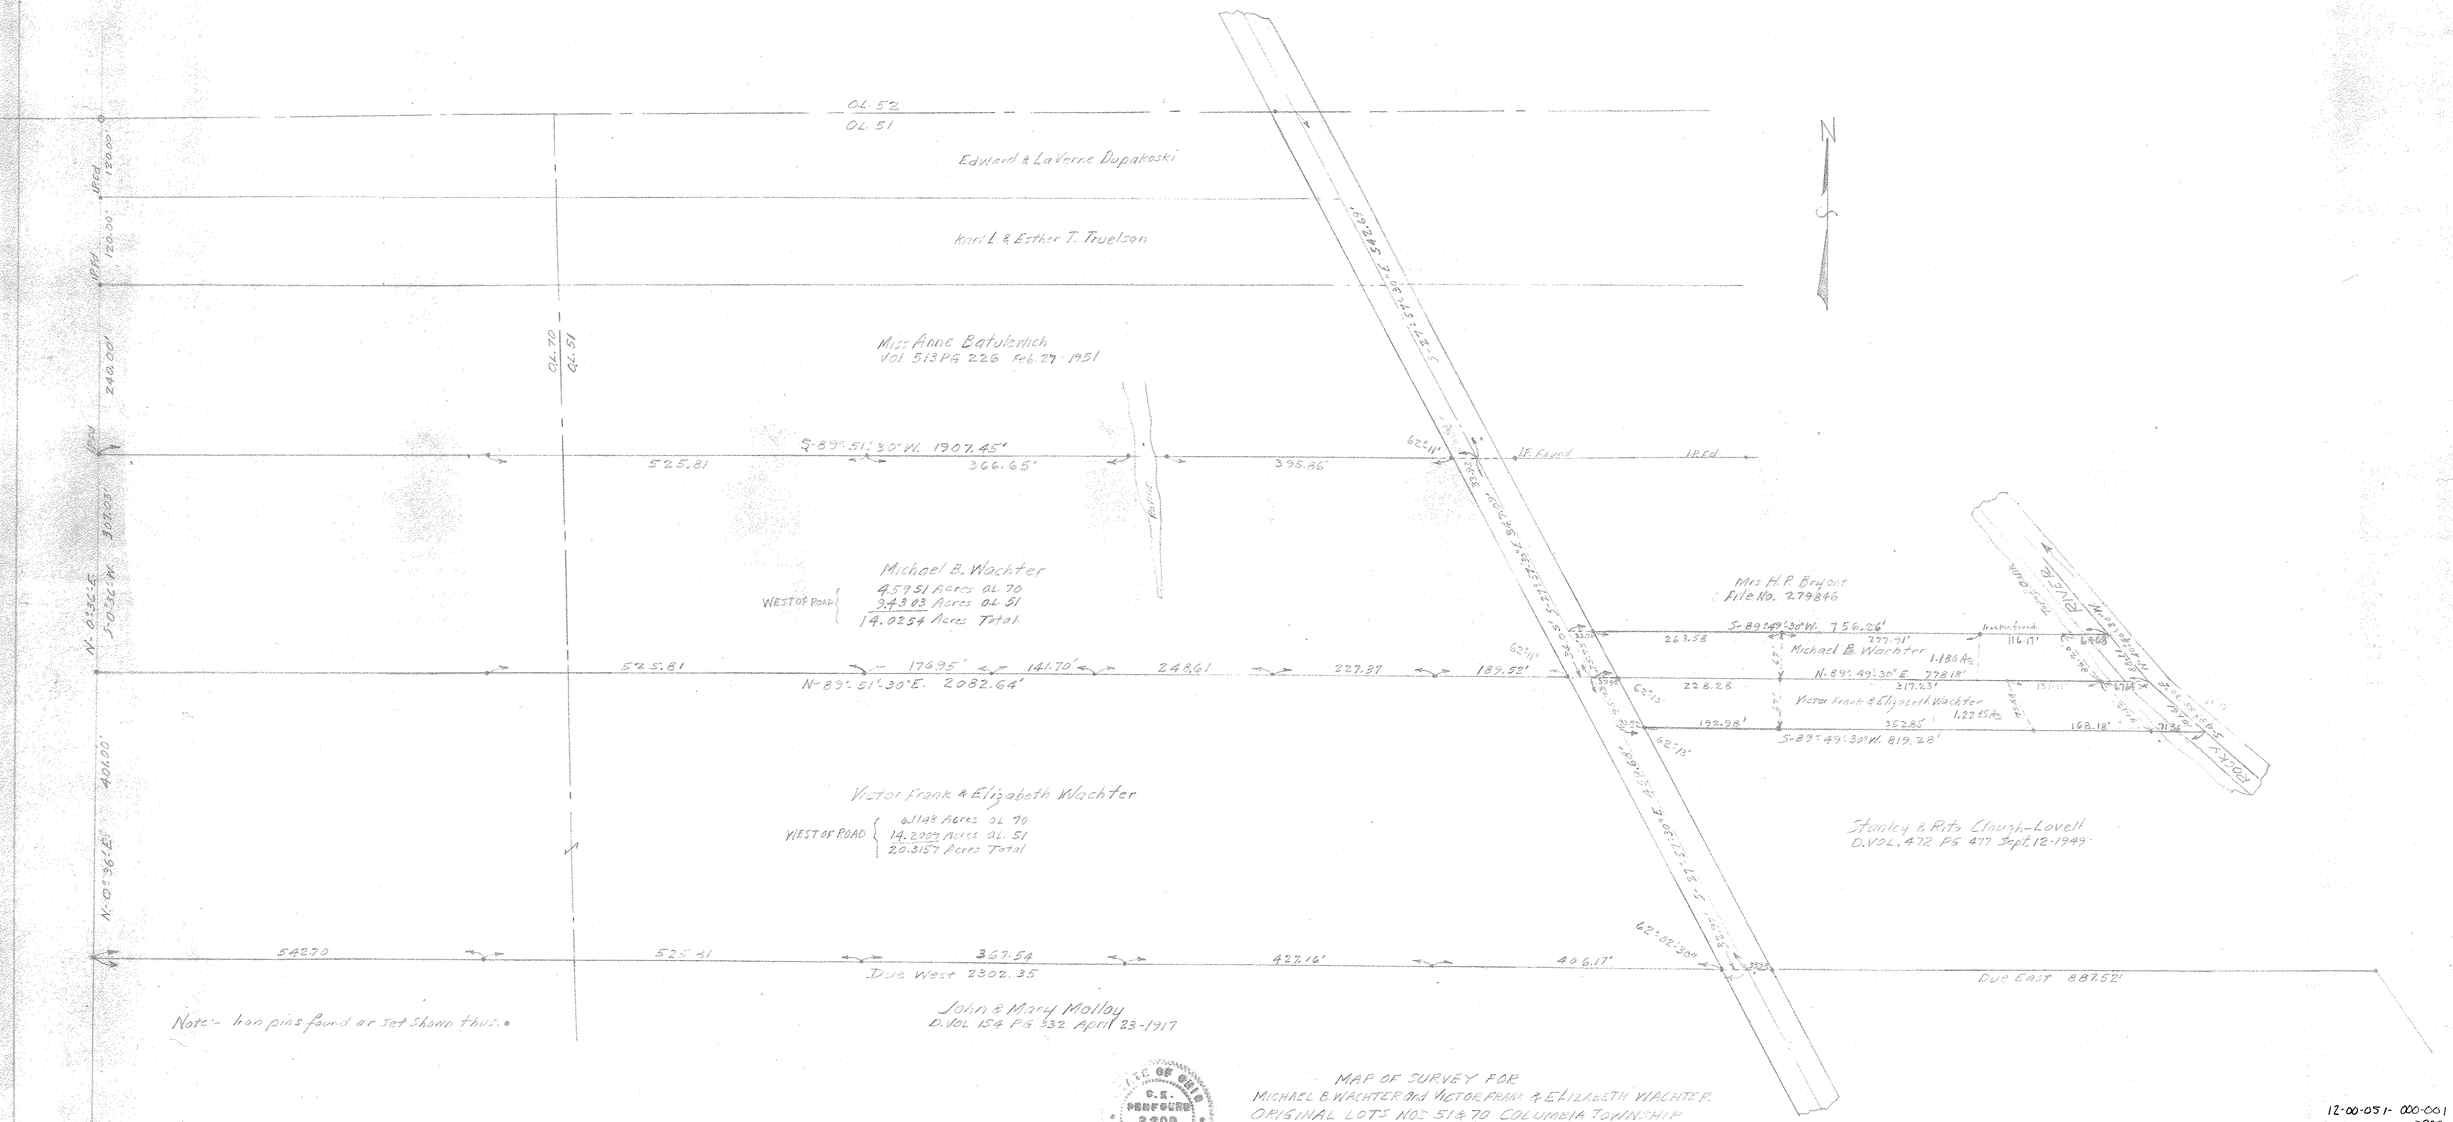

STATE OF OHIO
C.E. PENFOURD
3200
REGISTERED
SURVEYOR

MAP OF SURVEY FOR
MICHAEL B. WACHTER and VICTOR FRANK & ELIZABETH WACHTER
ORIGINAL LOTS NOS 51 & 70 COLUMBIA TOWNSHIP
LORAIN COUNTY OHIO
SCALE 1" = 100' JAN. 30-1957
C.E. Penfourd Registered Surveyor No. 3200

12-00-051- 000-001
-002
-003
-068 & -069
-014

12-F