

TOTAL AREA = 8.44 AC
TAKING AREA = 7.6098 AC
REMAINING AREA = 0.8342 AC

3-00-022-A
03-00-022-000-020


PPN 03-00-022-000 020

MMP P5 3-00-022-A

43455

Z

MACKERT PROPERTY
VOL. 991 PG. 549

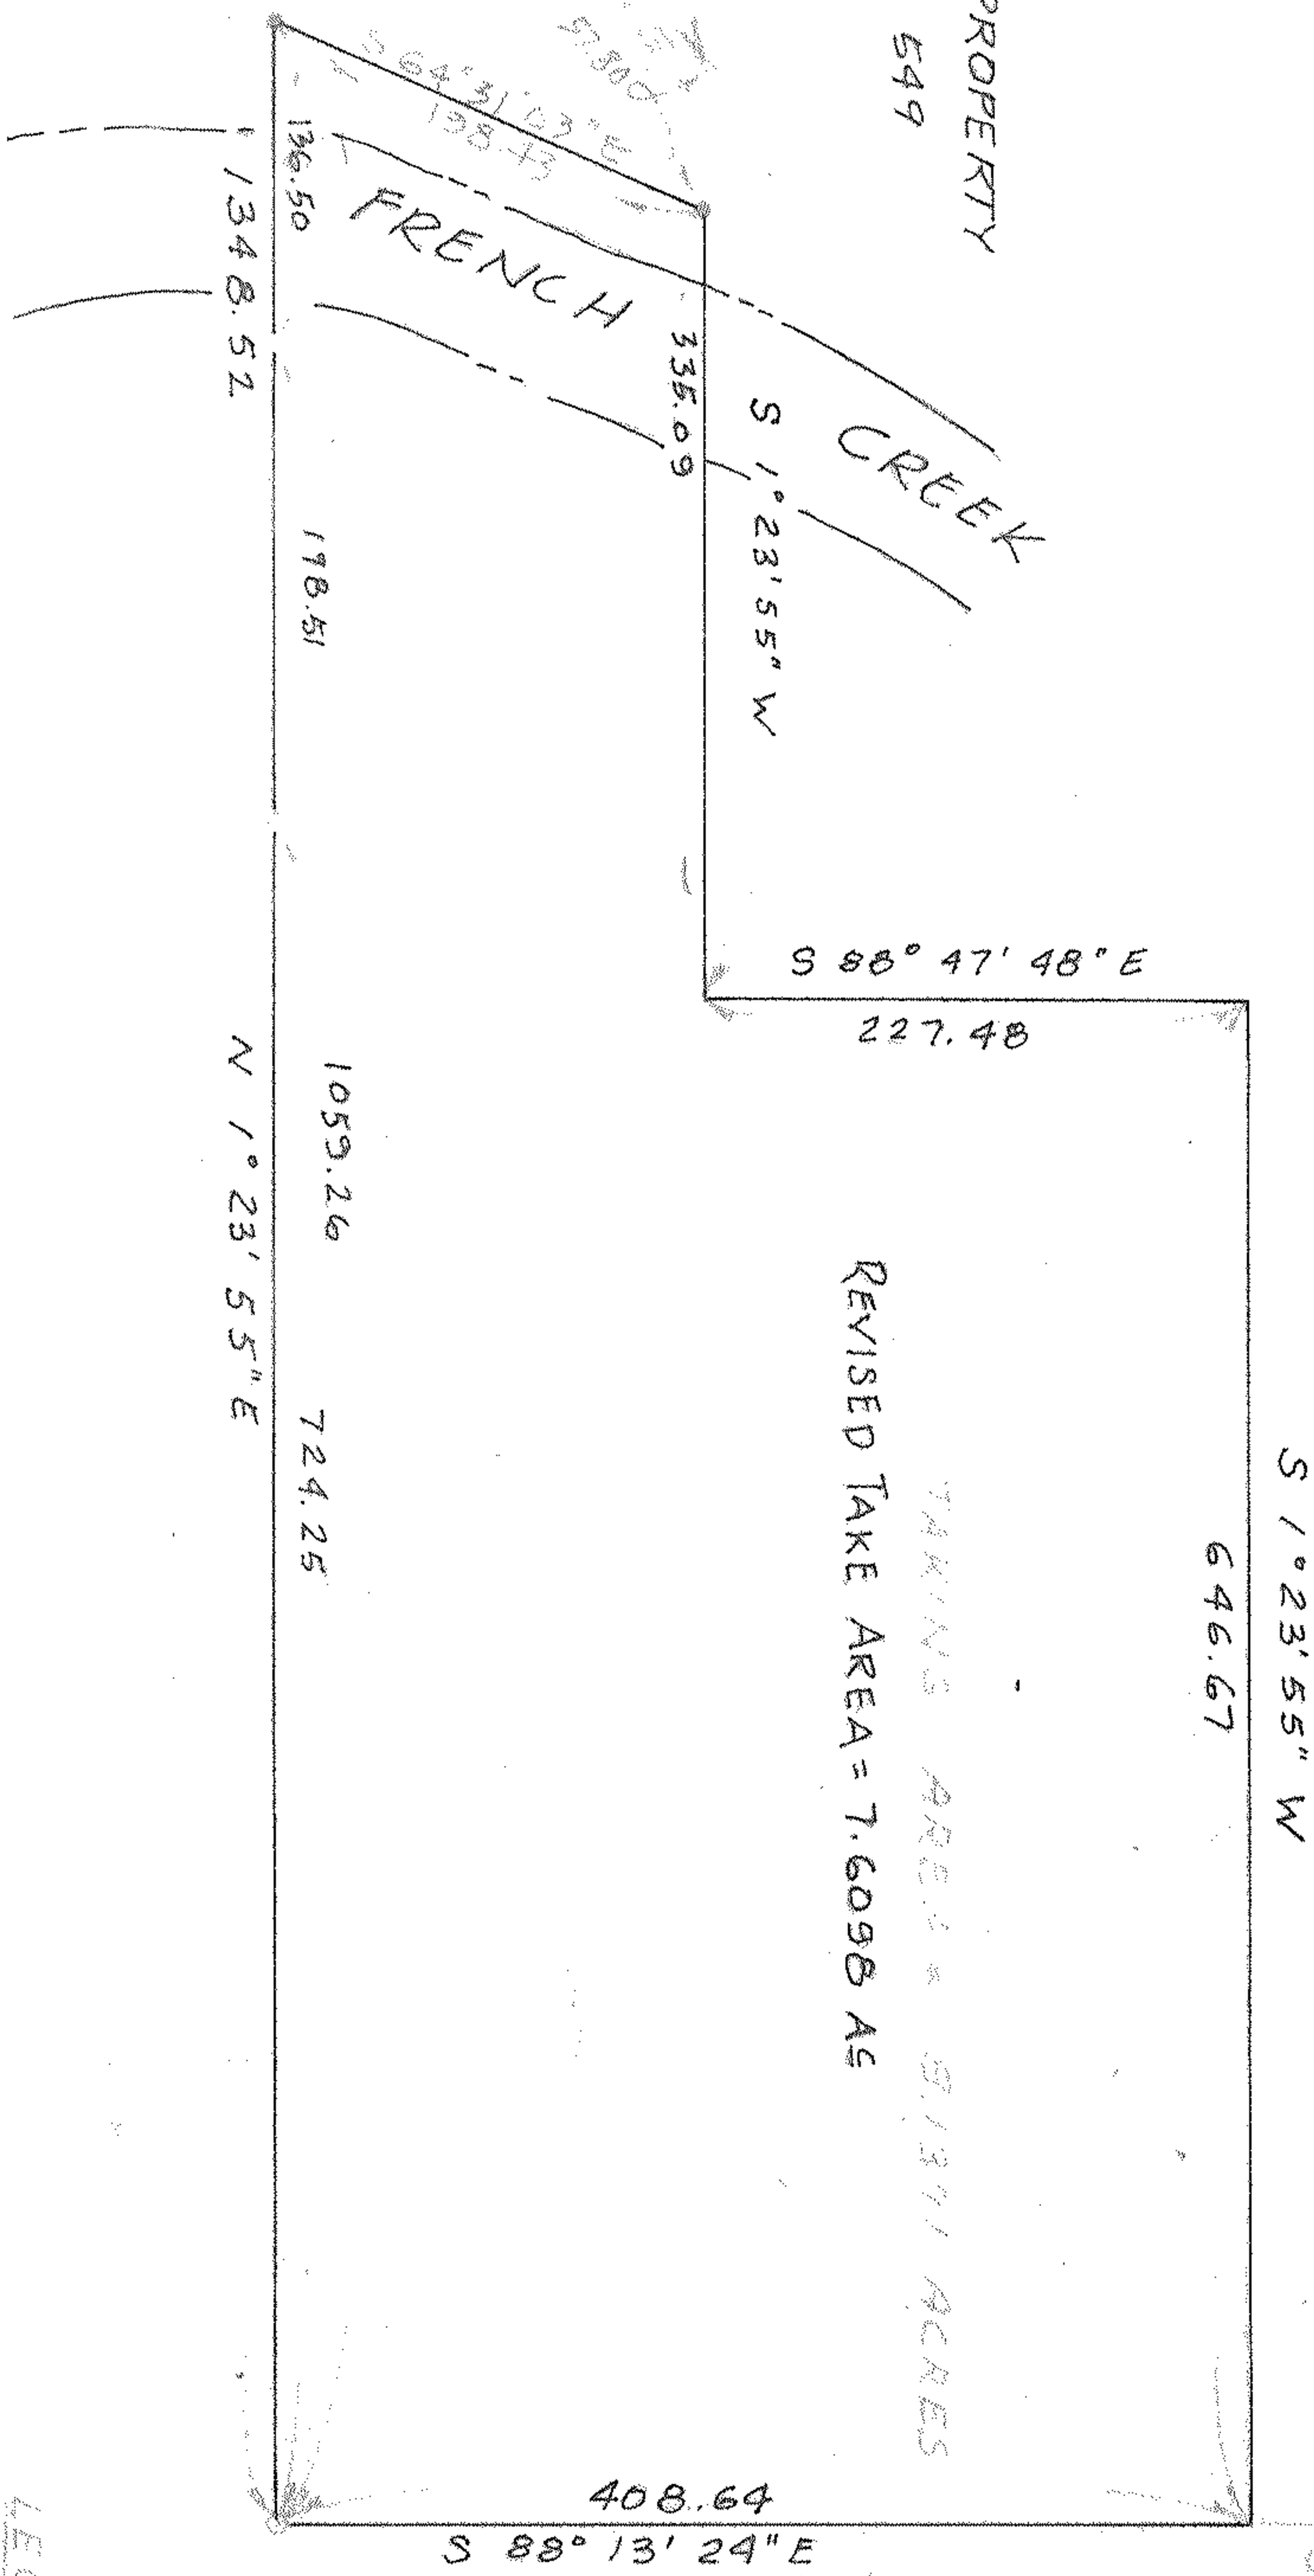

TAKING AREA = 7.6098 ACRES

LEGEND
● IRON PIN FOUND
— IRON PIN SET



REVISED 4-26-76 - JLM - S-1872

PROJECT NO.	22	DATE	3-27-76
CONTRACT NO.	SHEFFIELD	SCALE	1" = 40'
OWNER	LORAIN	DATE	2/5/75
DATE	OHIO	SCALE	1" = 40'
DATE		SCALE	1" = 40'

SCHAFER, HURA & ASSOCIATES, INC.
ENGINEERS AND SURVEYORS
4370 OBERLIN AVE.
LORAIN, OHIO

INDEXED REVISION
PPN 03-00-022-102-20
SHEFFIELD, OHIO