

TOTAL ACRES	6.7804
TAKEN AREA	6.3122
REMAINDER	0.4682

PPN 03-00-022-102-117

MAP P9 3-00-022-A

43456

L.C.M.P. PROPERTY
VOL 902 PG. 120

S 1° 00' 00" W
861.29

IRON PIPE
FD & USED
PLISZKA
PROPERTY
VOL. 417 PG. 334

TAKING AREA = 6.7804 ACRES
REVISED TAKE AREA = 6.3122 AS

N 1° 23' 55" E
646.67

N 88° 13' 24" W
266.14

O.L. 22
O.L. 21

N 88° 47' 48" W
227.48

S 67° 57' E
59.24

S 1° 15' 09" W
140.00

N 51° 06' 16" E
195.48

S 1° 15' 09" W
36.62

FRENCH CREEK



335.09

S 1° 23' 55" W
687.82

REITH PROPERTY
VOL. 1013 PG. 287

13680 ACRES

S 83° 05' W OLD COLORADO AVE
192.39

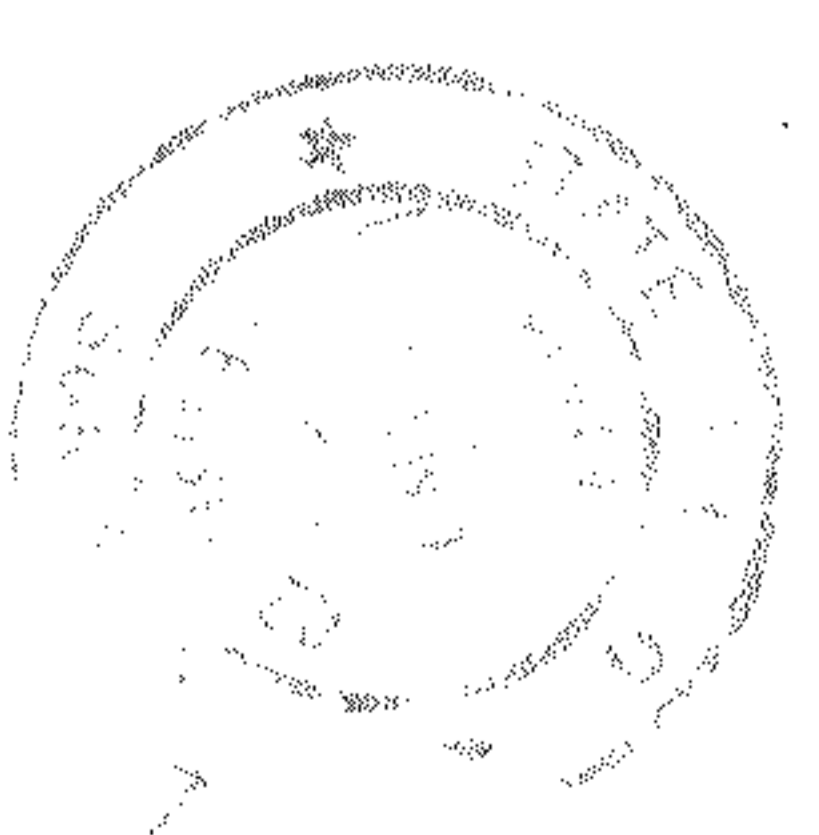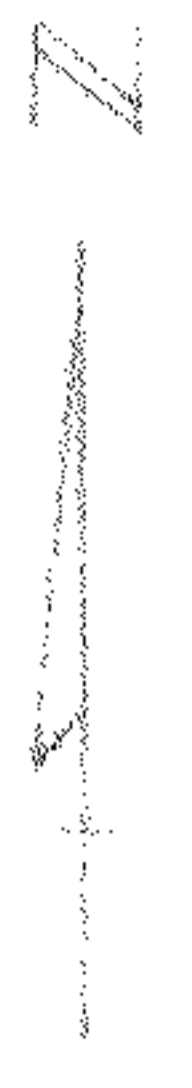

REVISED 4-26-78 BY J. L. M. 31073

ORIGINAL LOT 22 DATE 9-28-72

TOWNSHIP SHEEFIELD SCALE 1" = 100'

CITY OF LORAIN FIELD BOOK 218 PG. 83

COUNTY OF LORAIN DRAWN BY N.C.G.

STATE OF OHIO CHECKED BY J.L.M.

FILE NO. 685-5

SCHAFER, HURA & ASSOCIATES, INC.

ENGINEERS AND SURVEYORS

4170 OBERLIN AVE.
LORAIN, OHIO

SURVEY

LESTER HURON
P.P. 03-00-022-102-2
SHEEFIELD OHIO