


43446

PAUL A RISSMANN, EAST ERIE AVE

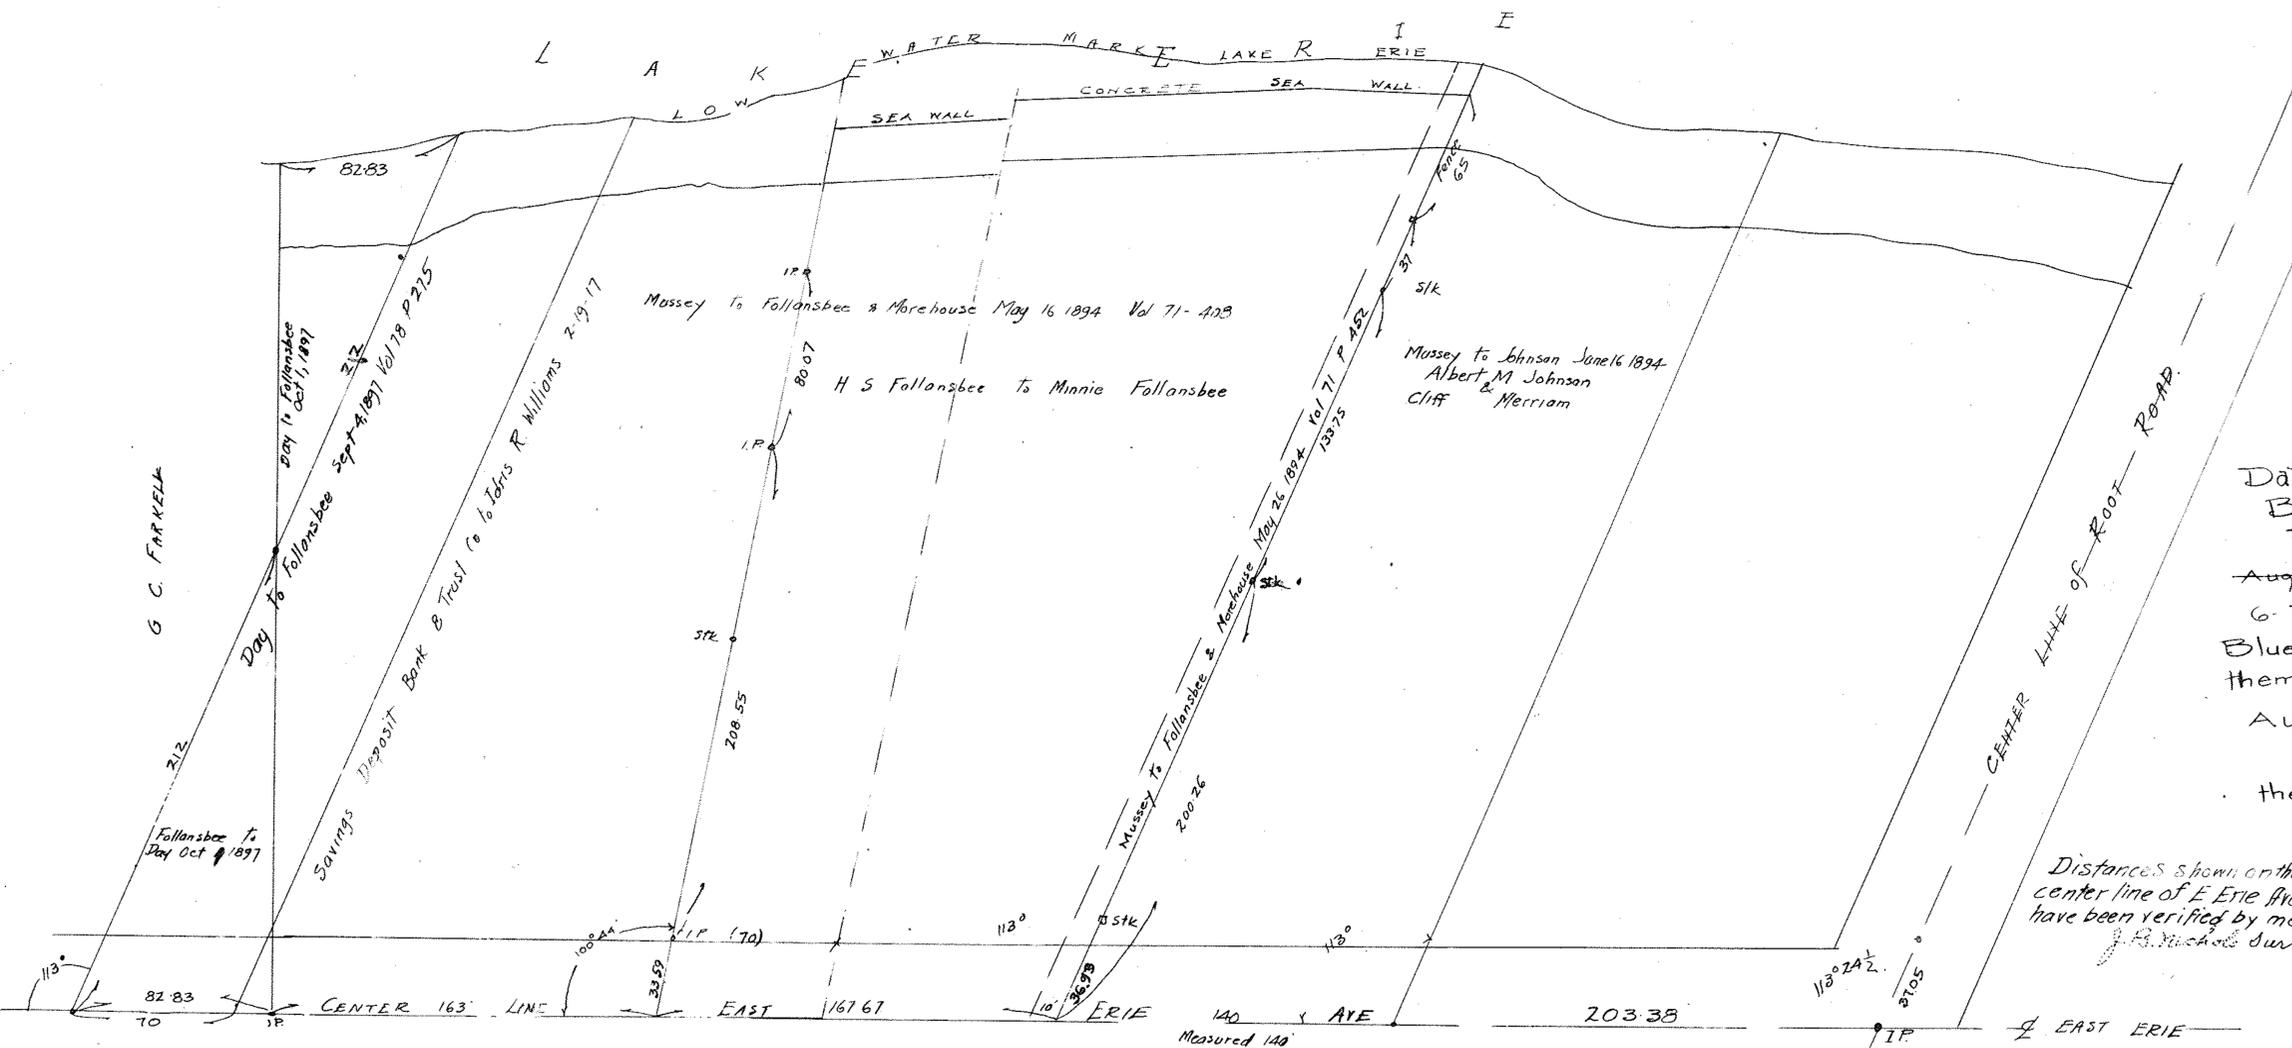

Note
 Data hereon was taken from
 Blue Print brought in by
 Paul A. Rissmann 1926
 Aug 2-1926 There were 15
 G. Deed Descriptions shown on the
 Blue Print but I didn't trace
 them.
 Aug 3, 1926
 There was also notes on this Blue Print
 the following

Distances shown on the
 center line of E Erie Ave
 have been verified by me
 J. H. Nichols Surveyor

"The measurements as shown
 on the center line of East Erie Ave
 are correct
 (signed) by James C. Miller
 City Engineer April 1926"

SCALE 1"=50' 0"