3-00-046-101
3-00-046-A

PPN 03-00-046-101 ???

MAP pg 3-00-046-A

43447

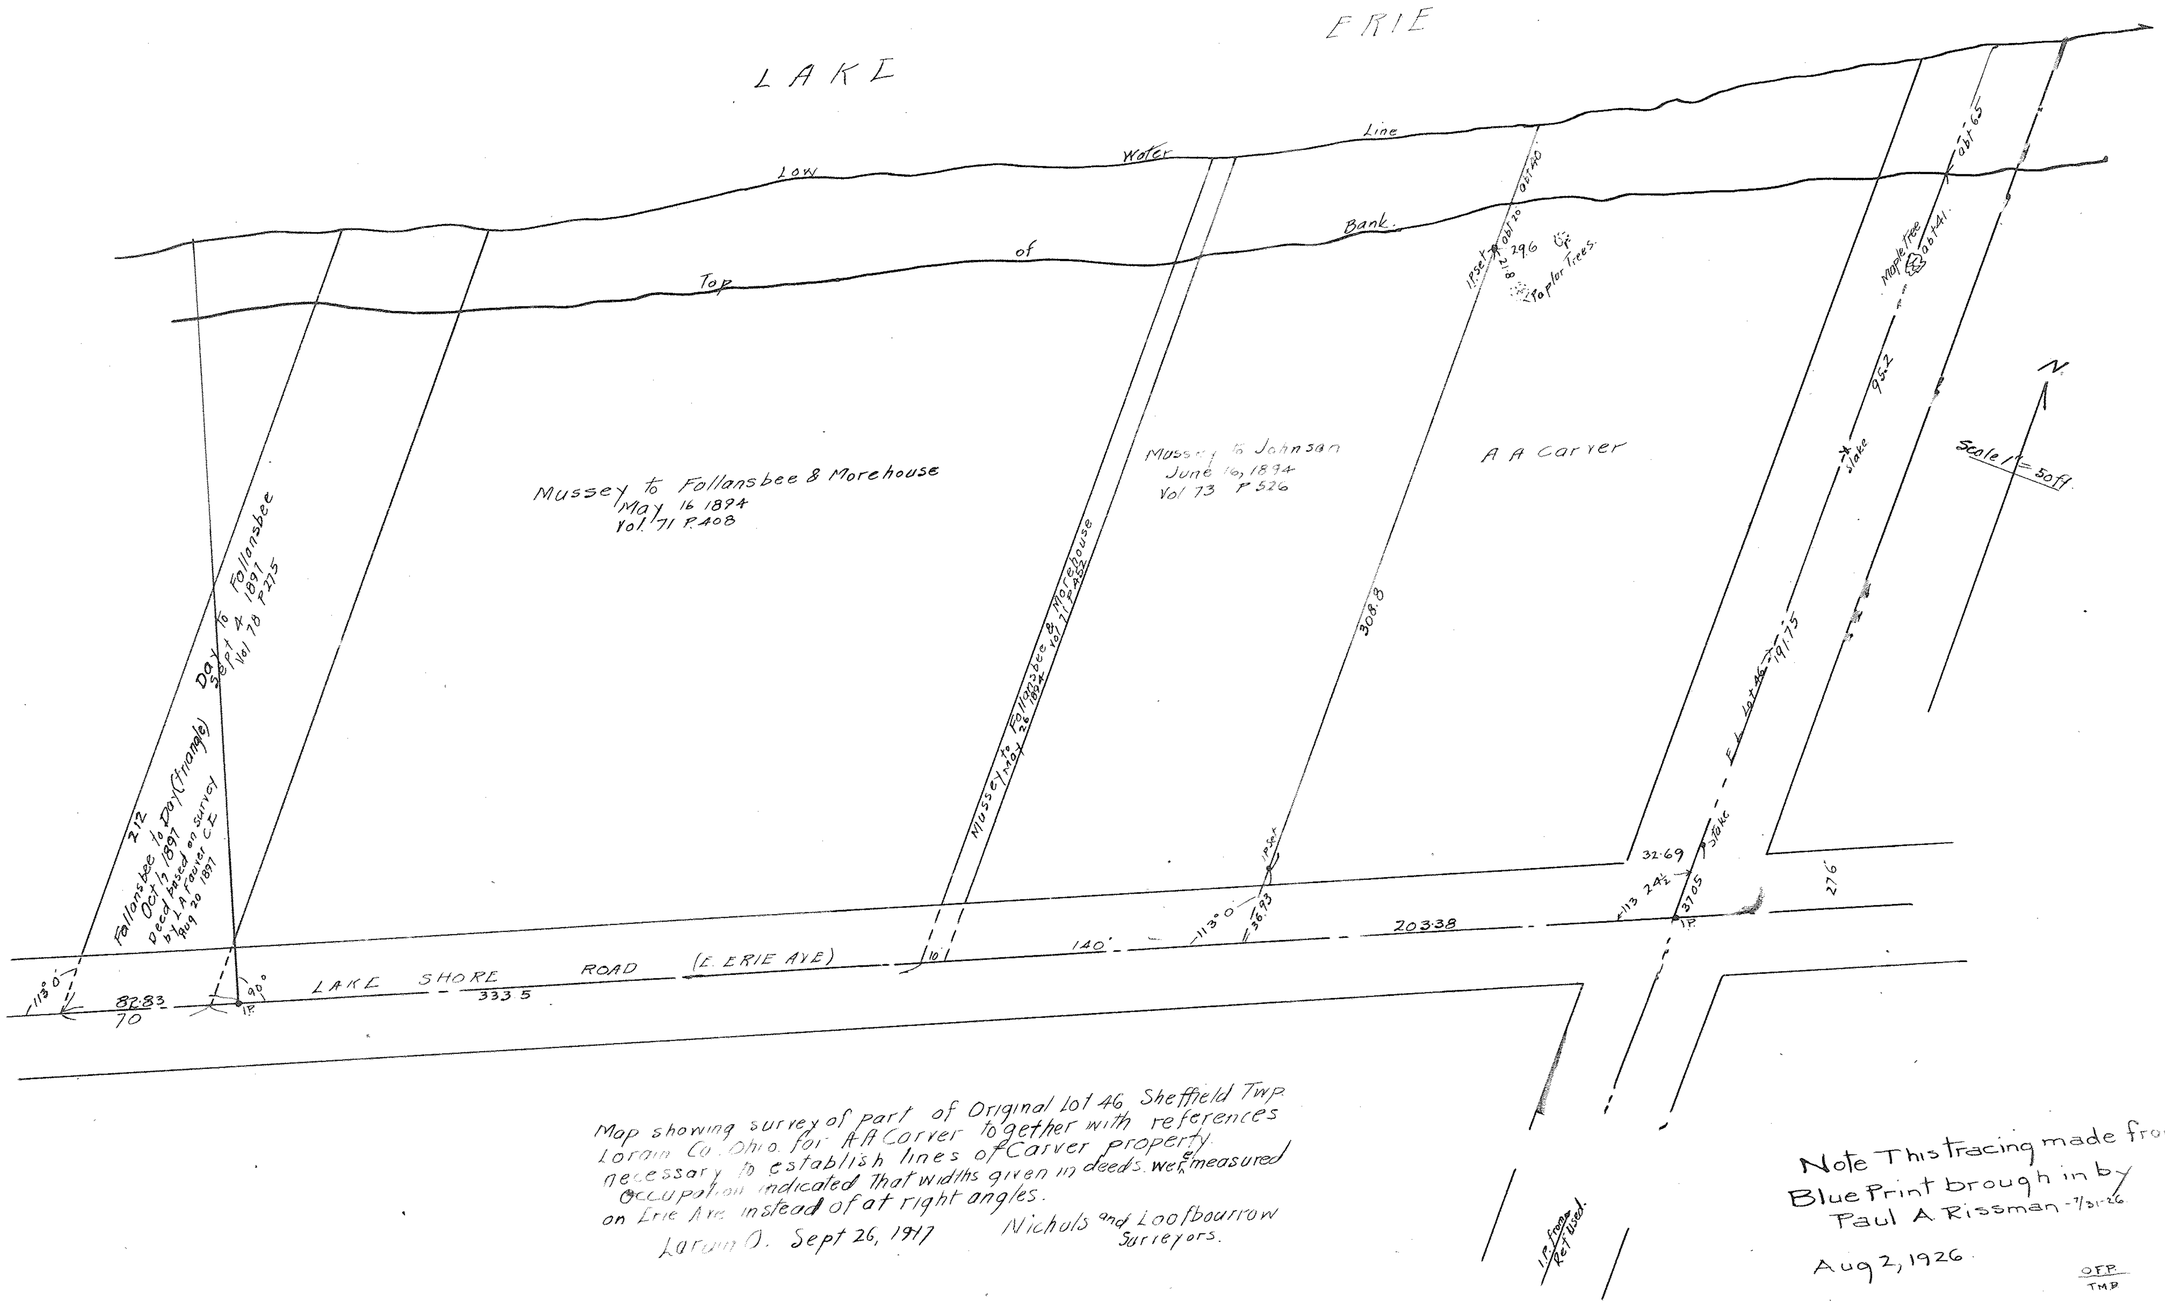

Map showing survey of part of Original Lot 46 Sheffield Twp. Lorain Co. Ohio for A A Carver together with references necessary to establish lines of Carver property. Occupation indicated that widths given in deeds were measured on Erie Ave instead of at right angles.

Lorain O. Sept 26, 1917 Nichols and Loofbourrow Surveyors.

Note This tracing made from Blue Print brough in by Paul A. Rissman - 7/31-26

Aug 2, 1926

OFP
TMP