01-00-005-000-129
1-00-005-B
1-00-005-D

PPN 01-00-005-000-129

map PG 01-00-005-B, D

43535

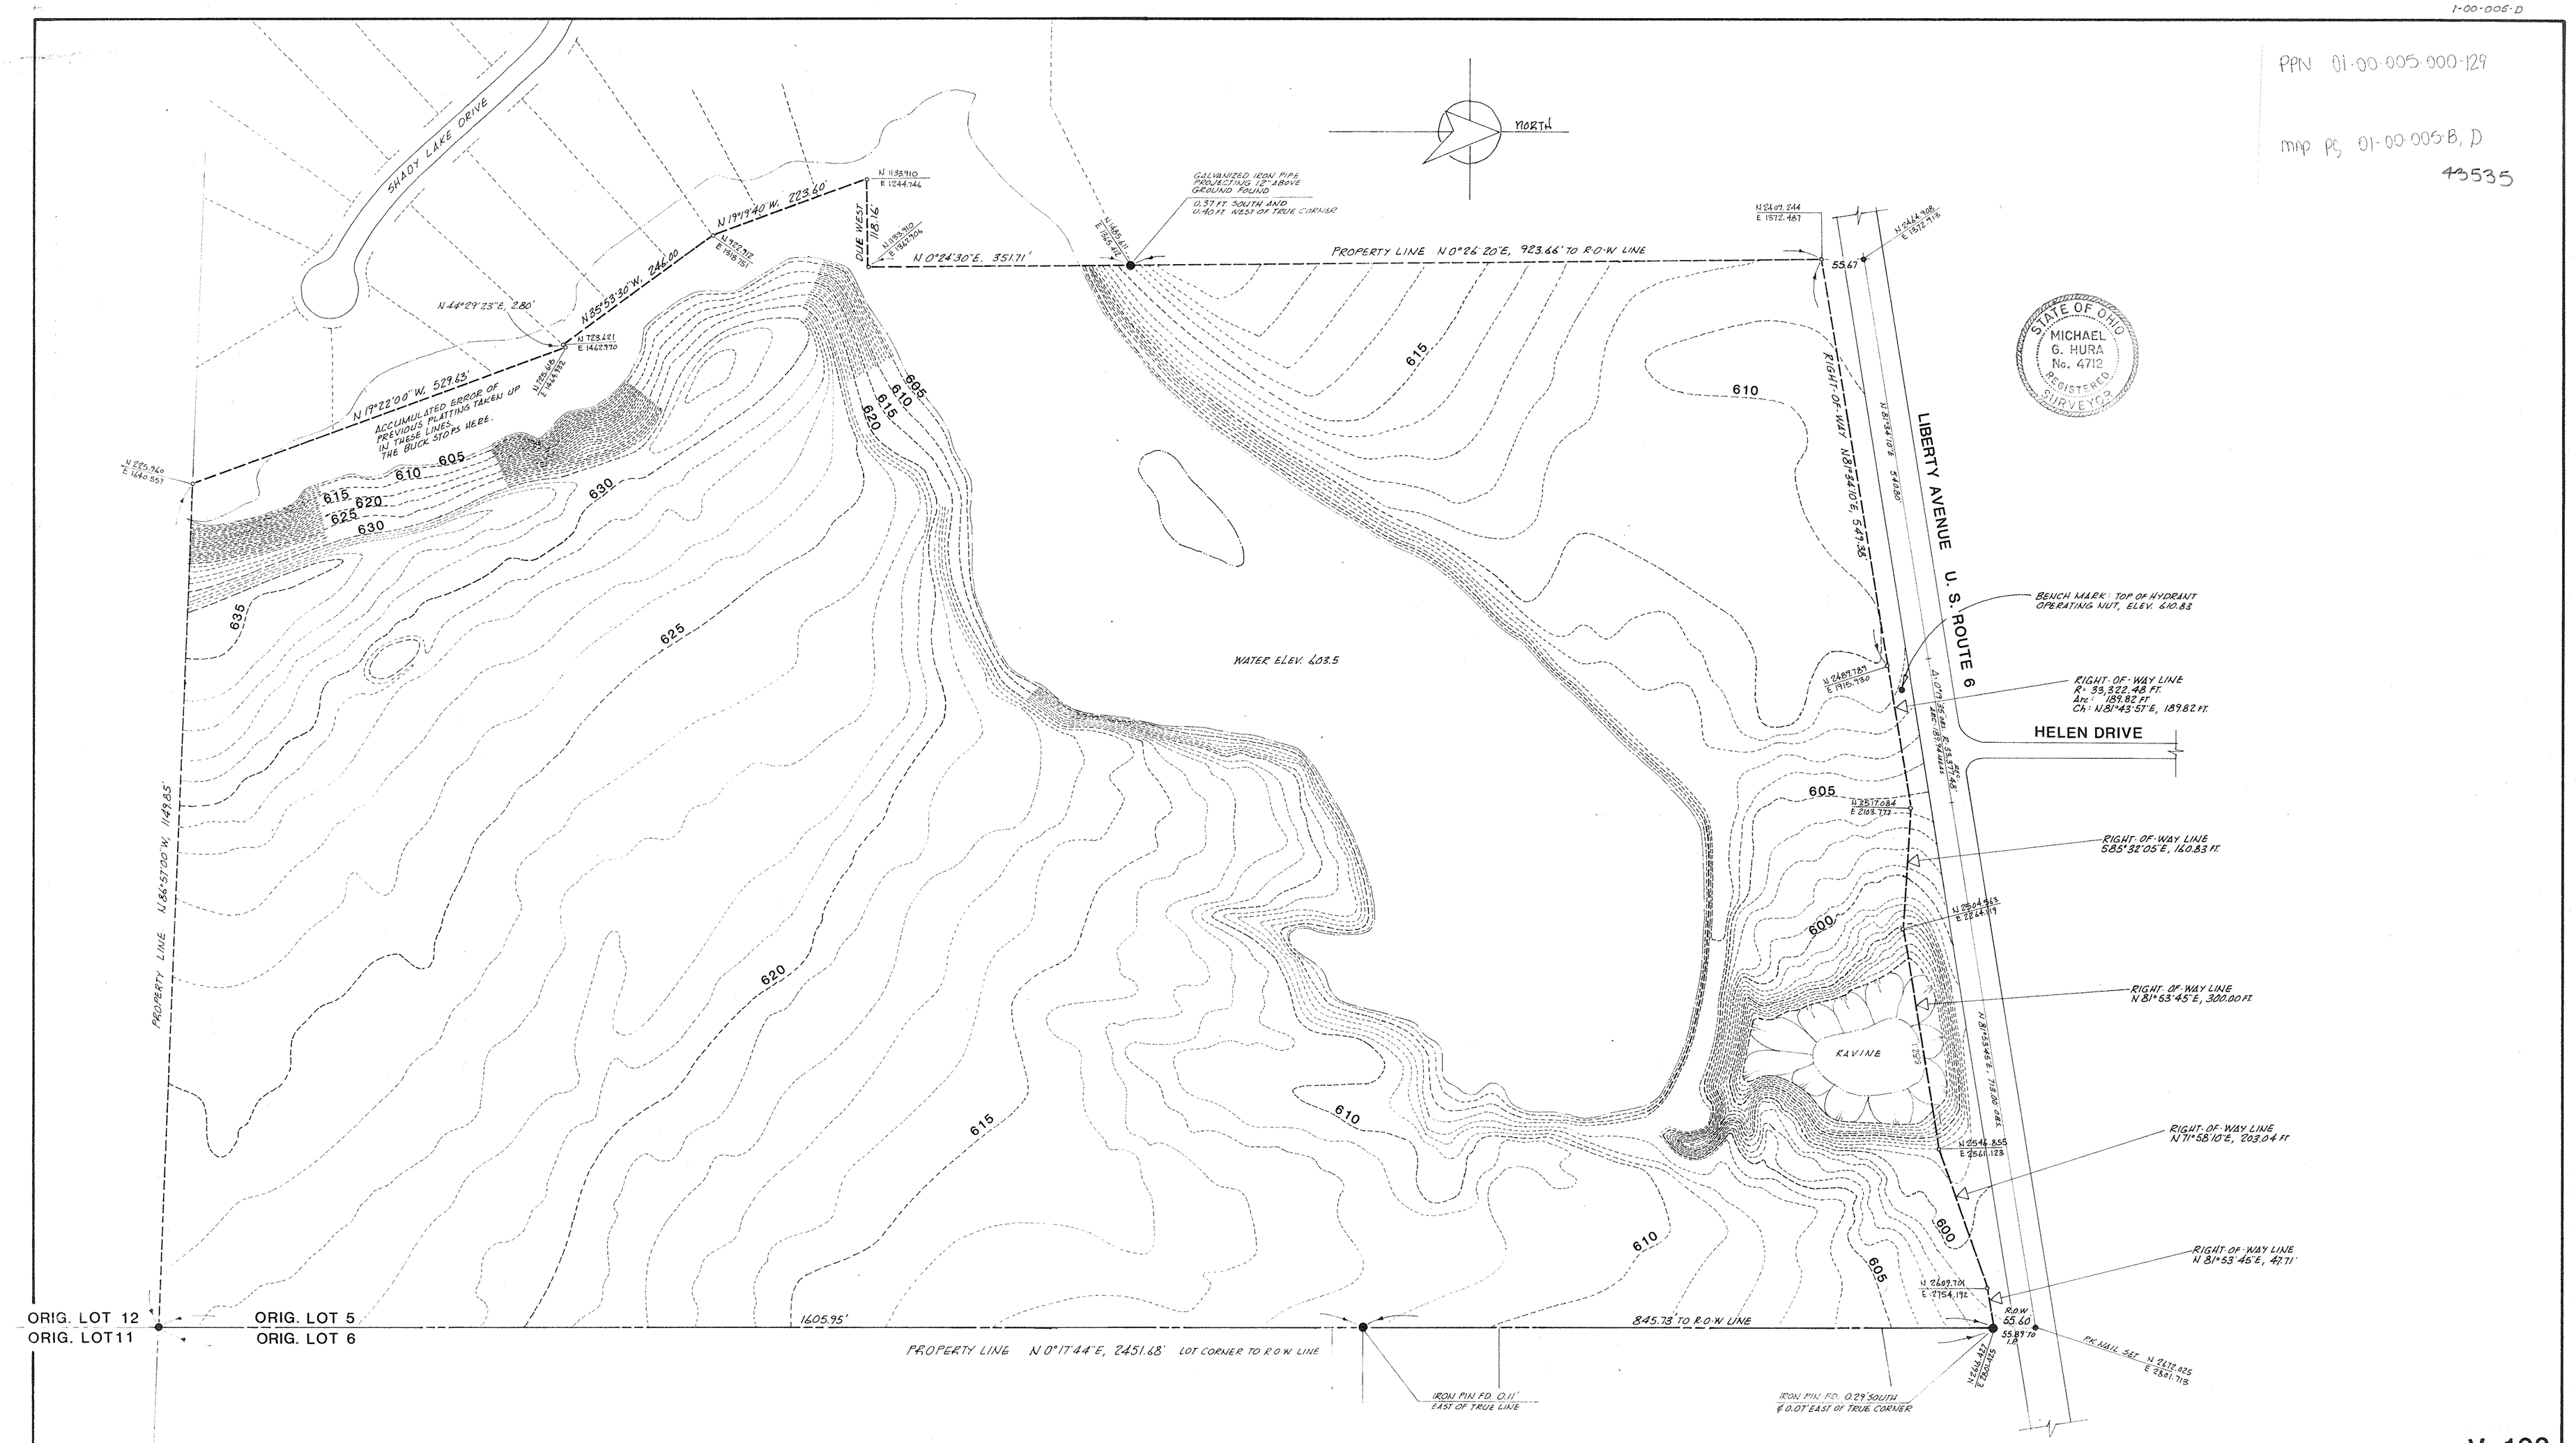

V-102

Michael G. Hura and Associates
4560 LIBERTY AVENUE, VERMILION, OHIO
A Division of National Survey Service, Inc.

ENGINEERING
SURVEYING
IMAGINATION

PREPARED FOR

PERIMETER SURVEY & GENERAL TOPOGRAPHY - 73.5696 ACRE PARCEL
PART OF ORIGINAL BROWNHELM TOWNSHIP LOT 5,
NOW CITY OF VERMILION, LORAIN COUNTY, OHIO

REVISION Nº	DATE	DESCRIPTION

DATE 02-15-80
DRAWN MGH
SCALE 1" = 100'
CHECKED
REFERENCE Nº

DRAWING Nº V-102
SHEET 1 OF 1