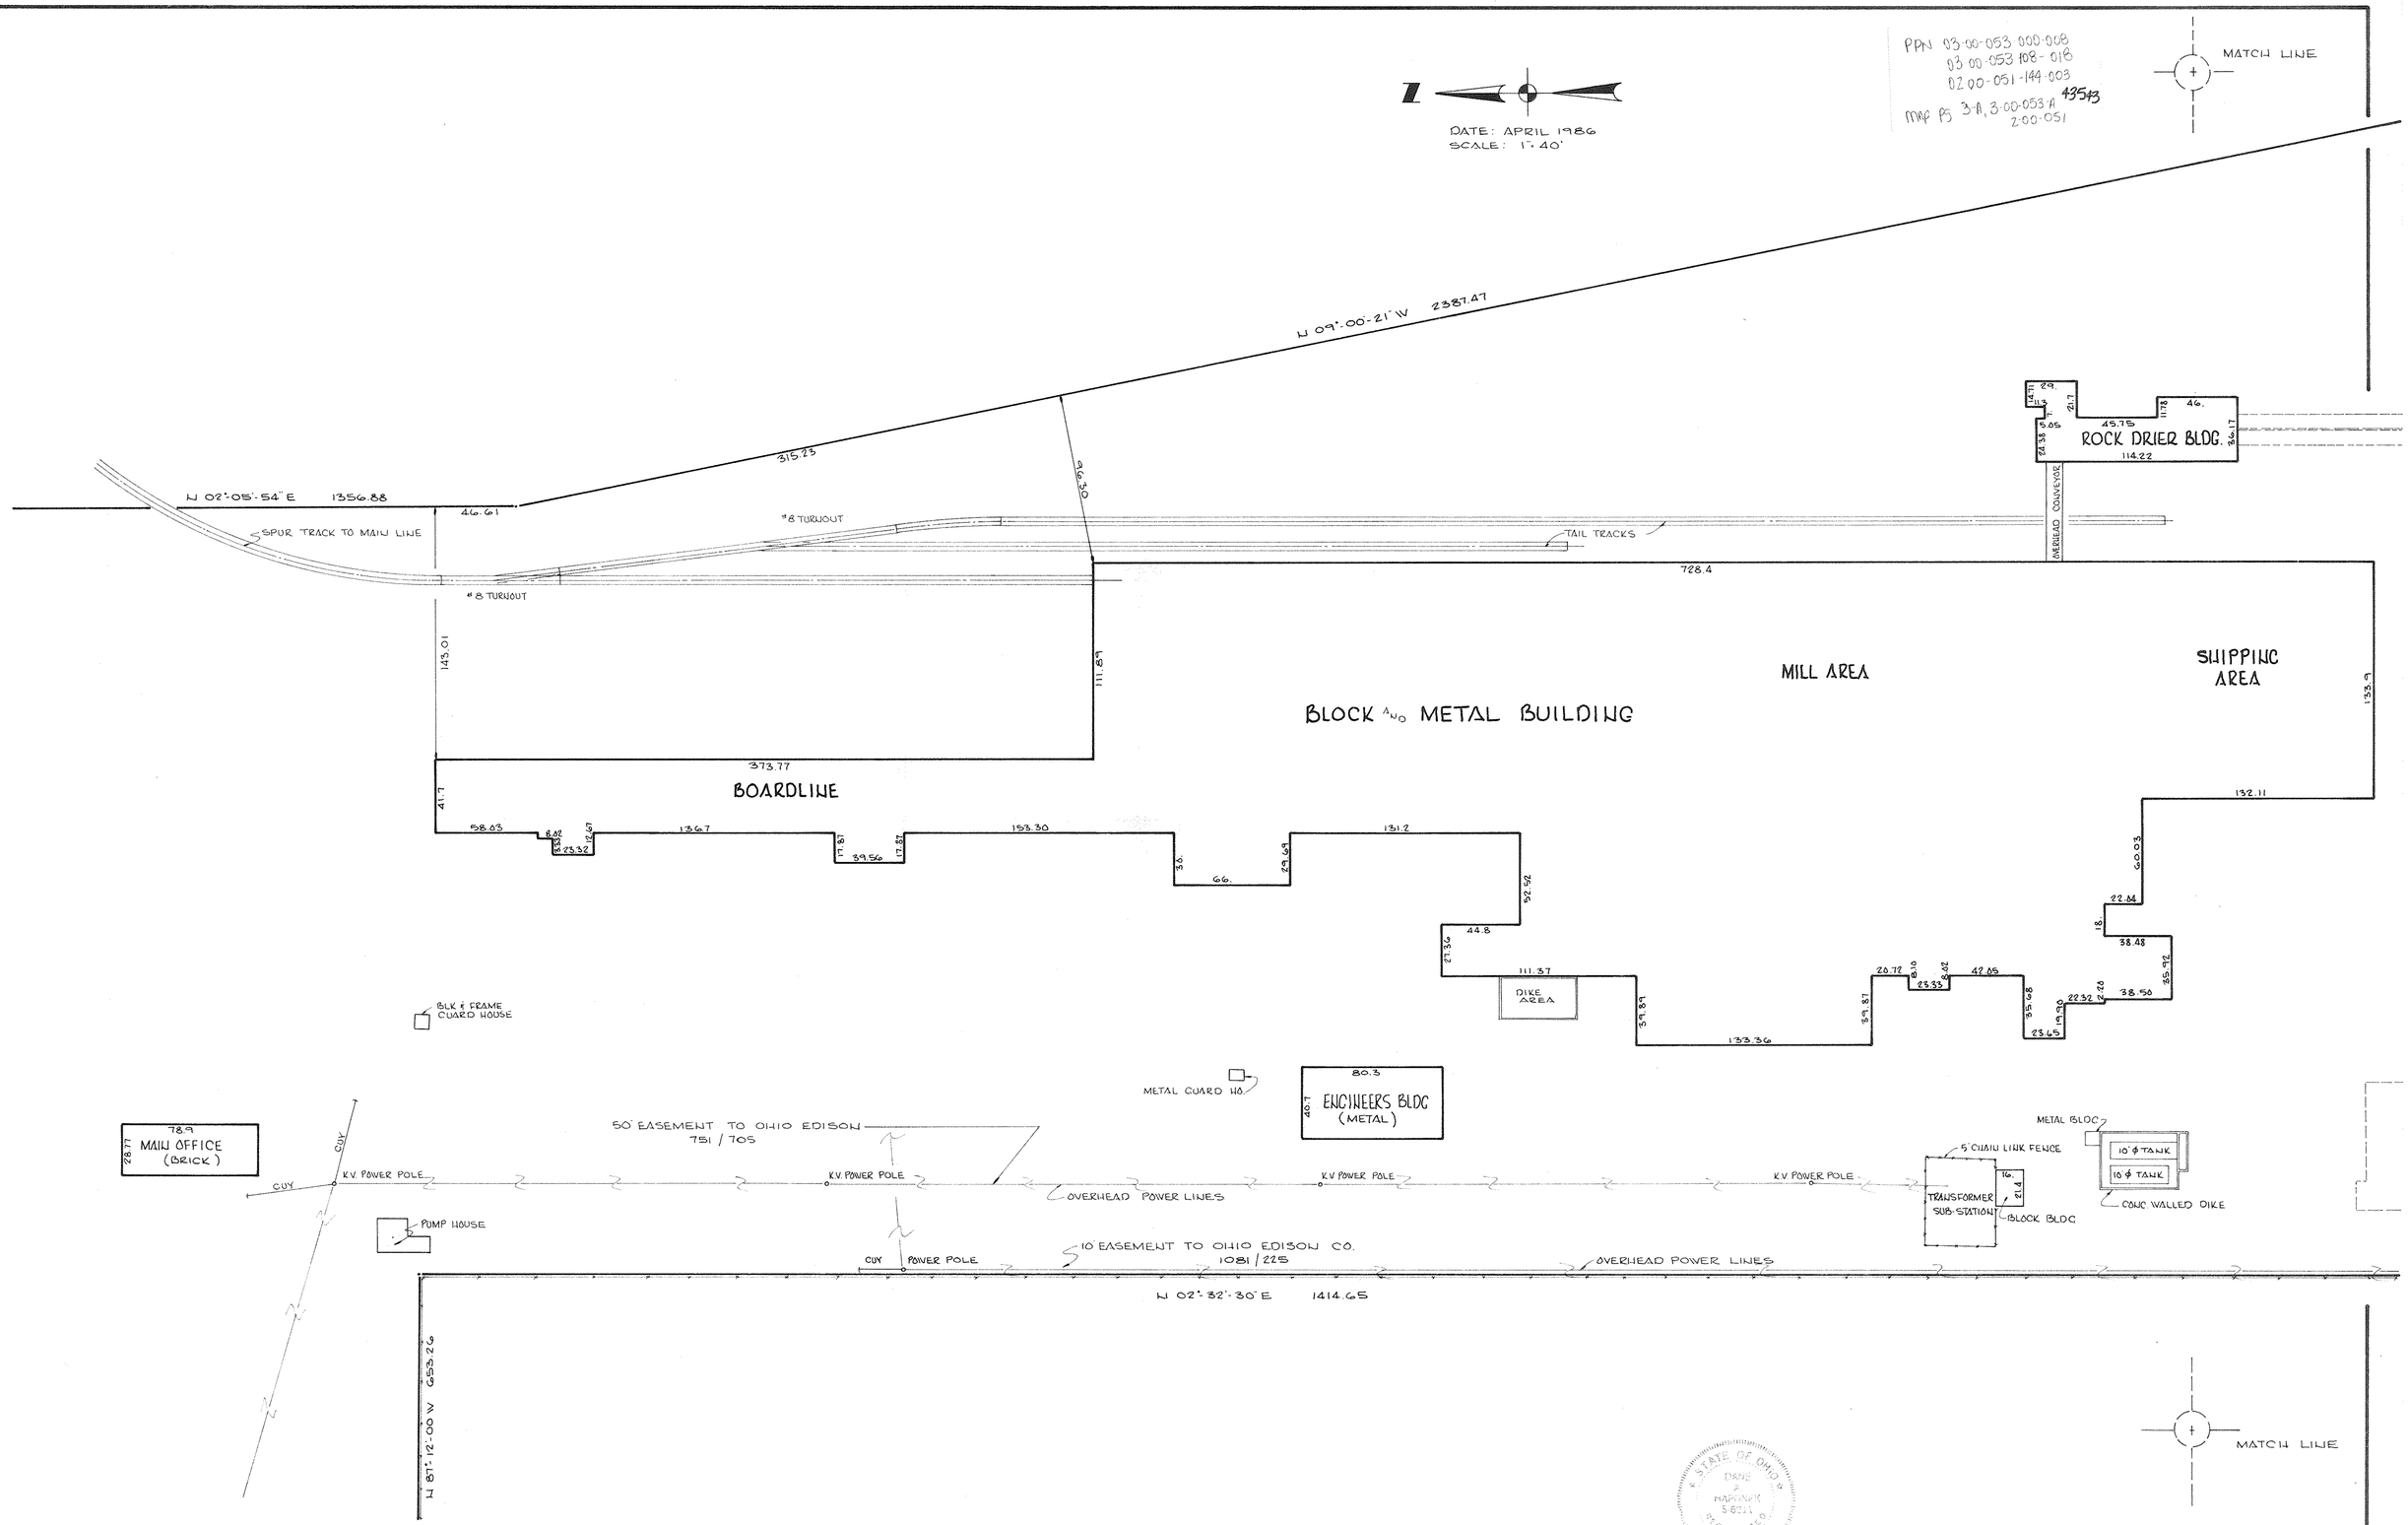
PPN 03-00-053-000-008
03-00-053-108-018
02-00-051-144-003
MAP PG 3-A, 3-00-053-A 2-00-051
43513
MATCH LINE
DATE: APRIL 1986
SCALE: 1" = 40'
N 09°-00'-21" W 2387.47
315.23
96.30
N 02°-05'-54" E 1356.88
46.61
SPUR TRACK TO MAIN LINE
#8 TURNOUT
#8 TURNOUT
TAIL TRACKS
728.4
ROCK DRIER BLDG.
114.22
OVERHEAD CONVEYOR
145.01
111.89
MILL AREA
SHIPPING AREA
BLOCK AND METAL BUILDING
373.77
BOARDLINE
41.7
58.03
6.82
23.32
136.7
17.87
39.56
17.87
153.30
30.
66.
29.69
131.2
52.52
44.8
27.36
111.37
DIKE AREA
39.87
133.36
39.87
20.72
8.10
8.02
42.05
35.48
23.65
19.90
22.32
7.26
38.50
35.92
38.48
18.
22.84
60.03
132.11
133.9
BLK & FRAME GUARD HOUSE
METAL GUARD HO.
80.3
ENGINEERS BLDG (METAL)
78.9
MAIN OFFICE (BRICK)
50' EASEMENT TO OHIO EDISON 751 / 705
K.V. POWER POLE
K.V. POWER POLE
K.V. POWER POLE
K.V. POWER POLE
GUY
GUY
OVERHEAD POWER LINES
PUMP HOUSE
METAL BLDG
5' CHAIN LINK FENCE
10' ϕ TANK
10' ϕ TANK
TRANSFORMER SUB-STATION
BLOCK BLDG
CONC WALLED DIKE
GUY
POWER POLE
10' EASEMENT TO OHIO EDISON CO. 1081 / 225
OVERHEAD POWER LINES
N 02°-32'-30" E 1414.65
N 87°-12'-00" W 653.26
MATCH LINE
STATE OF OHIO
DANE A. MARUNICH
5621
REGISTERED SURVEYOR