1-00-041-000-012
1-00-041-000-013
1-00-056-000-028
1-H
1-L

PPN 01-00-041-000-012
013
01-00-056-000-028
43553
MAP PG 1-H, 1-L

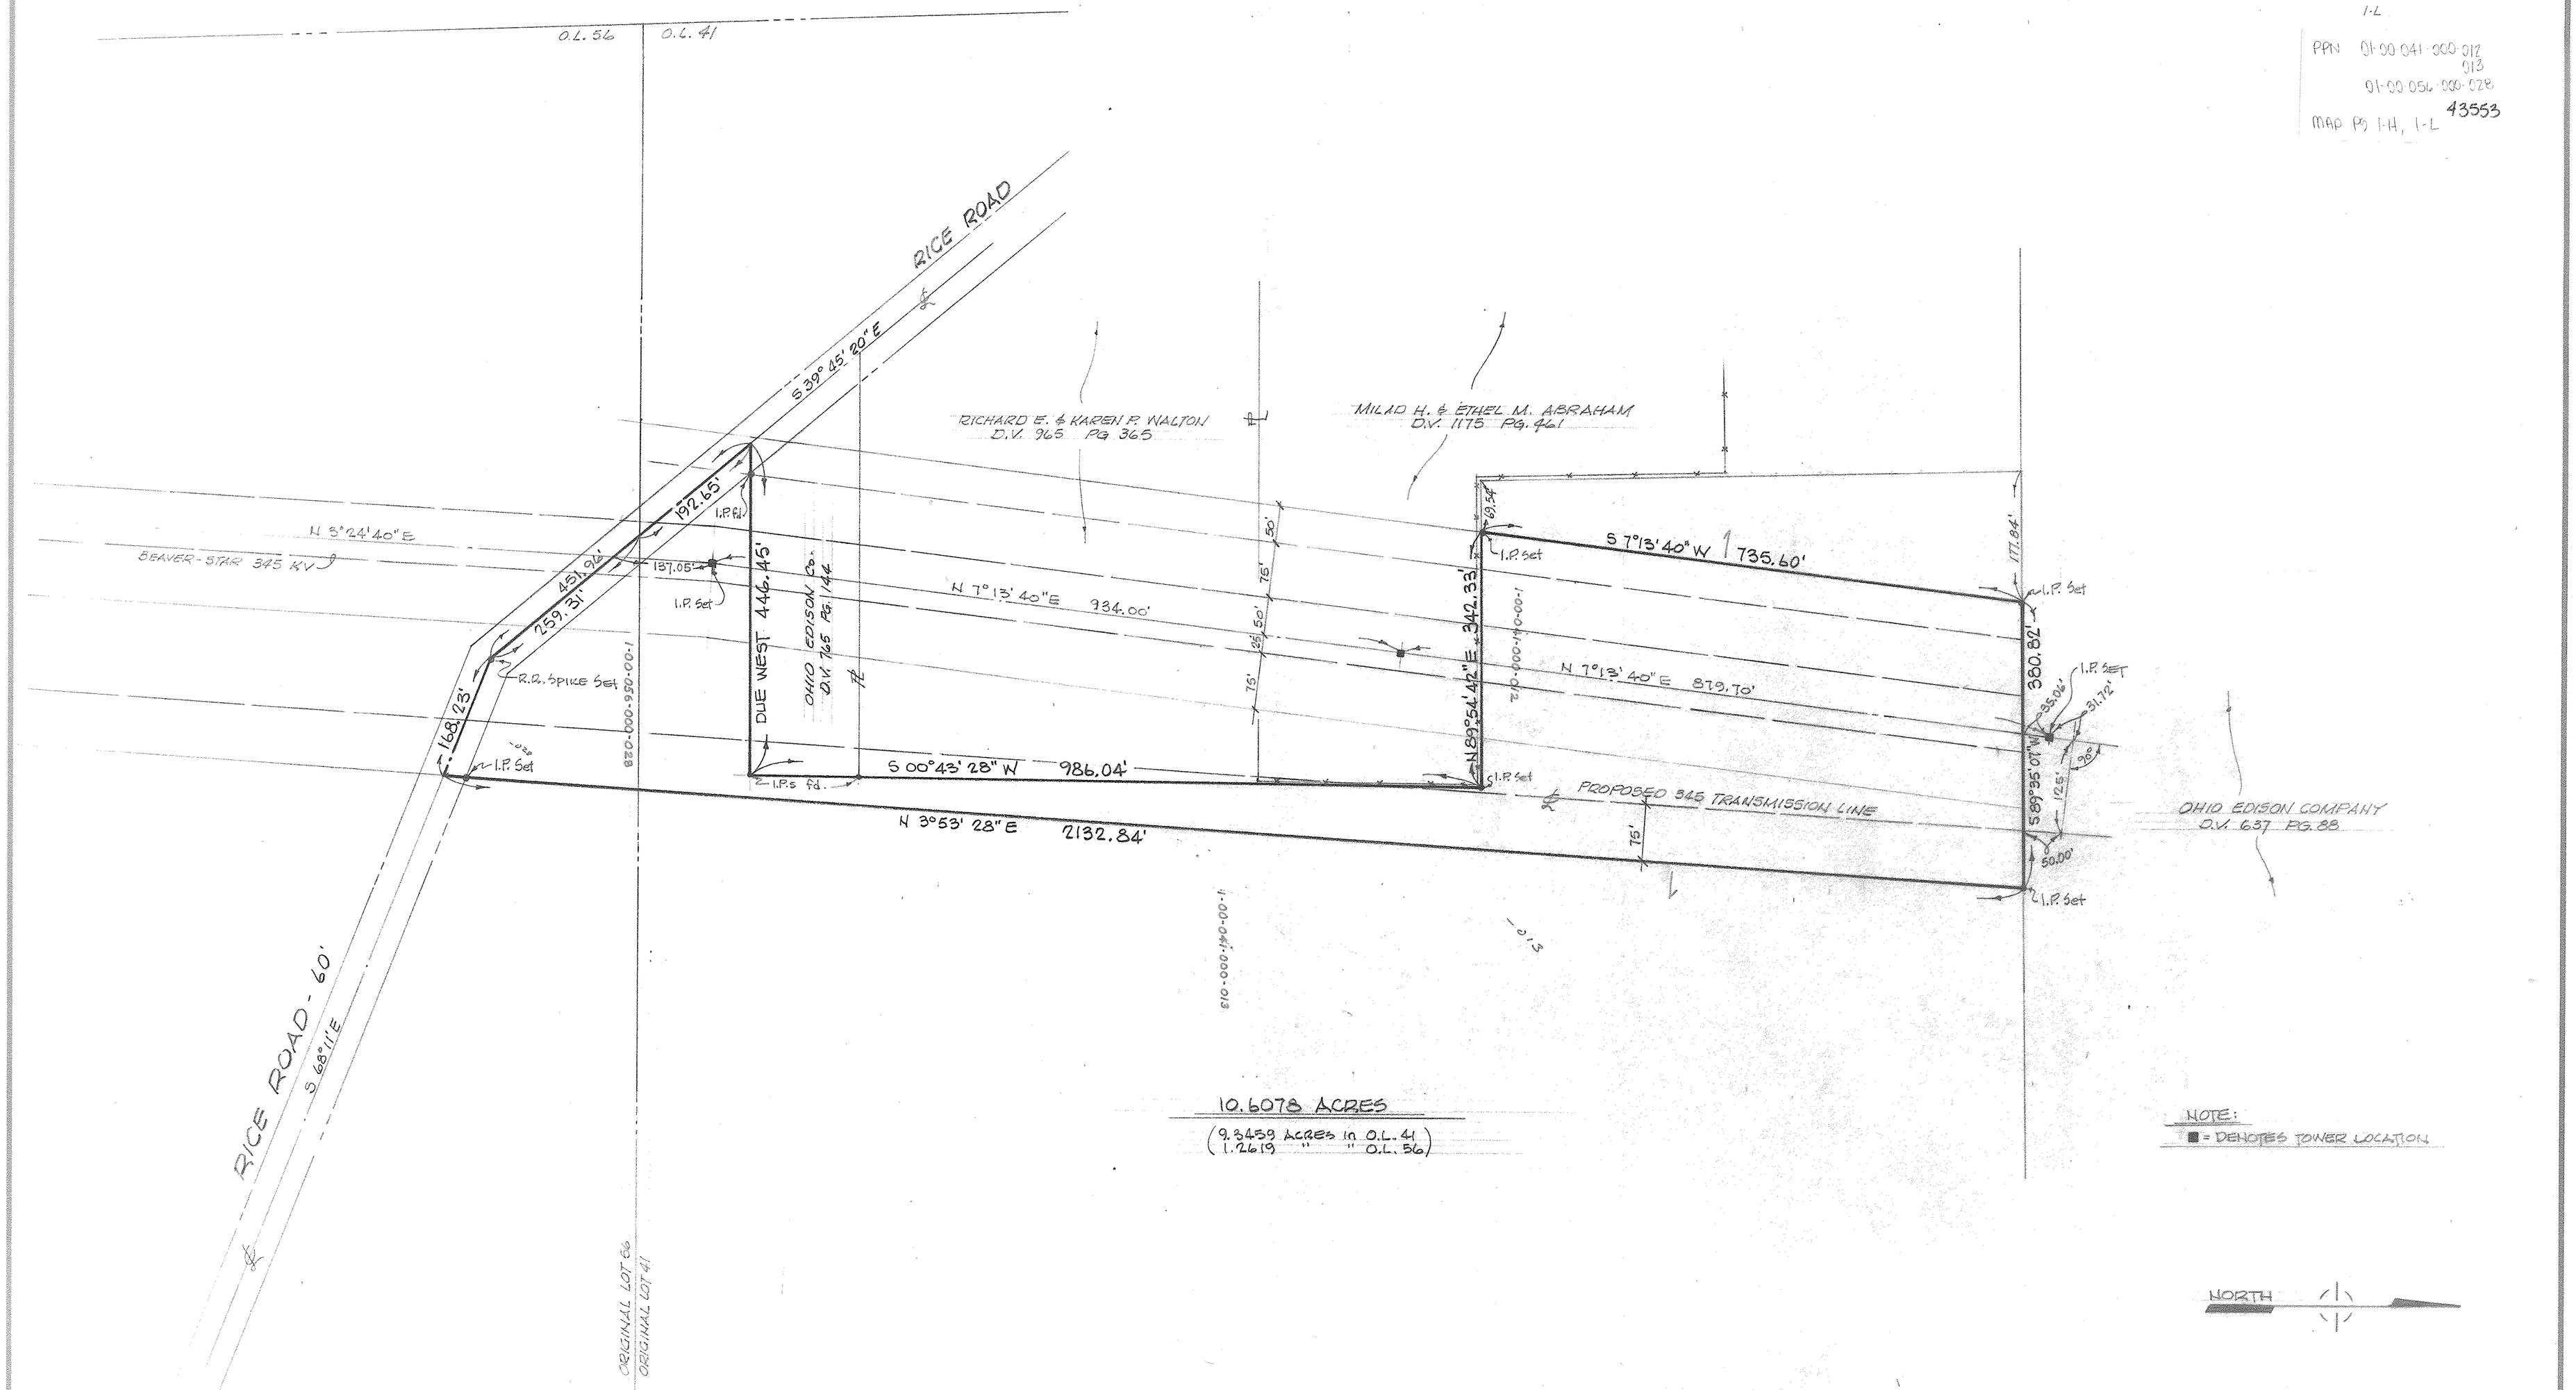

10.6078 ACRES
(9.3459 ACRES in O.L. 41
1.2619 " " O.L. 56)

NOTE:
■ = DENOTES TOWER LOCATION

MAP of SURVEY

PREPARED FOR OHIO EDISON COMPANY
PARTS of ORIGINAL BROWNHELM TWP. LOTS Nos. 41 & 56
TOWNSHIP of BROWNHELM, LORAIN COUNTY, OHIO

McGLINCHY AND ASSOCIATES
PROFESSIONAL ENGINEERS AND SURVEYORS
538 WEST BROAD ST. ELYRIA, OHIO

SCALE: 1" = 100' DRAWN BY: D. THOMAS
DATE: JULY 1979 JOB NO: 795275
SHEET 3 of 3

7-1 H-1

REV. AGREAGE 8-6-79