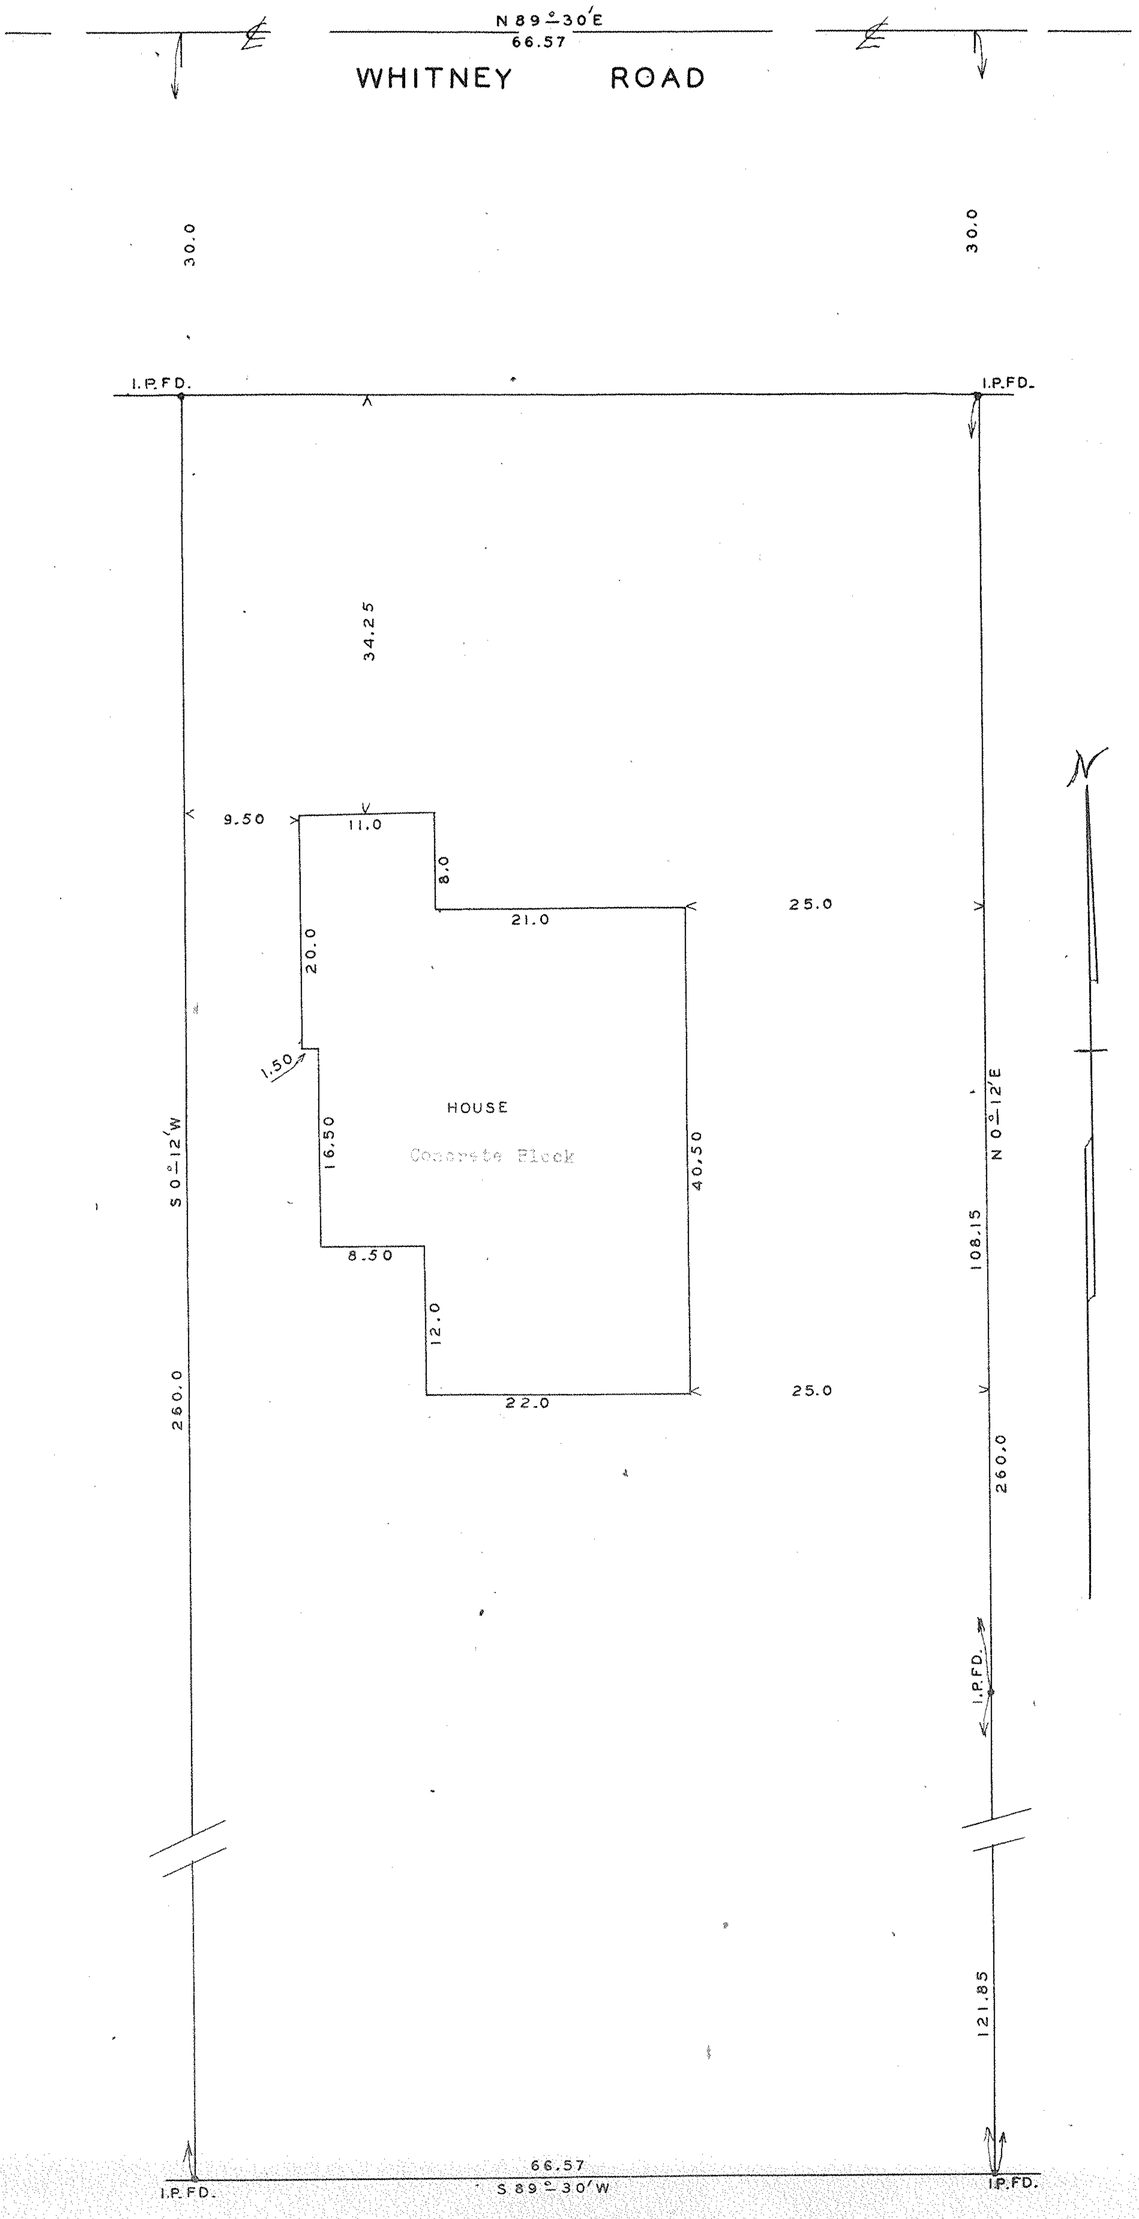

SURVEY AND LOCATION
FOR
BERK'S TITLE INSURANCE CO.
PREMISES OF
CLARENCE AND TERESITA HEINTZ
O. L. 74 LaGRANCE TOWNSHIP
LORAIN COUNTY, OHIO
SCALE 1" = 10' AUG. 25, 1964
J. W. WARDEN AND ASSOCIATES REG. SURVEYORS

Present occupants are Harlan and Doreen Rathwell
There have been no improvements in the last sixty days.

15-00-074-000-008
-014

MAP PG: 15-G