Chas. C. Bickel

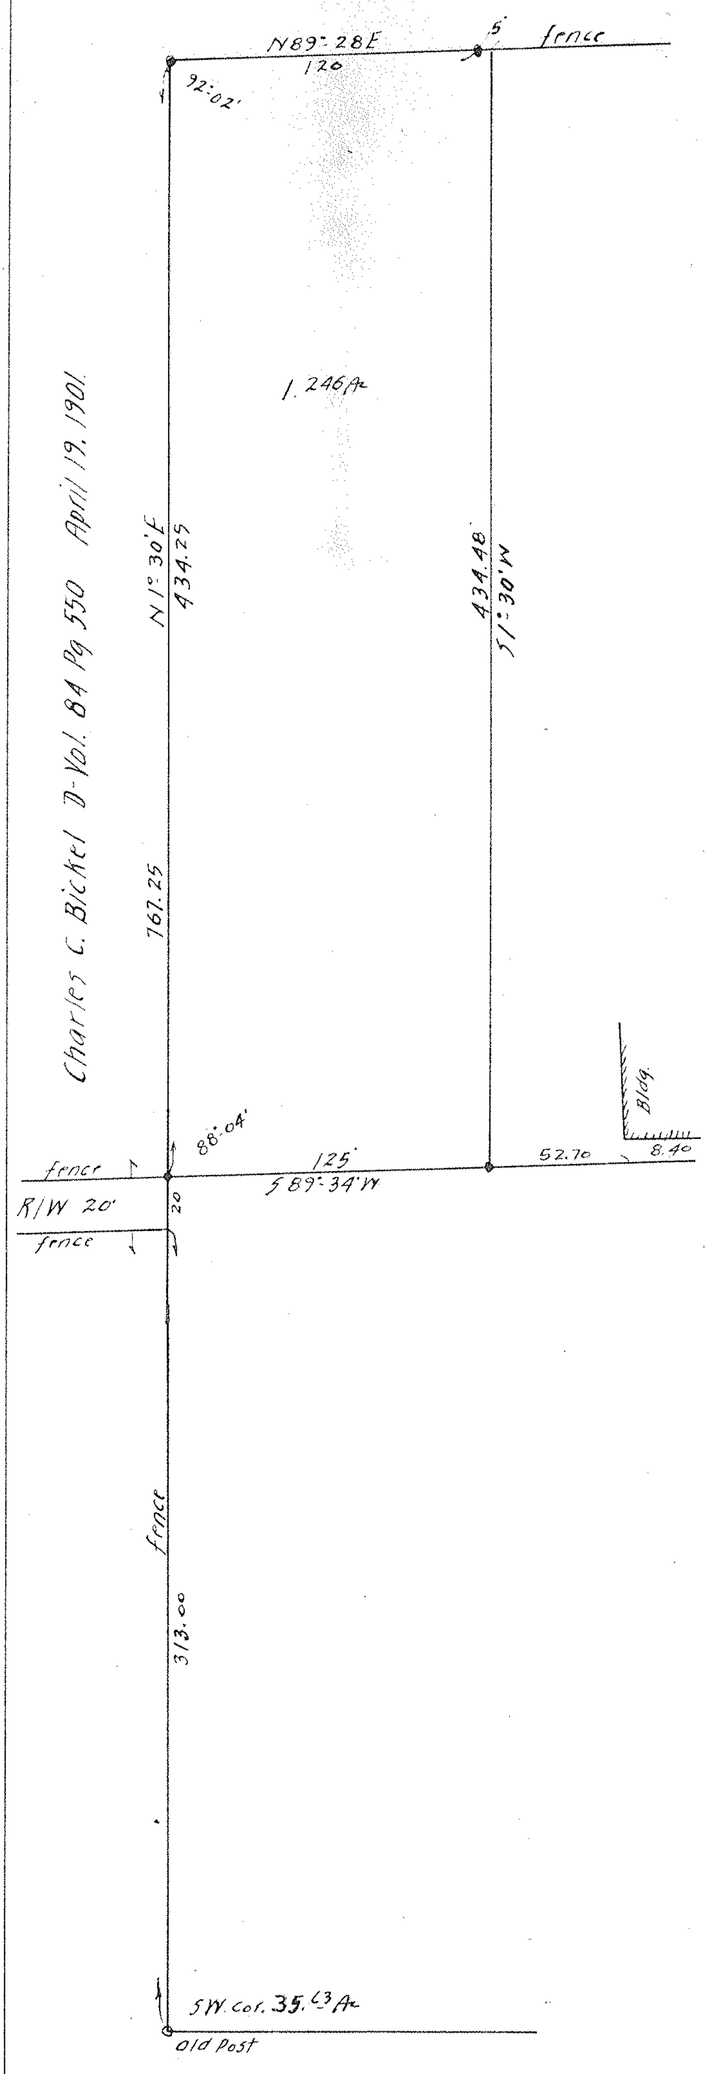

SURVEY FOR
THE MICHELL BROS. CO.
D-VOL 216 PG 357 MARCH 30, 1956
TRACT 11 LOT 6 CARLISLE TOWNSHIP
LORAIN COUNTY, OHIO
SCALE 1" = 50' SEPT. 7, 1956
J. W. WARDEN AND ASSOCIATES REG. SURVEYORS

Iron stakes set at all points indicated thus •

MAP PG: 13-C
13-11-006-000-014