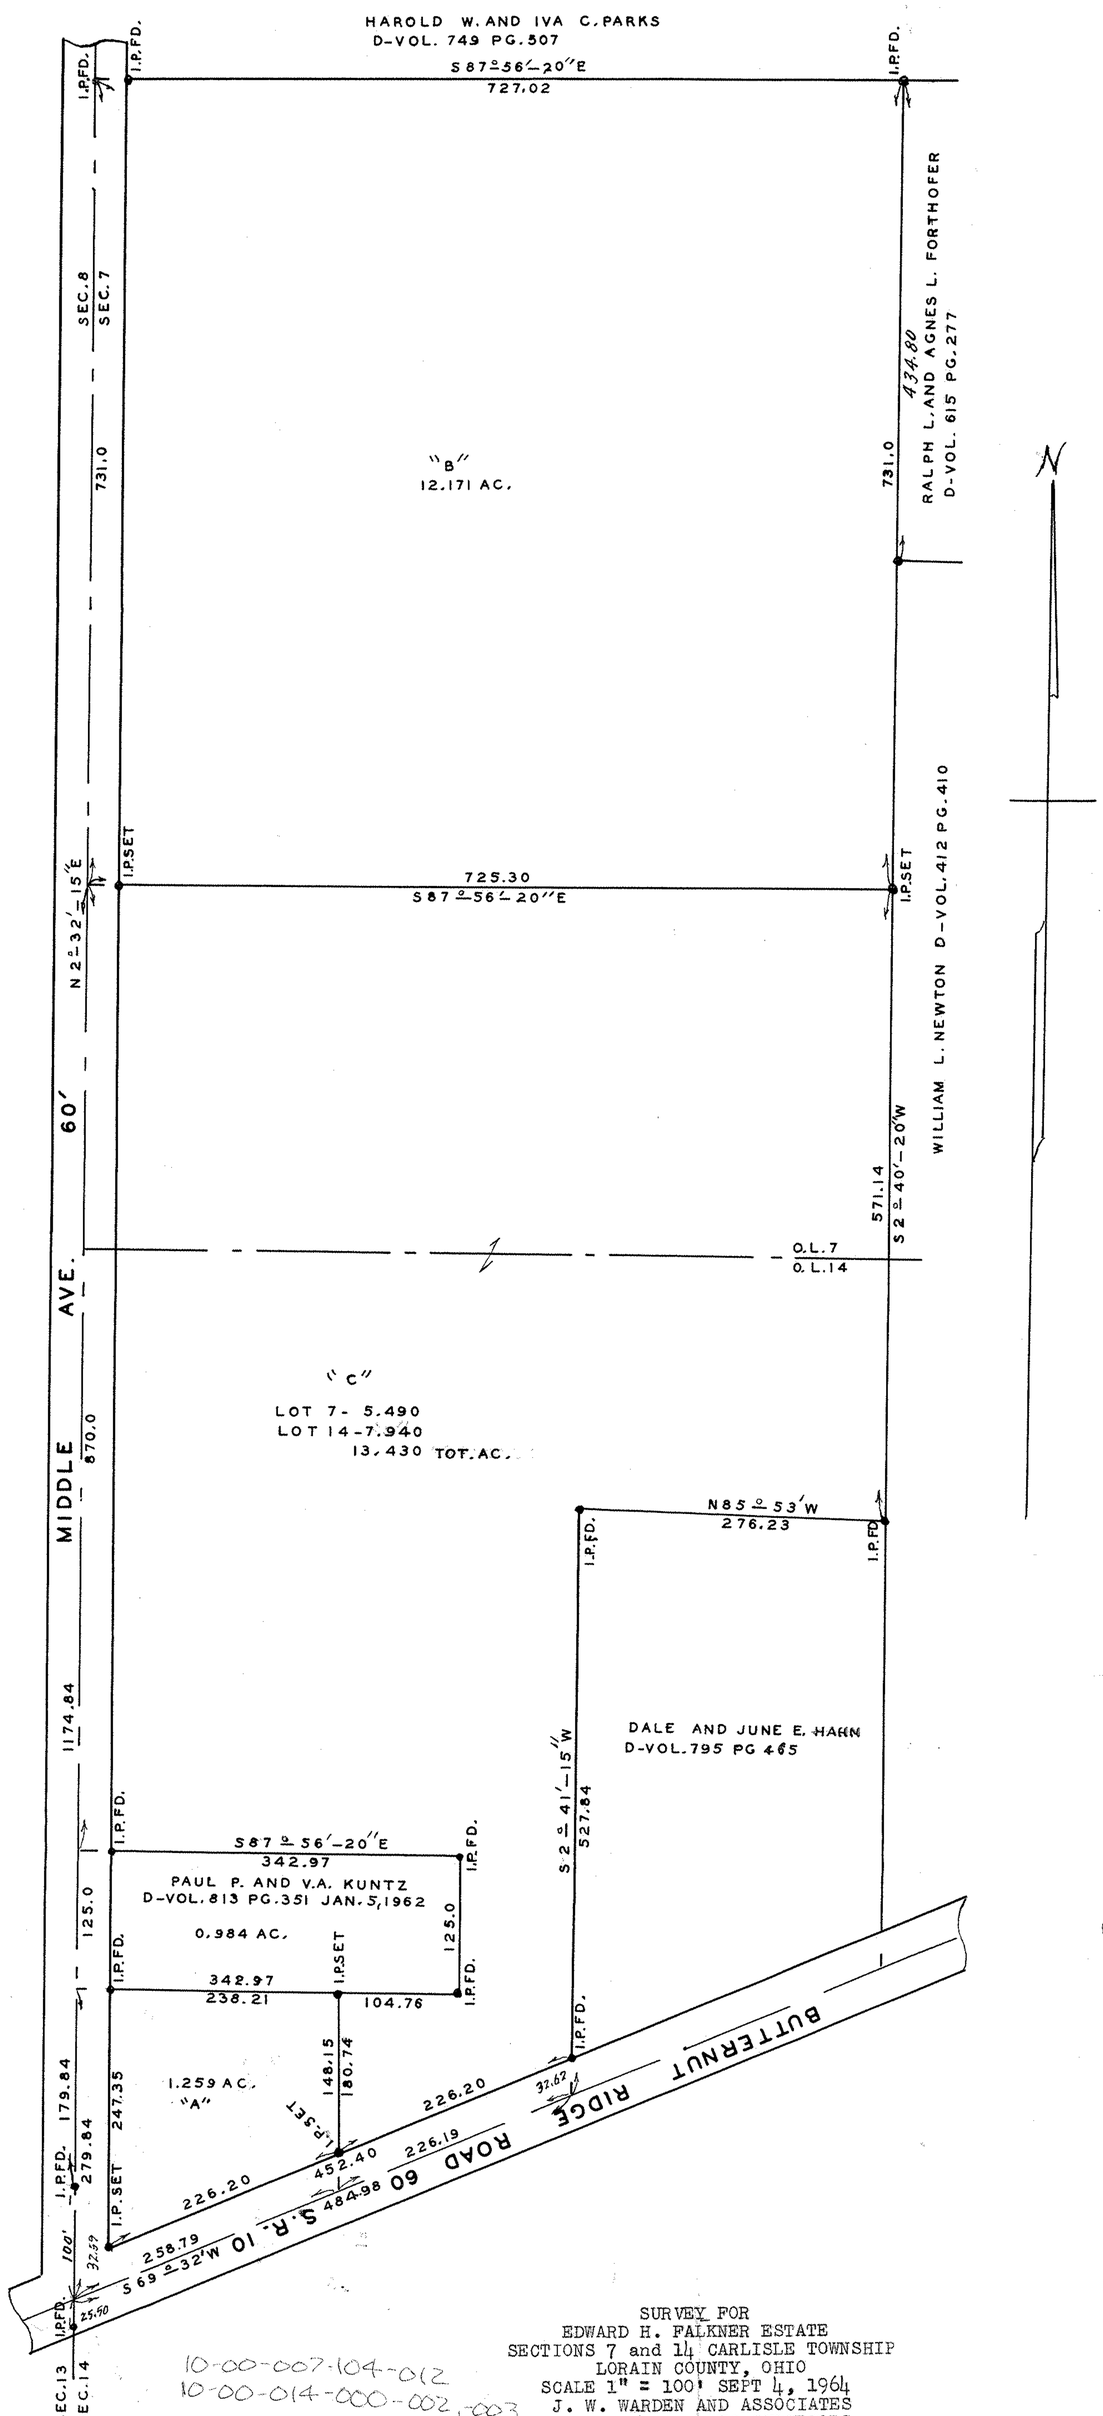

SURVEY FOR
EDWARD H. FALKNER ESTATE
SECTIONS 7 and 14 CARLISLE TOWNSHIP
LORAIN COUNTY, OHIO
SCALE 1" = 100' SEPT 4, 1964
J. W. WARDEN AND ASSOCIATES
REG SURVEYORS

10-00-007-104-012
10-00-014-000-002, 003
MAP PG: 10-00-014-A -051, -069
10-00-007-E