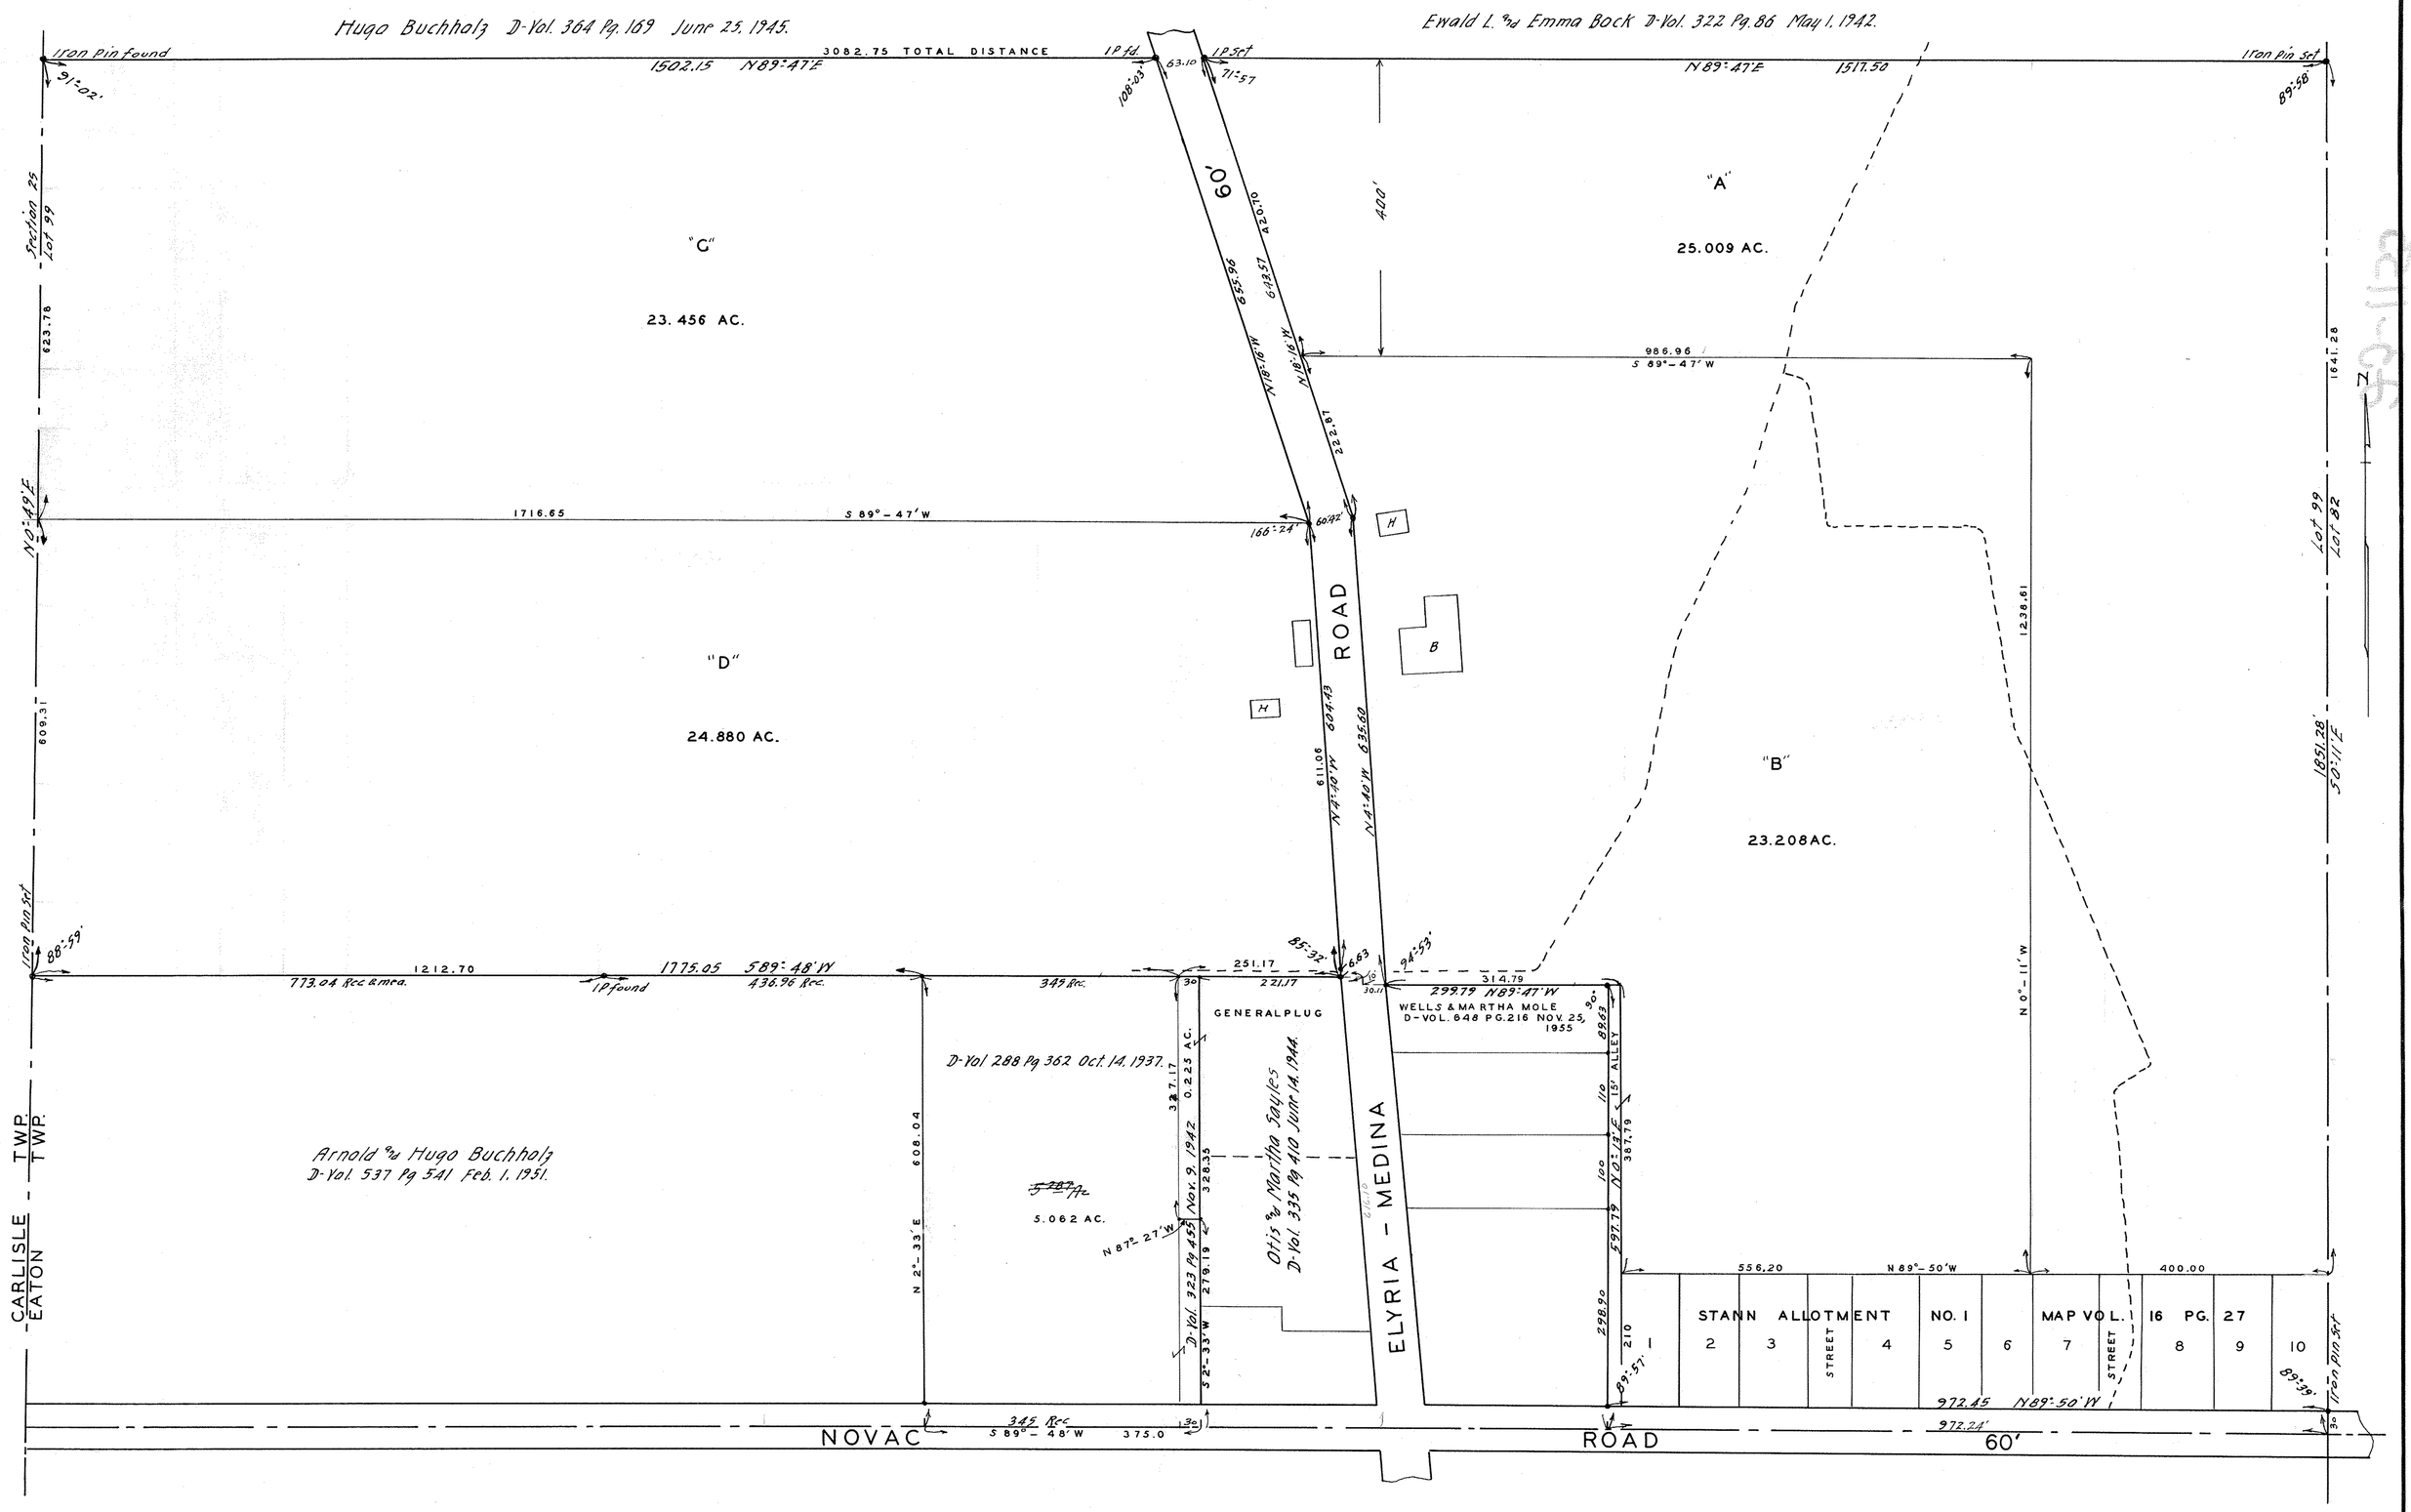

SURVEY FOR

JOSEPH AND JENNIE STANISLAWSKI

D-VOL. 269 PG. 307 DEC. 27, 1933

LOT 99 EATON TOWNSHIP

SCALE 1" = 100' FEB. 28, 1953

IRON PINS FOUND OR SET AT ALL POINTS MARKED THUS •

J. W. WARDEN AND ASSOCIATES REG. SURVEYOR'S

REVISED - MARCH 26, 1954 JUNE 21, 1961

MAY 9, 1966 101.615 AC.

TOTAL ACREAGE 107.343

11-00-099-000-388, -230, -236, -237, -303, -235, -234, -212

MAP REF: 11-00-099 A B

73-1155