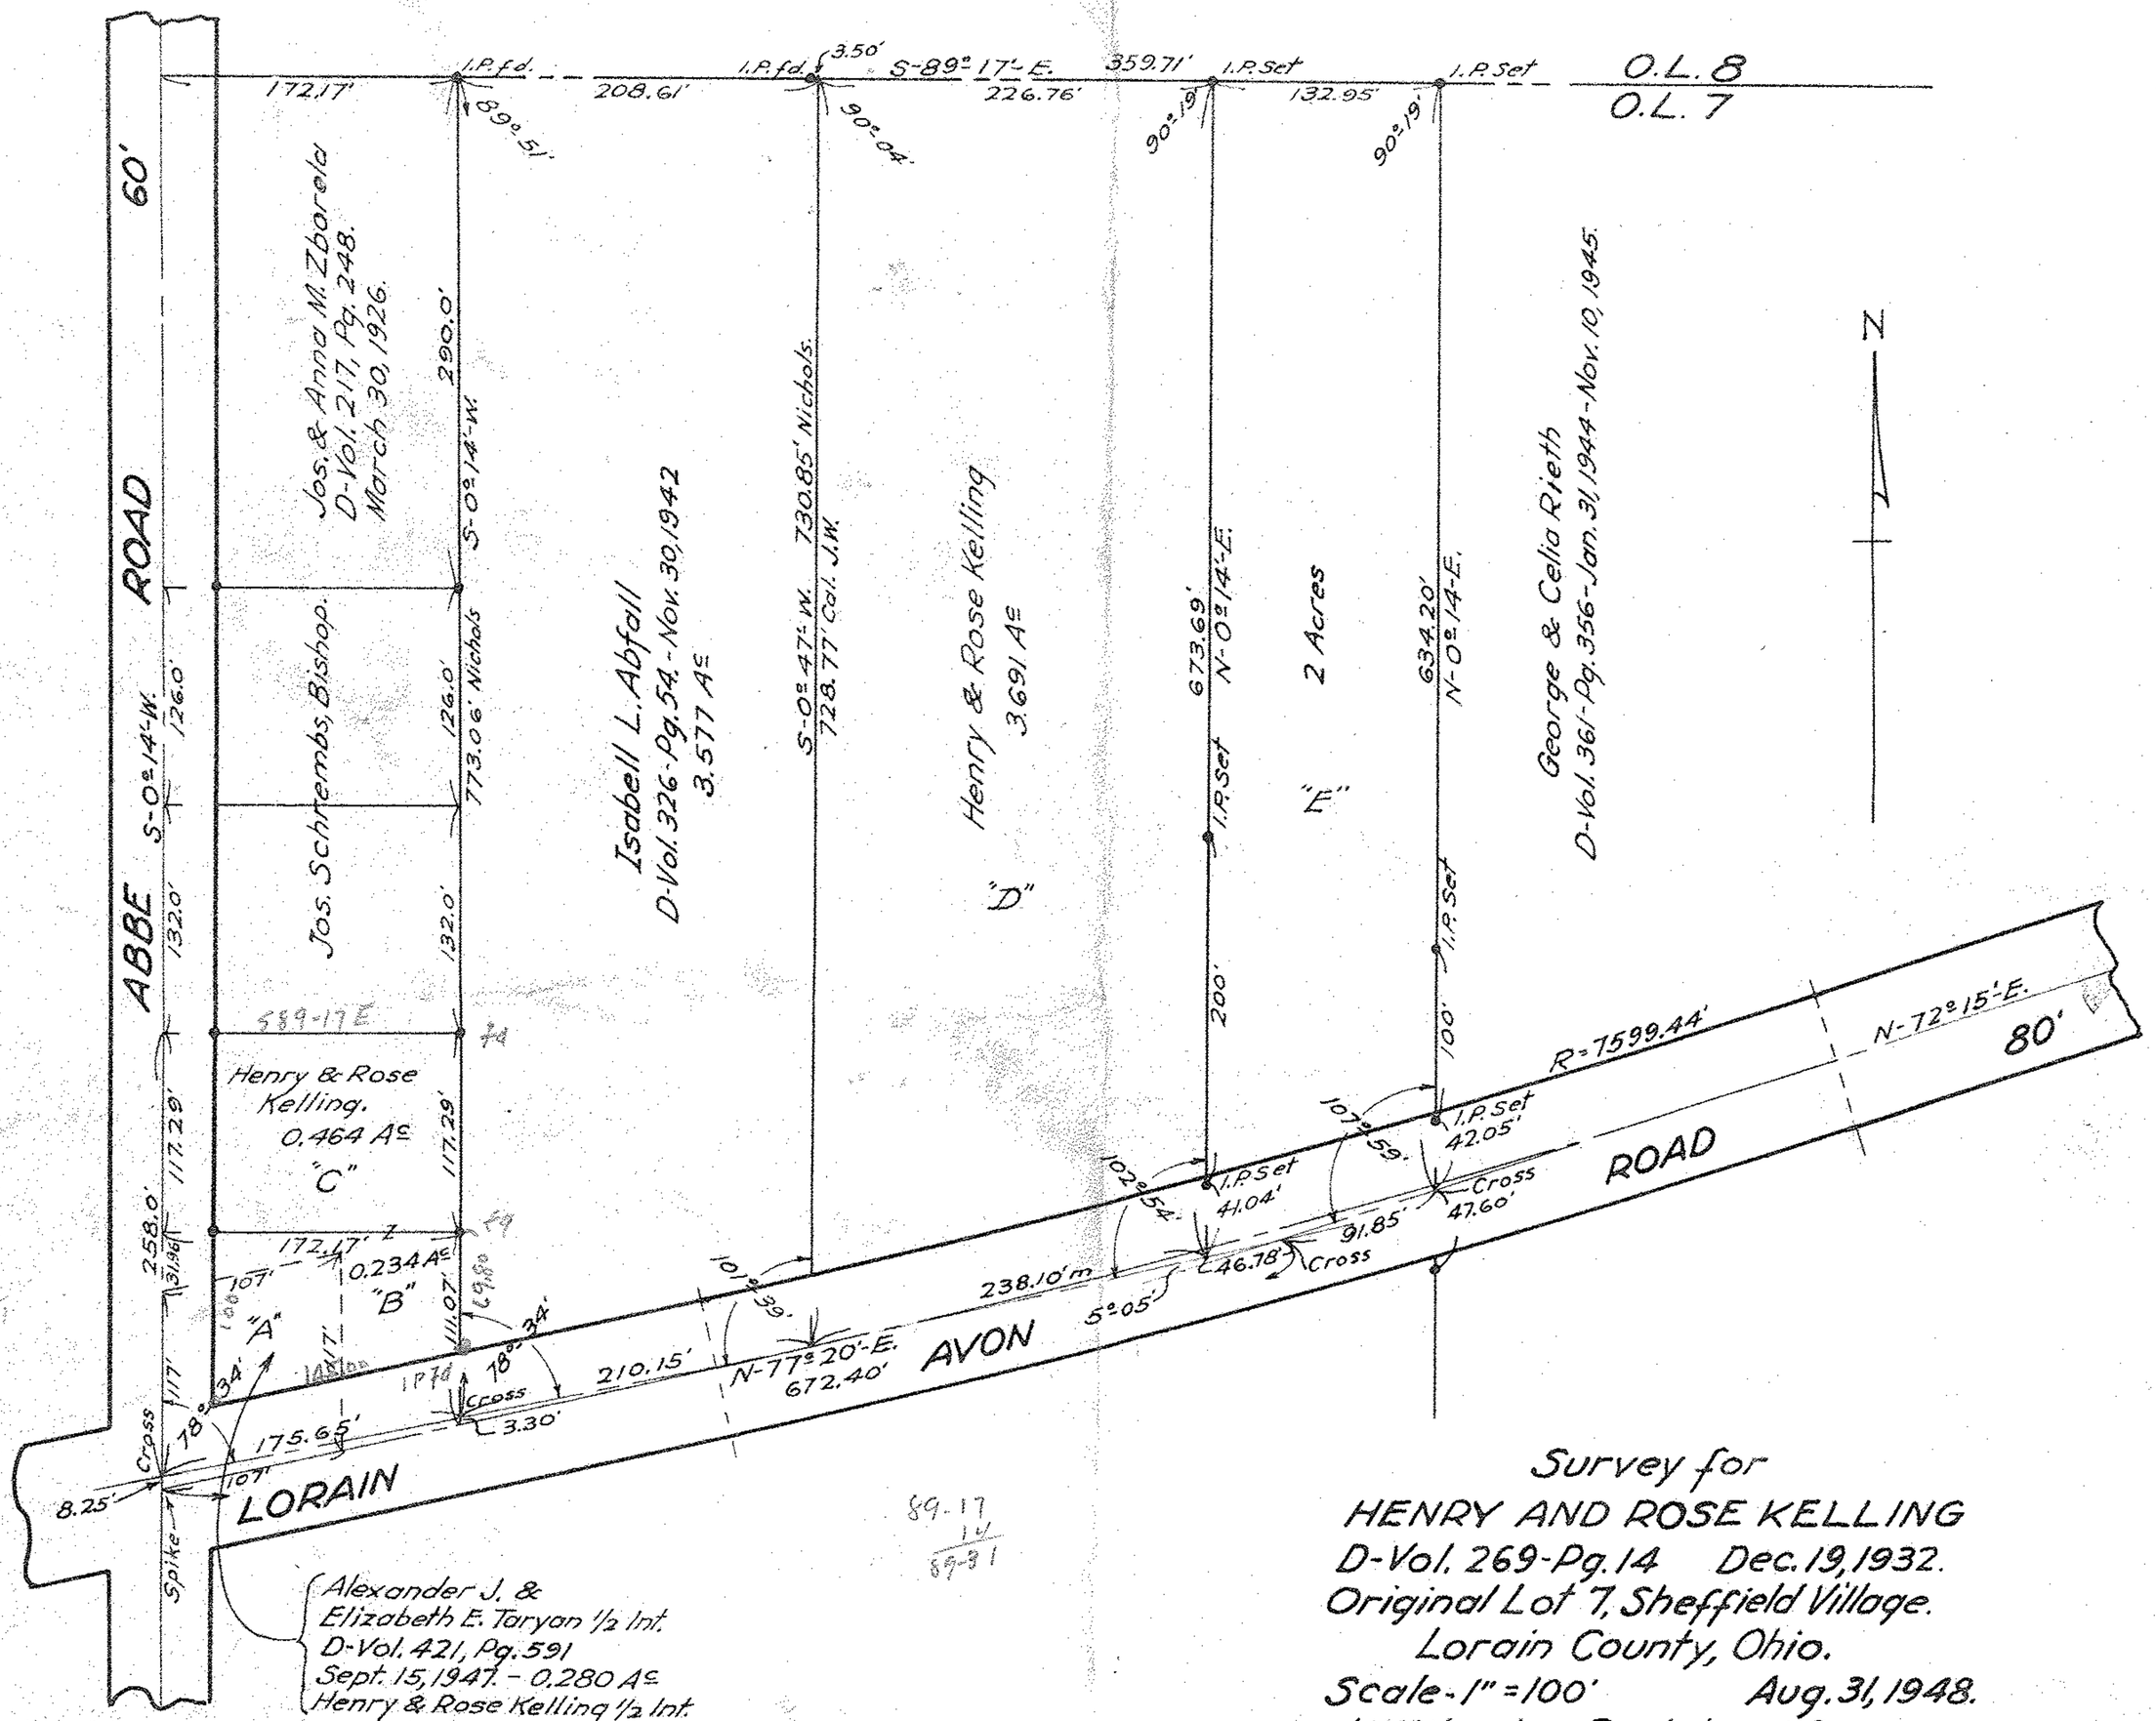

Survey for
HENRY AND ROSE KELLING
D-Vol. 269-Pg. 14 Dec. 19, 1932.
Original Lot 7, Sheffield Village.
Lorain County, Ohio.
Scale-1" = 100' Aug. 31, 1948.
J.W. Warden, Registered Surveyor.

Survey	6.669 Ac
Taxed	4.820 "
Not taxed -	1.849 "

Survey		Aud. Tax Dup. -	
A	= 0.280 Ac	A	= 0.280 Ac
B	= 0.234 "	B	= 0.000 "
C	= 0.464 "	C	= 0.170 "
D	= 3.691 "	D&E	= 4.370 "
E	= 2.000 "	Total	= 4.820 "
Total	= 6.669 "		

Julian Perkins
749-653 May 29 1959

89-17
1V
89-31

MAP PG: 3-00-007-A

03-00-007-101-031, -007, -009, -050
-059