(6)

SURVEY FOR
G. B. WHITEHILL
PREMISES OF
GEO. H. WILKINSON
D-VOL 773 PG 613 JUNE 2, 1960
O. L. 3 RIDGEVILLE TOWNSHIP
N. RIDGEVILLE CITY, LORAIN CO. OHIO
SCALE 1" = 50' APRIL 15, 1963
J. W. WARDEN AND ASSOCIATES REG. SURVEYORS

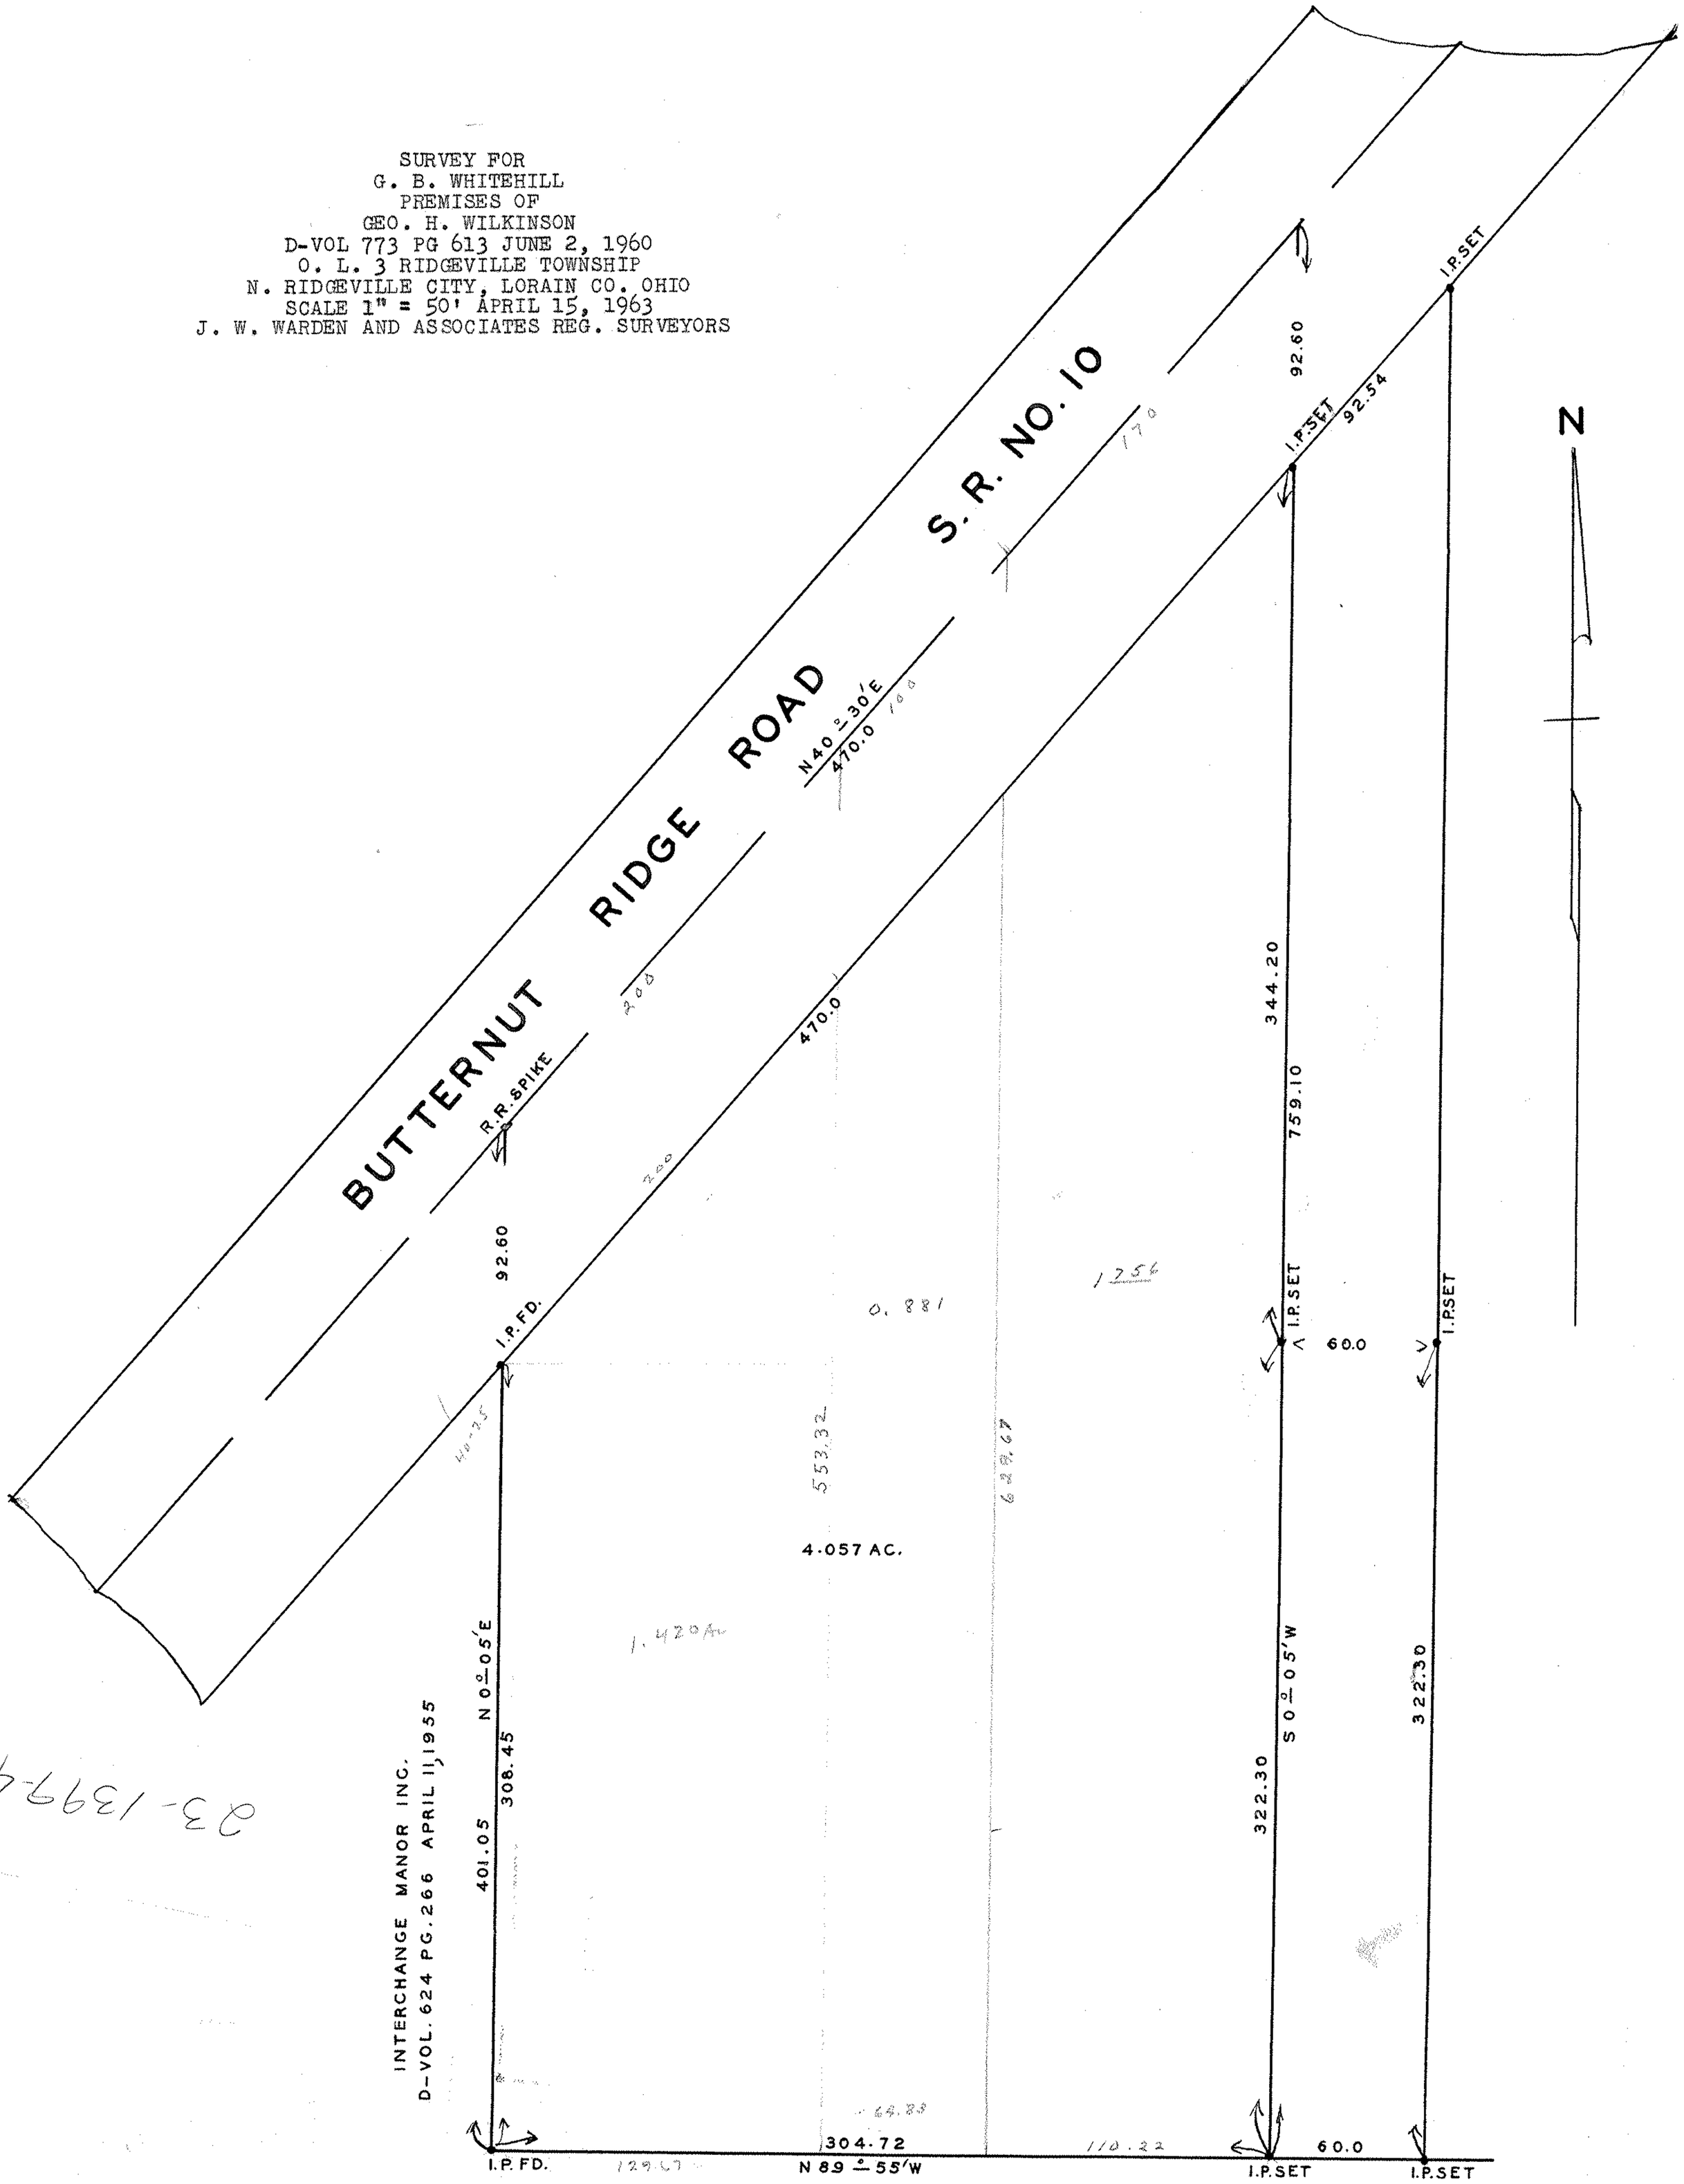

03-1379-4

MAP PLY: 7-00-003-A
07-00-003-102-021