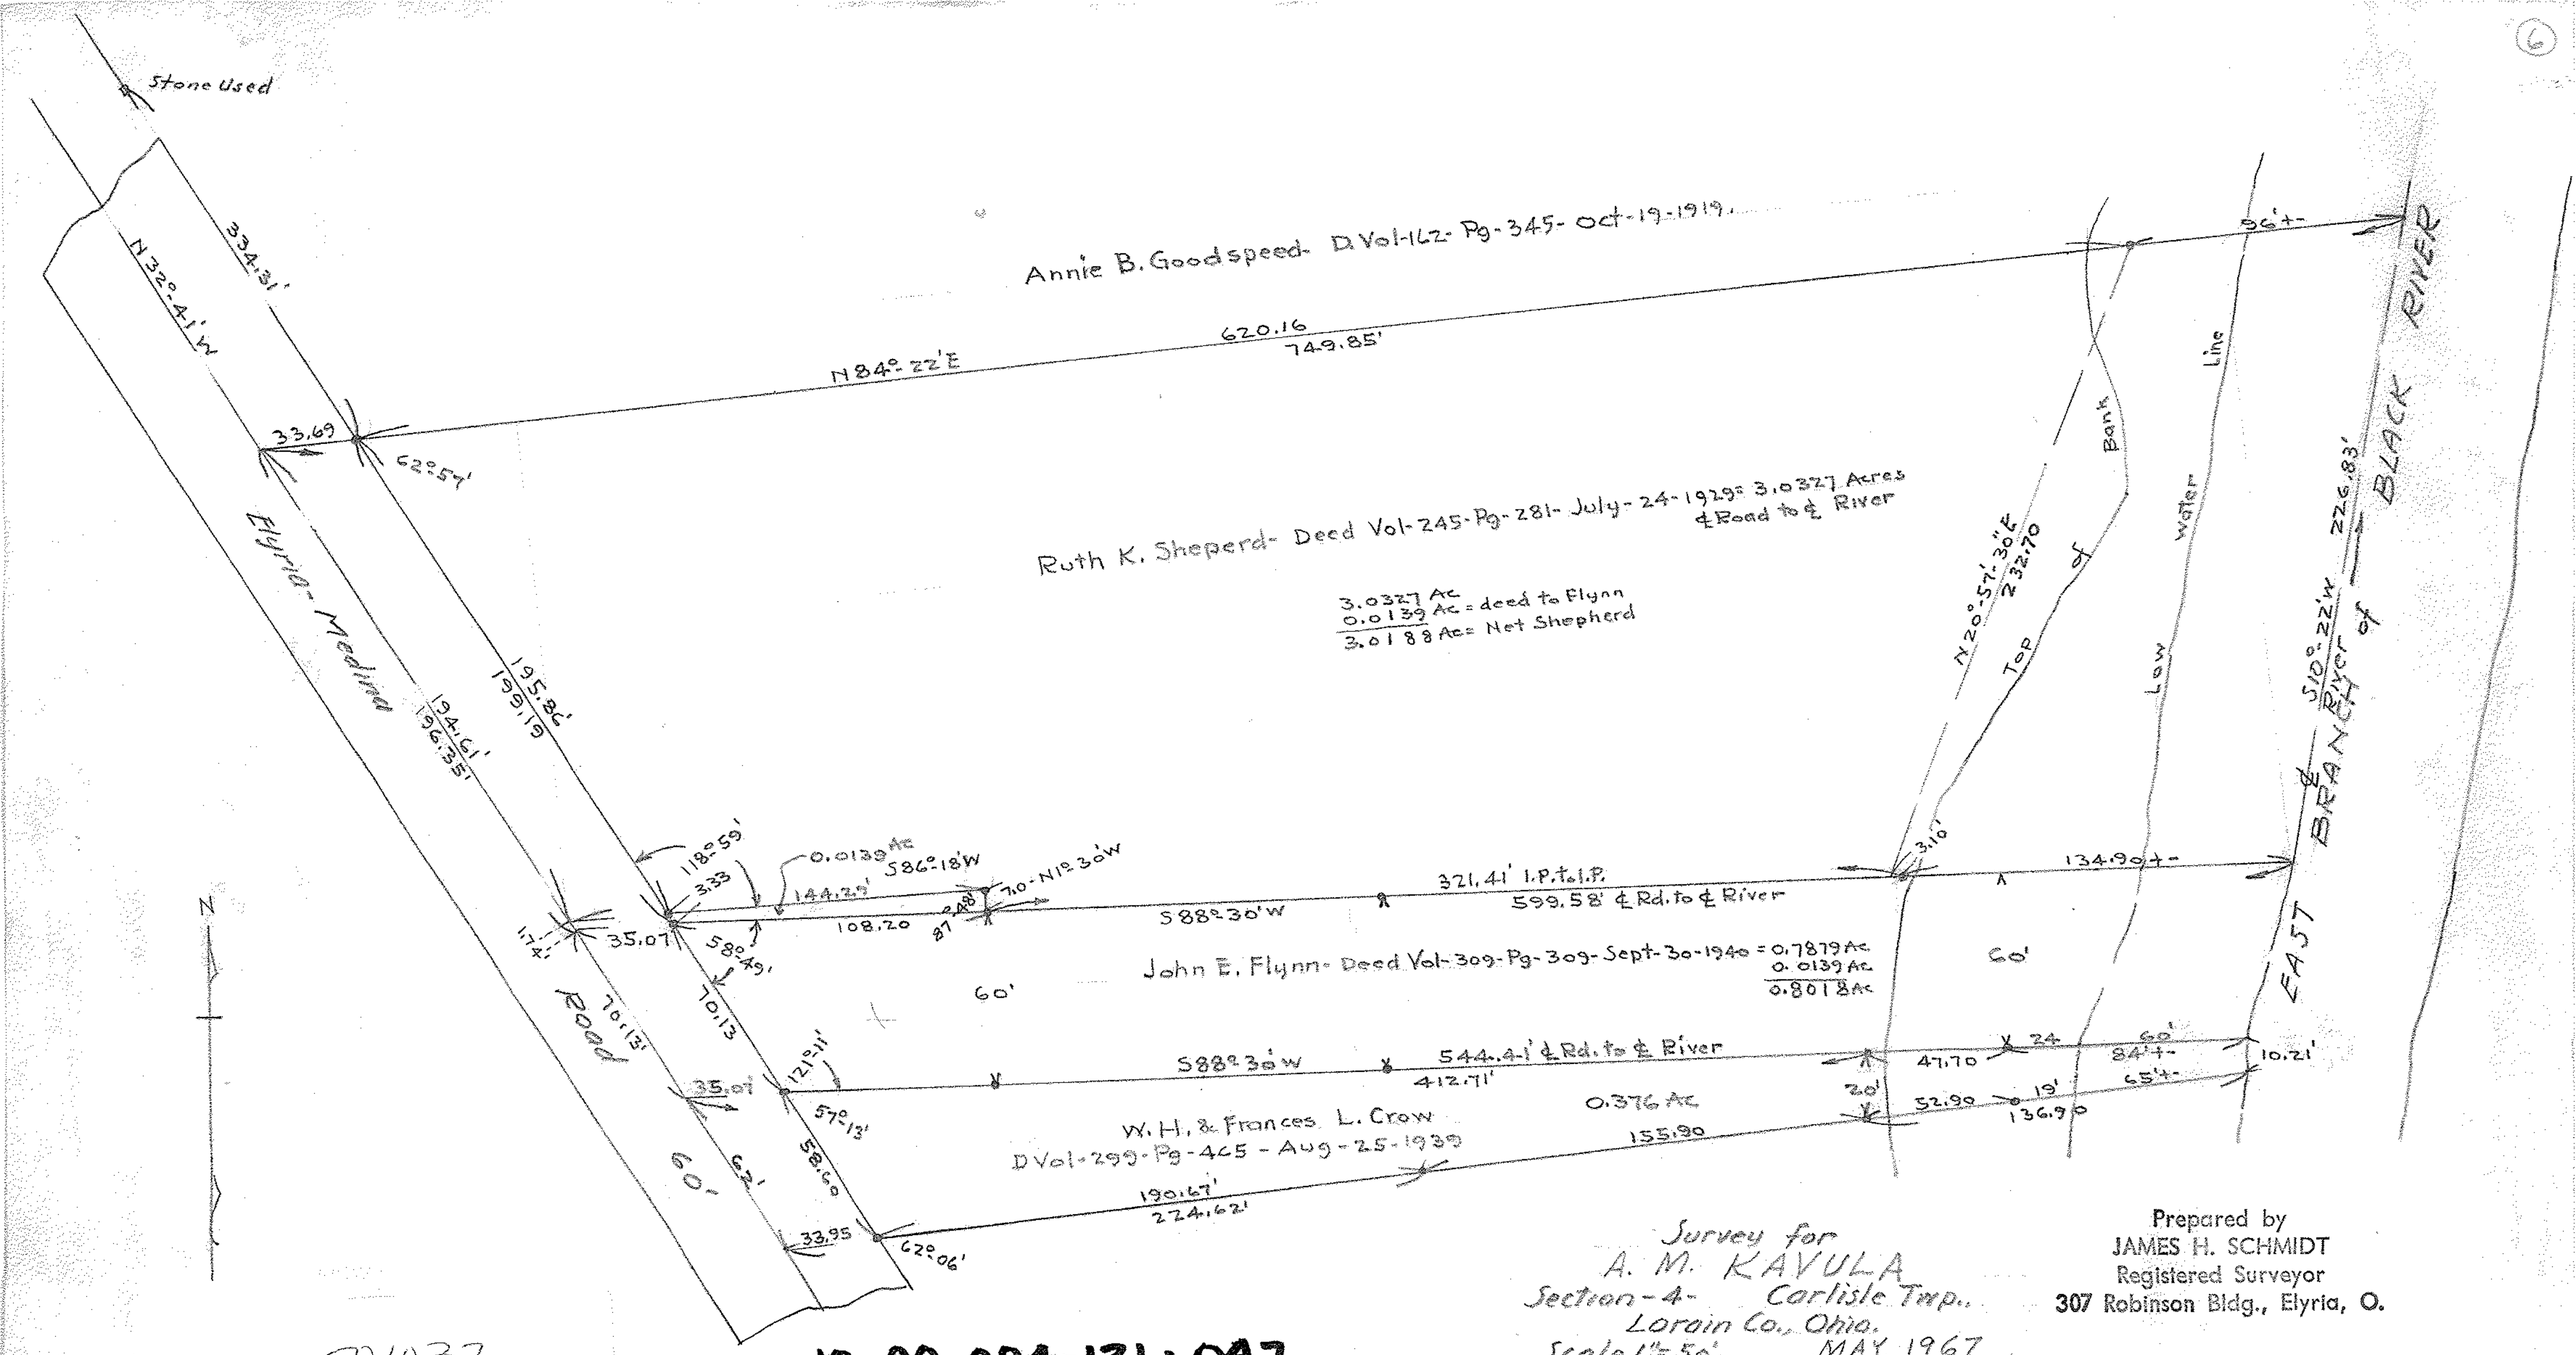

Survey for
A. M. KAVULA
Section-4- Carlisle Twp.,
Lorain Co., Ohio.
Scale 1"=50'. MAY, 1967

Iron Pins set or found at all points marked thus •

Prepared by
JAMES H. SCHMIDT
Registered Surveyor
307 Robinson Bldg., Elyria, O.

501037

3

10-00-004-131-047
-048

10-00-004-H