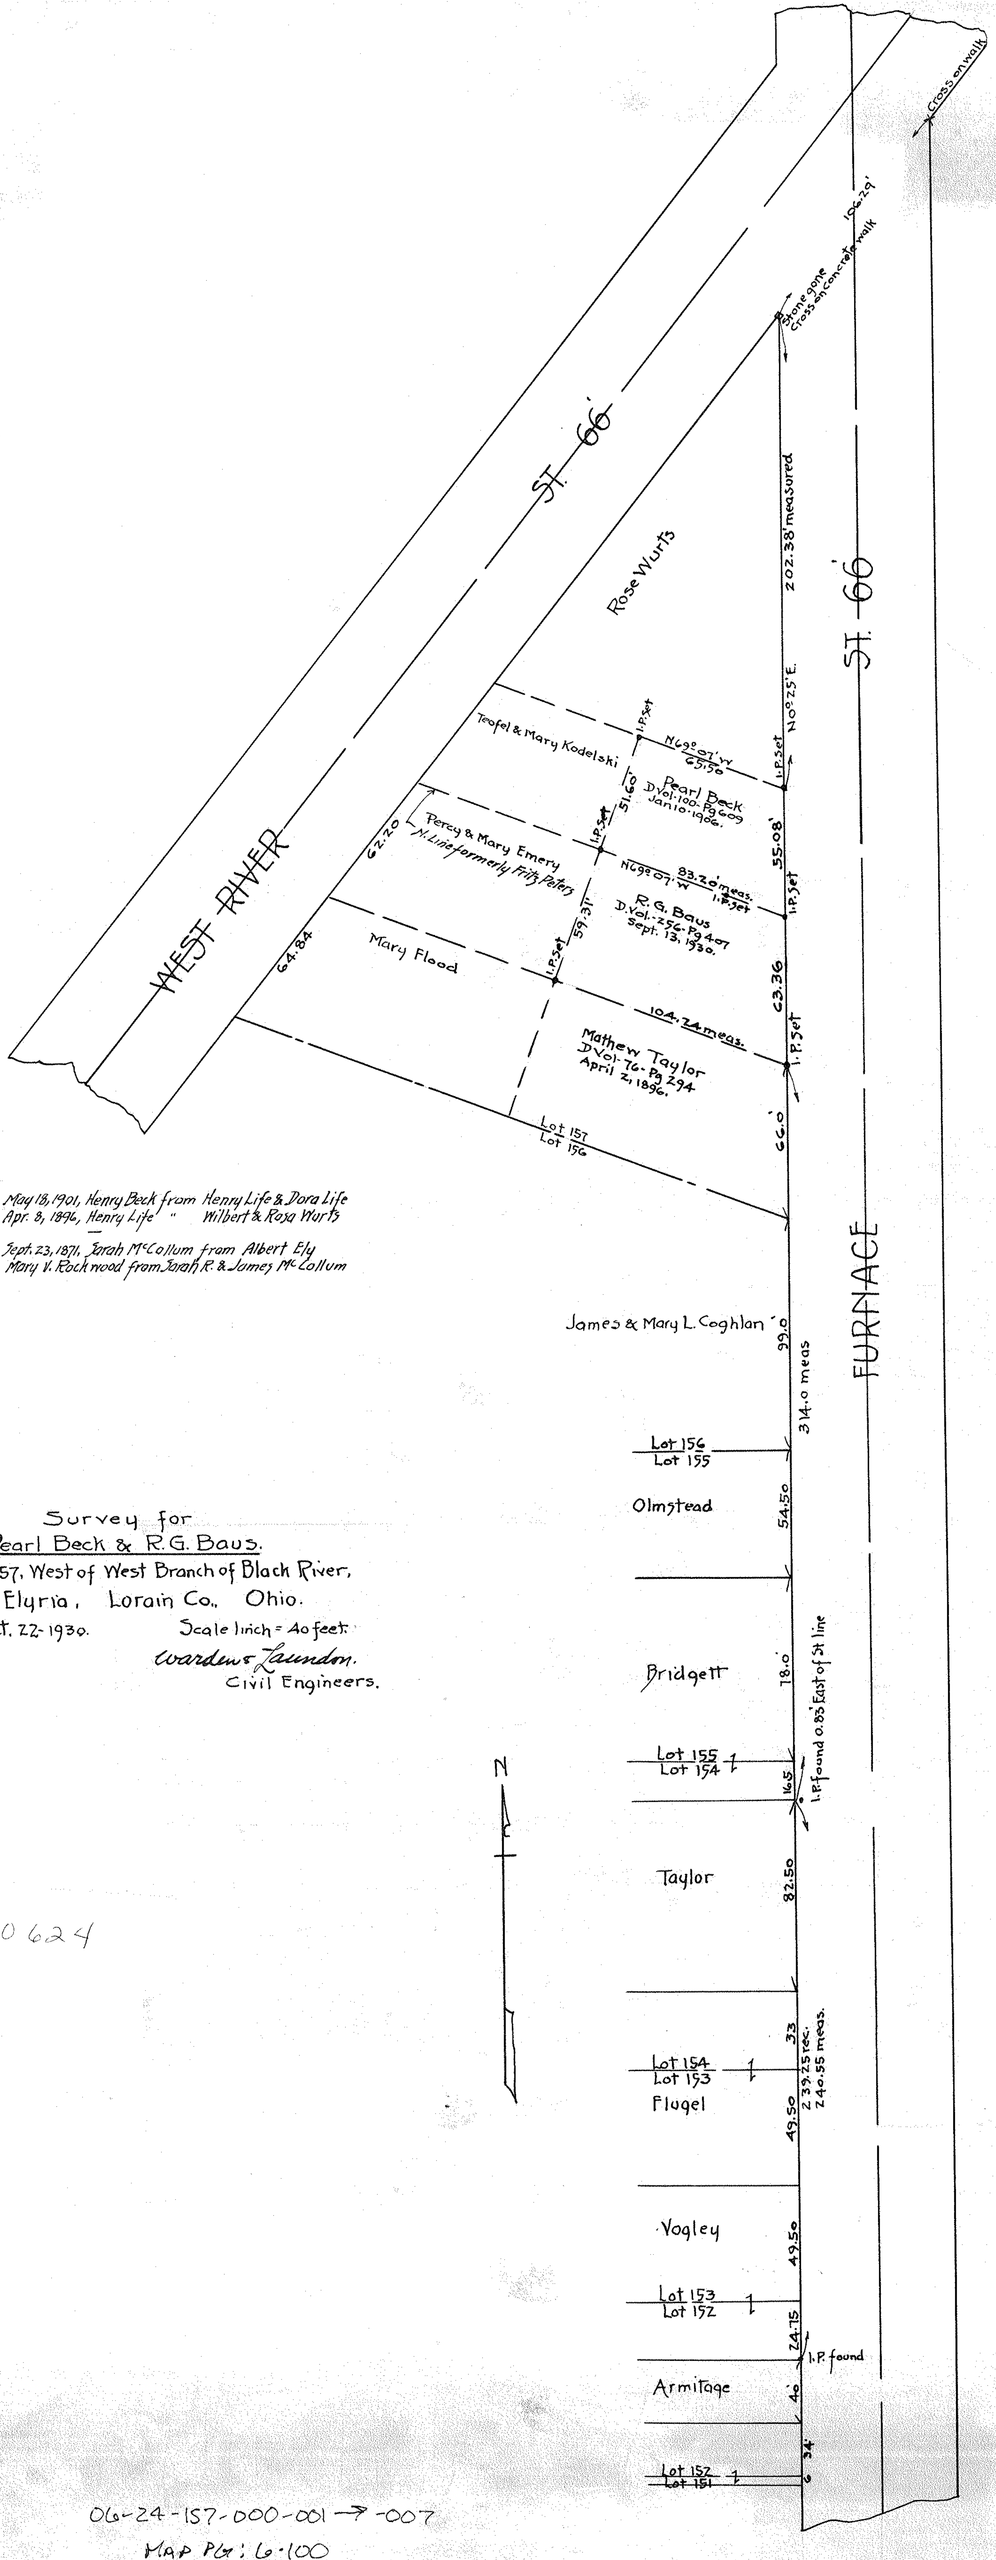

{ D. Vol 84-Pg 637- May 18, 1901, Henry Beck from Henry Life & Dora Life
" " 75- " 119- Apr. 8, 1896, Henry Life " Wilbert & Rosa Wurts

{ D. Vol. 33-Pg 254- Sept. 23, 1871, Jarah McCollum from Albert Ely
" " 46- " 157- Mary V. Rockwood from Jarah R. & James McCollum

Survey for
Pearl Beck & R.G. Baus.
Lot 157, West of West Branch of Black River,
Elyria, Lorain Co., Ohio.
Oct. 22-1930. Scale 1 inch = 40 feet.
Wardens & Saunders.
Civil Engineers.

600624

06-24-157-000-001 → -007
MAP PG: 6-100