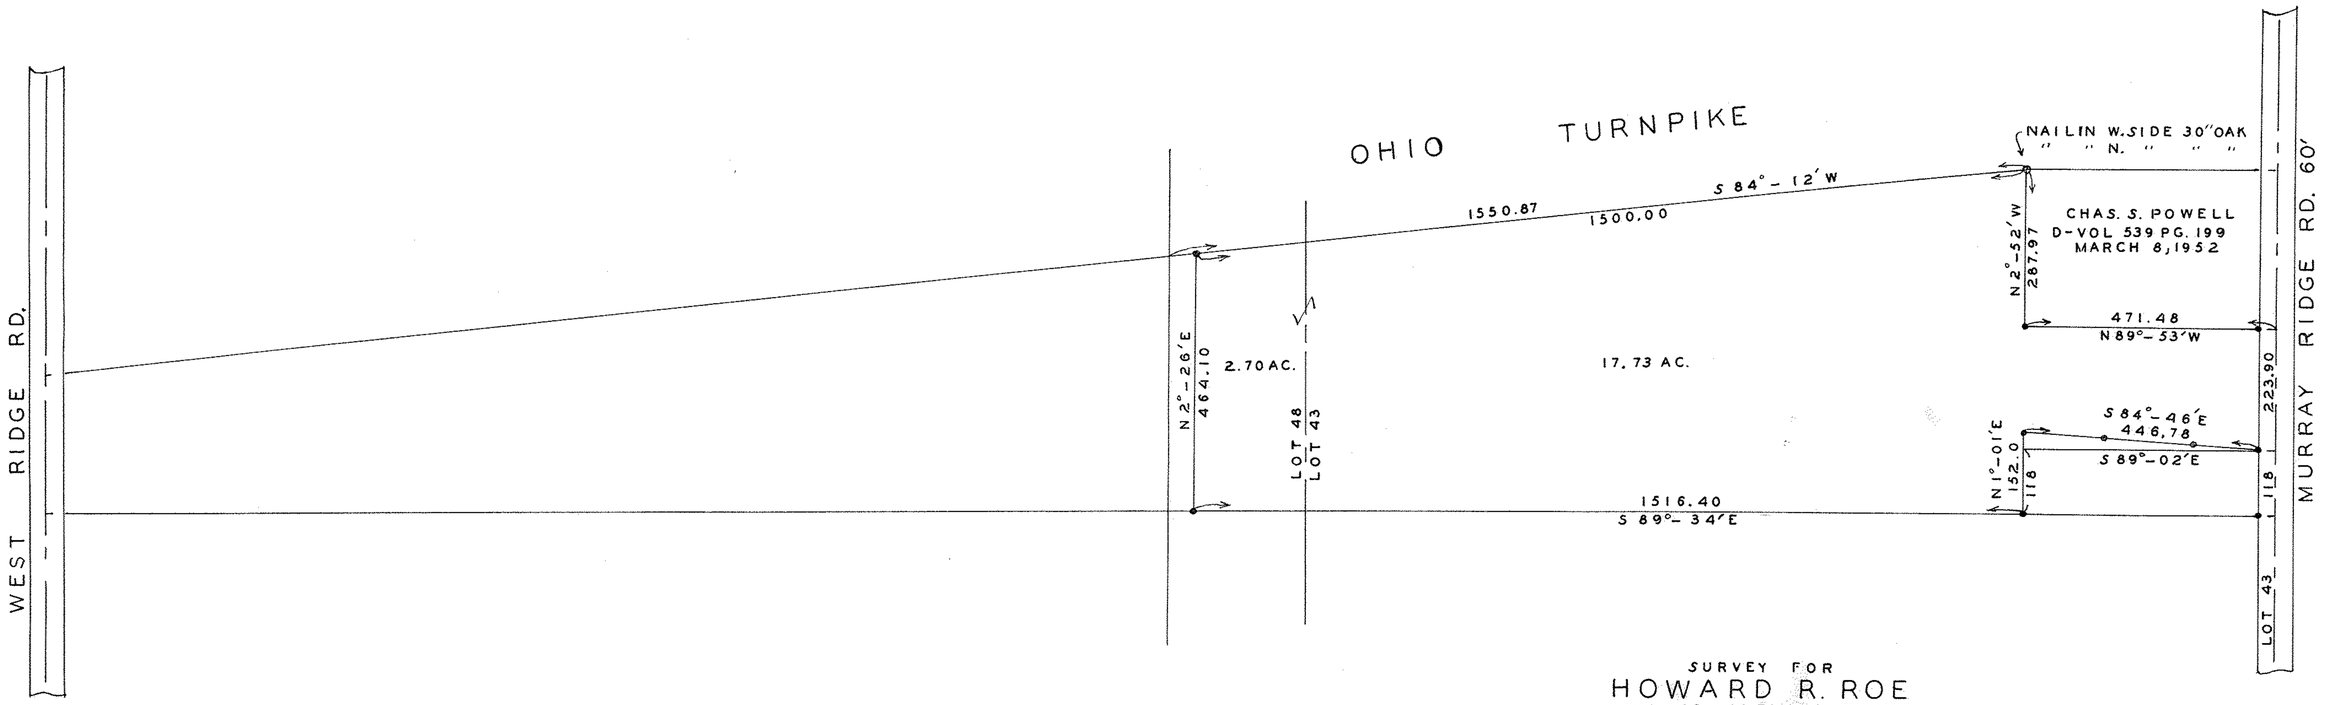

SURVEY FOR
HOWARD R. ROE
O. L. 43 – 48 ELYRIA TWP.
LORAIN COUNTY, OHIO
SCALE 1" = 200' MAY 31, 1962
J. W. WARDEN AND ASSOCIATES REG. SURVEYORS

• INDICATES IRON STAKES

600 165A

06-24-043-101-004, -006, -012, -013
06-24-048-000-023

MAP PG: 6-57
6-58

P-12