05-00-014-000-020 04-00-014-B
-017-000-006
-057 05 F 5

P 1 of 1

Survey for
GEORGE H. & KATHERINE RUTH.

600 616

Original Lots 14-15-26-27. Amherst Twp.,

Lorain Co., Ohio.

Scale 1 inch = 200 ft. June 9, 1930.
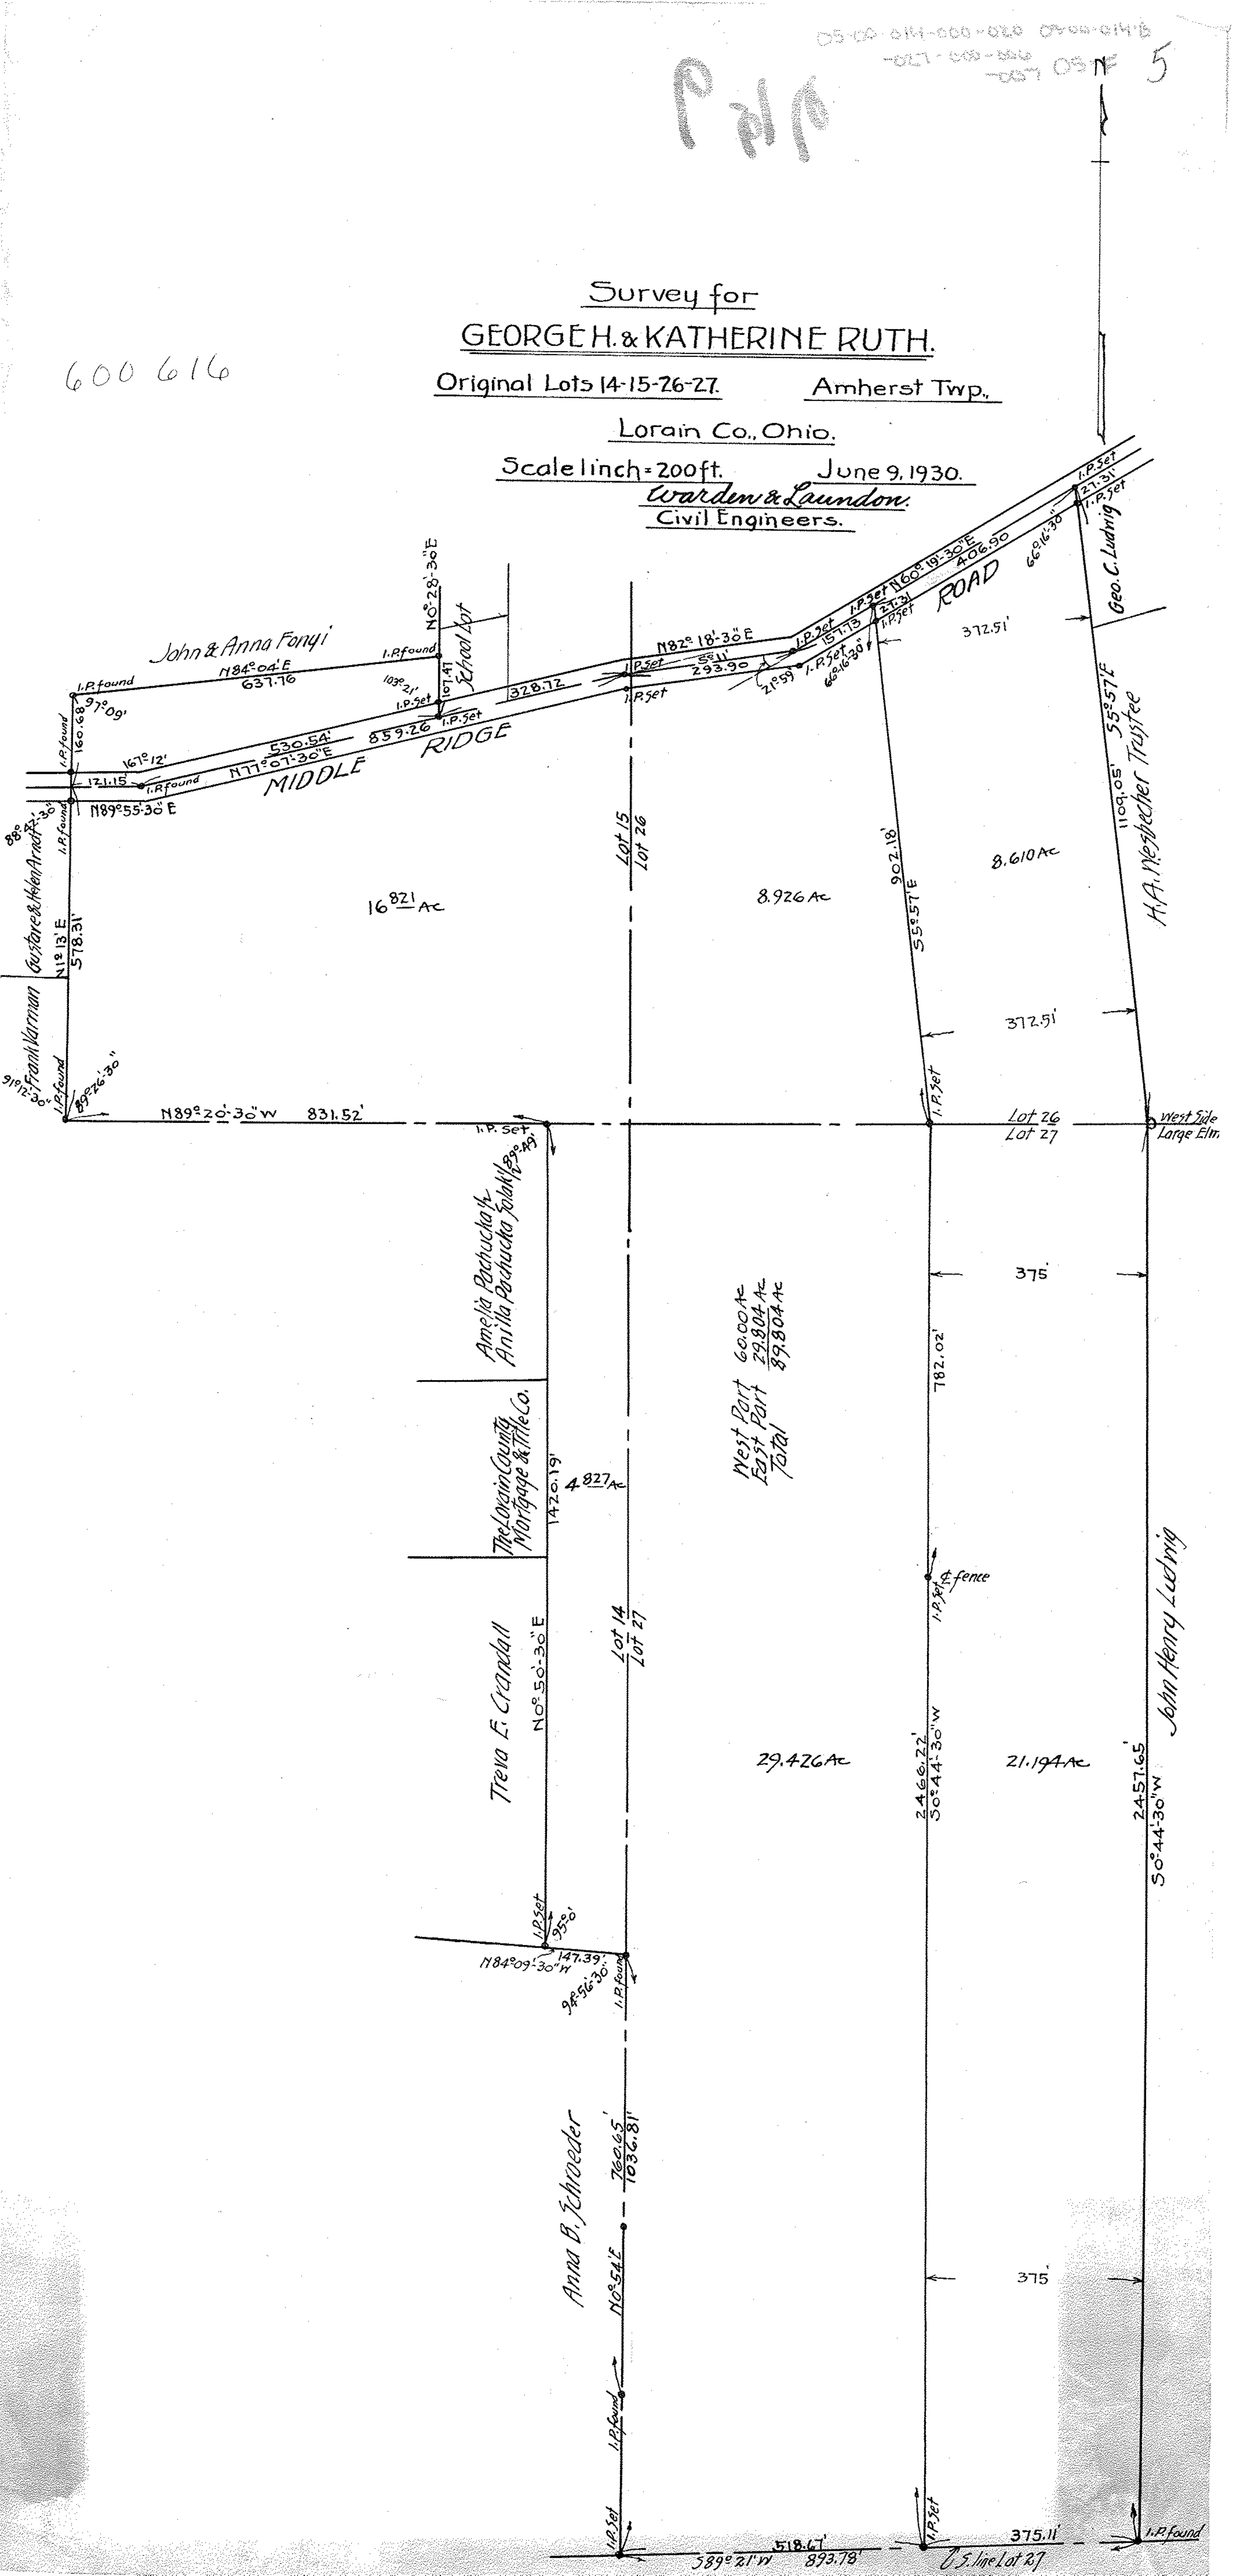
Warden & Laundon.
Civil Engineers.