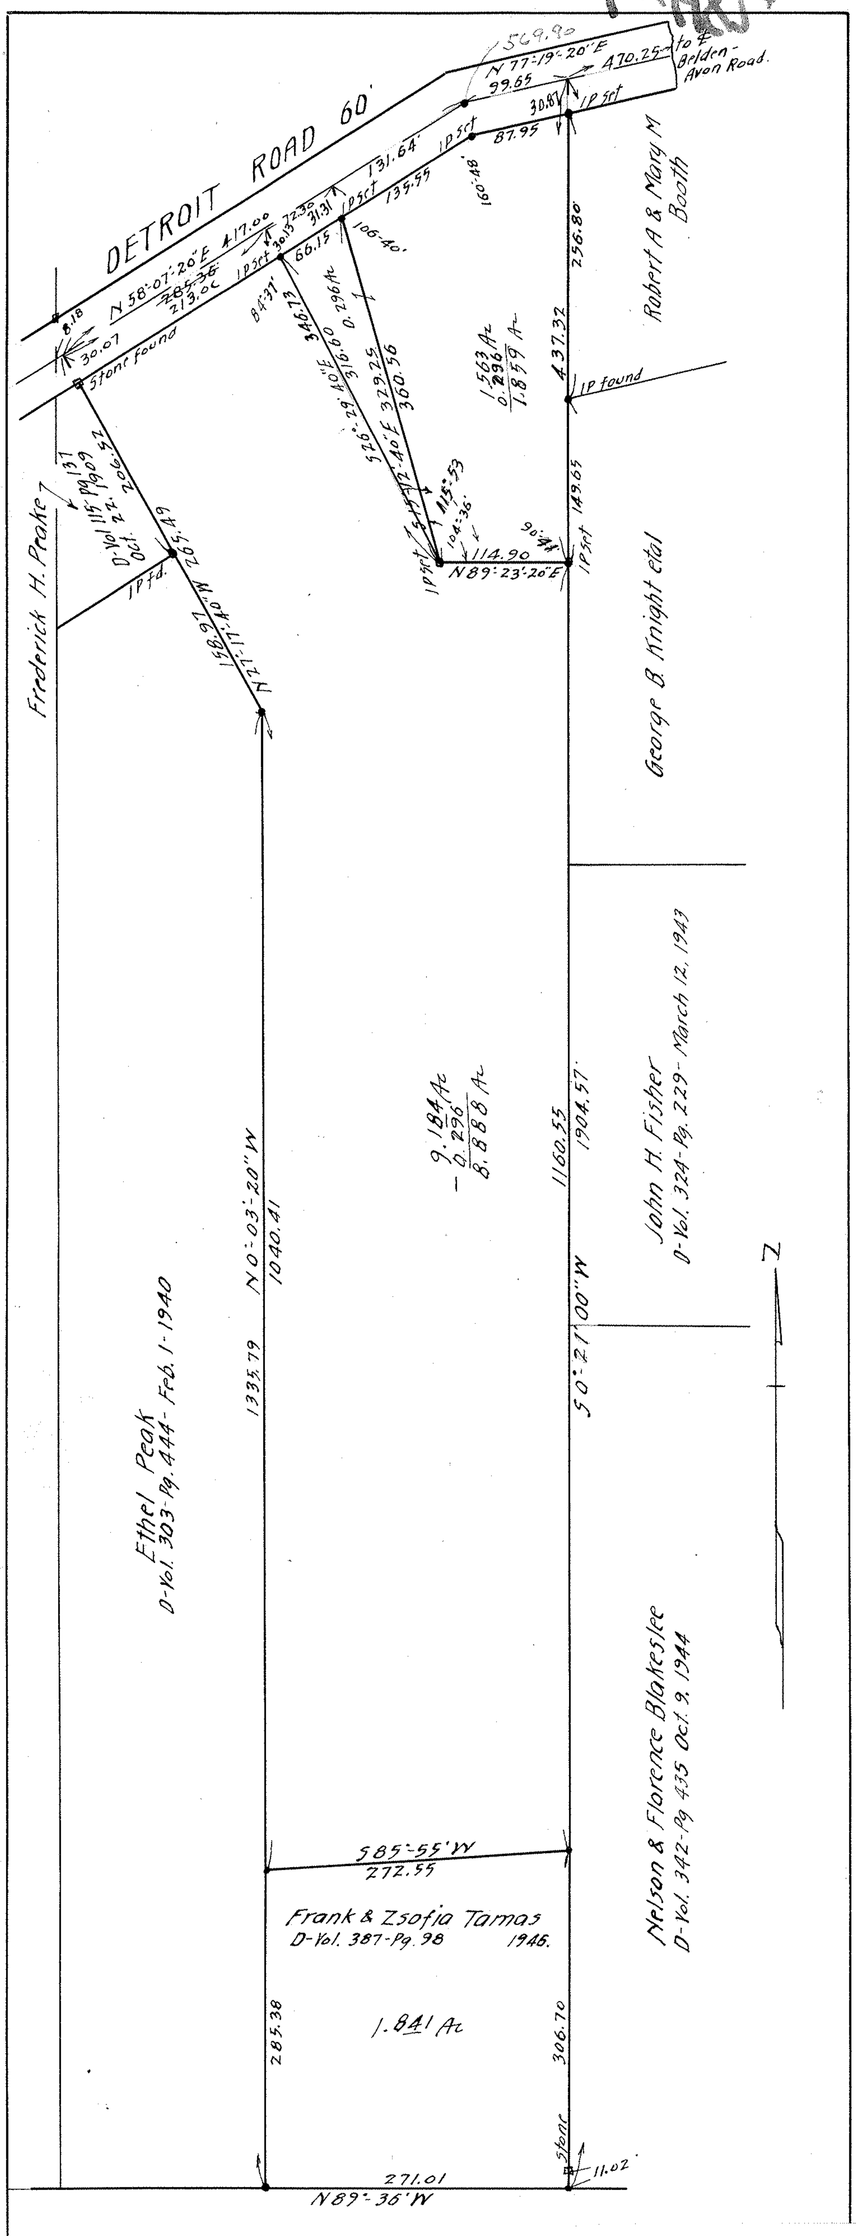

Survey for
LOIS A. HENES
D-Vol. 326-Pg 376 March 1 1943
Section 15 Avon Village
Lorain County Ohio.
Scale 1"=100' July 2 1947.
J. W. Warden, Registered Surveyor.
Revised Feb. 28, 1948 D.A.

600482B

04-00-015-109-028
-010
-030

400-015-B