


14-00-155-000-001, -002

14-00-146-000-004 → -012

-008
-009 14-F
-010

-016, -015
-018, 14-F
-021
-022

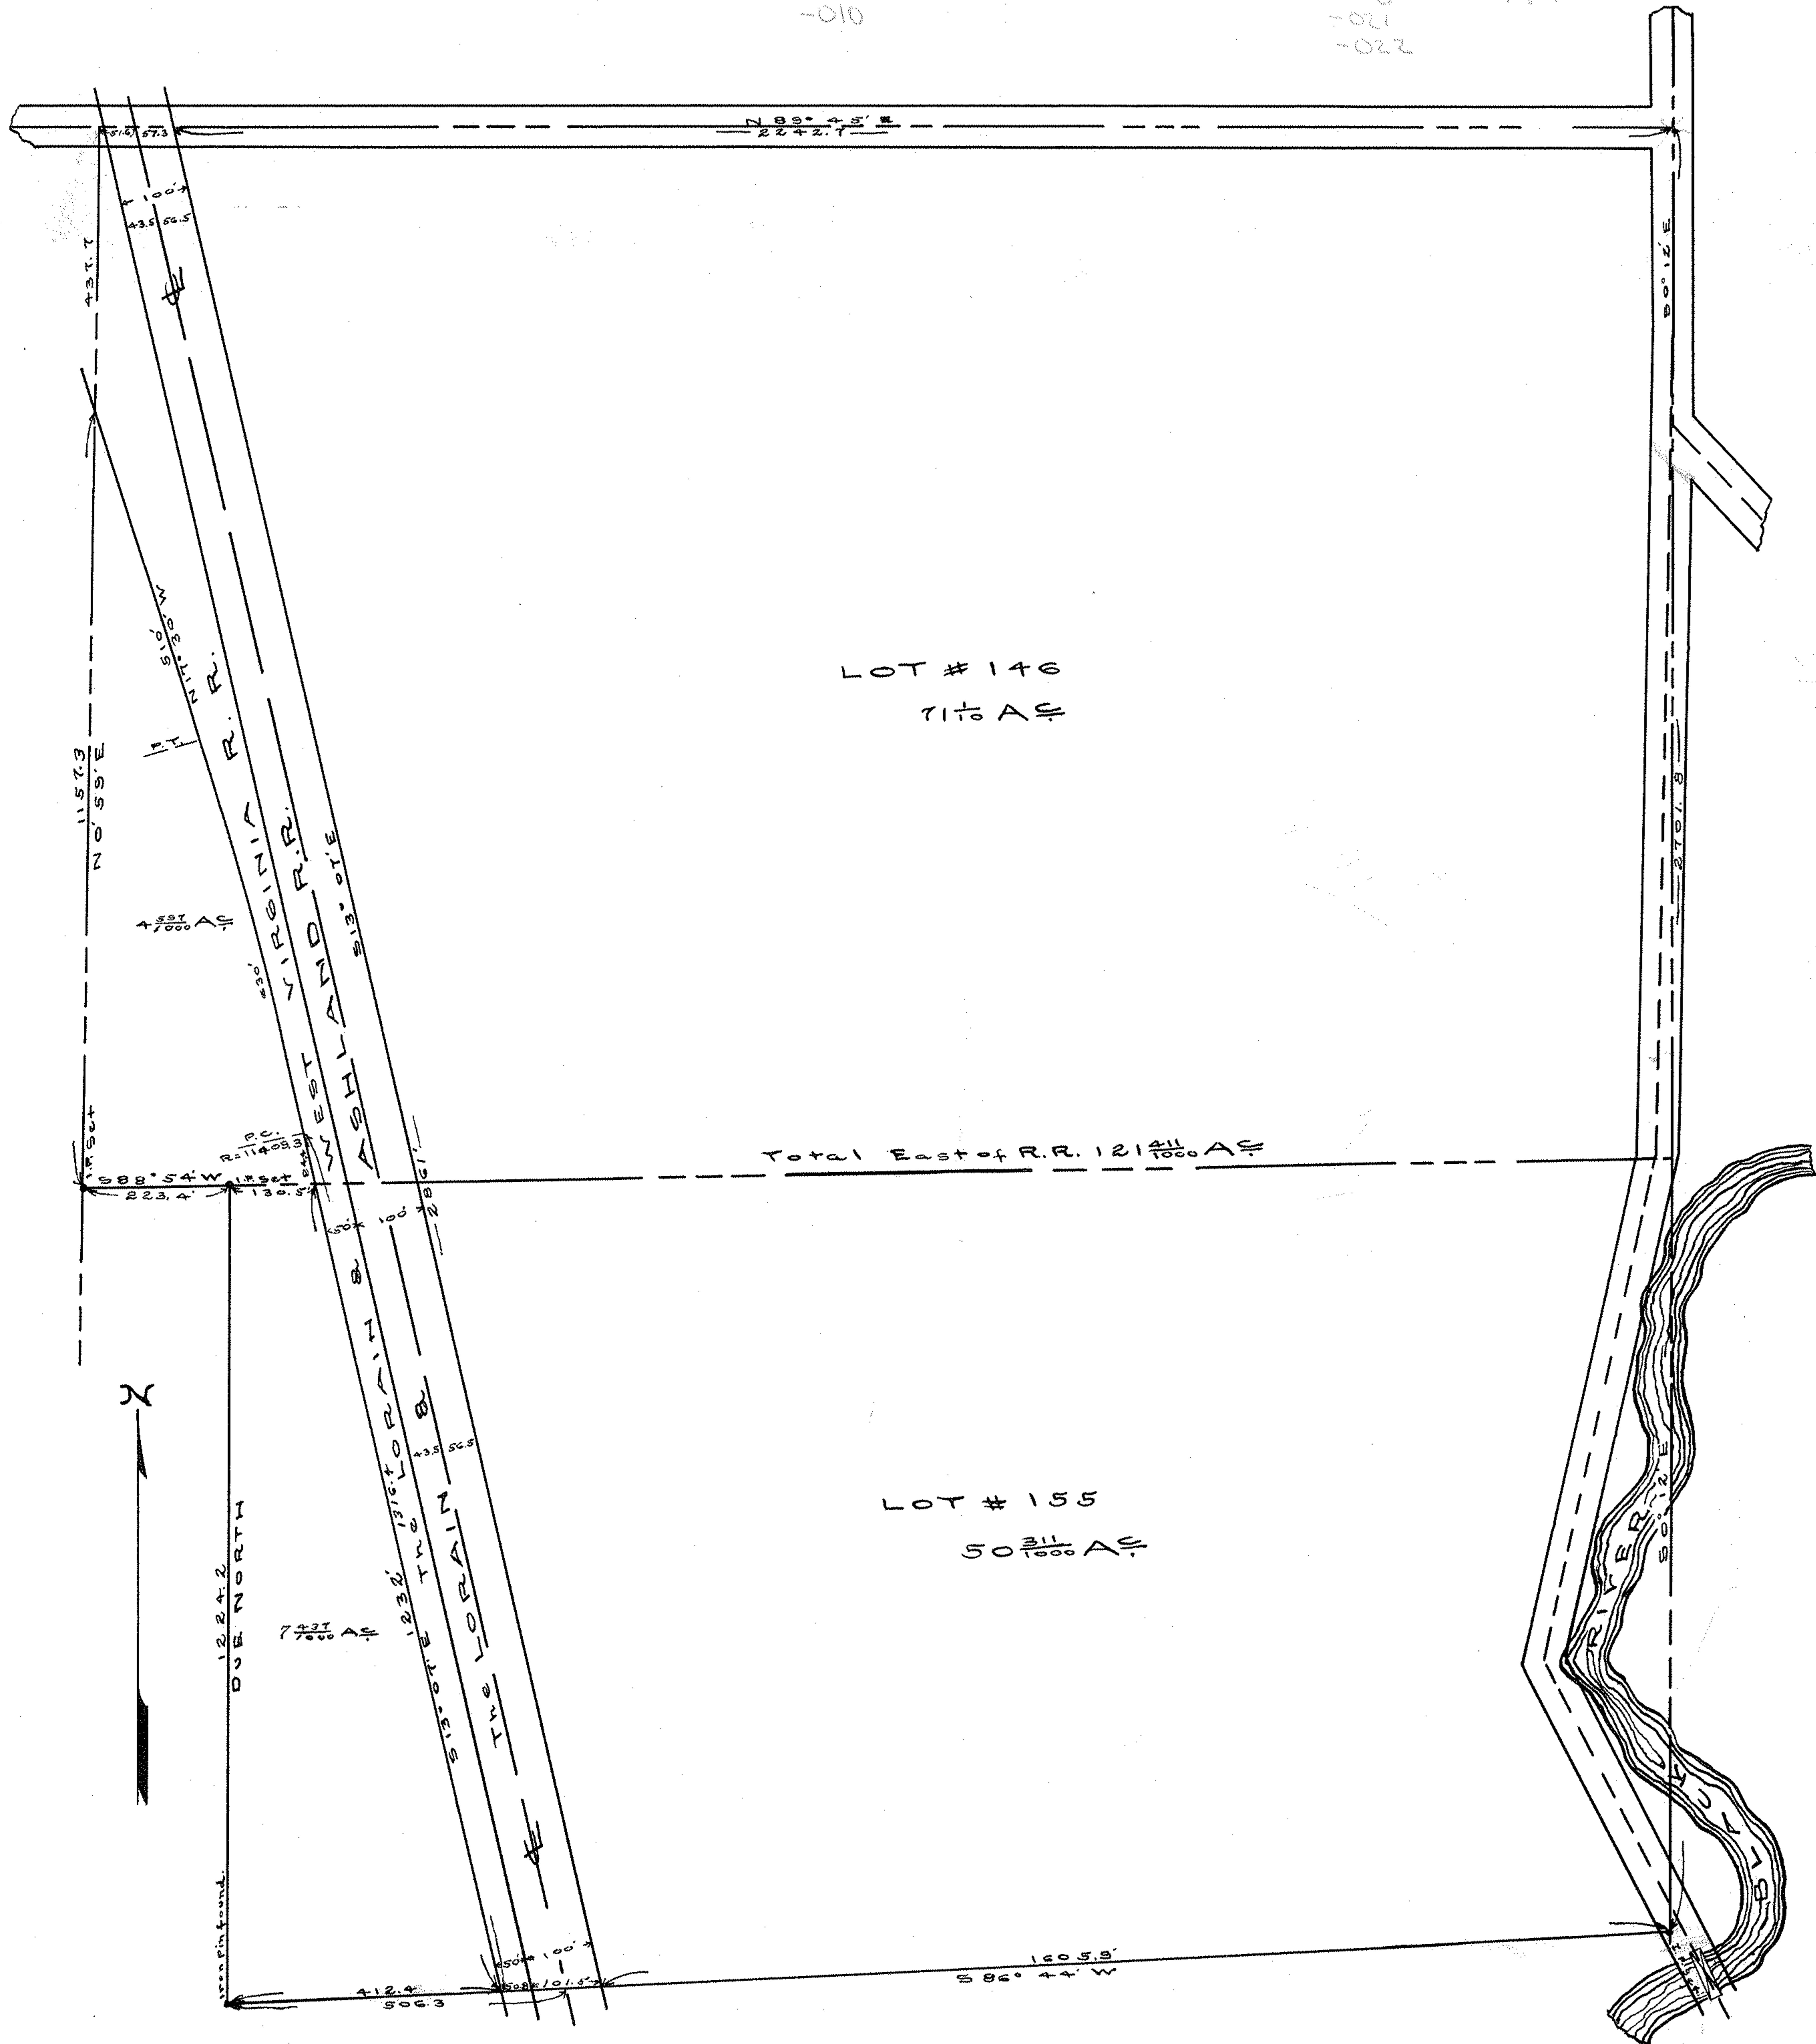

600331

SURVEY
for
J. N. STONE ADMR.
URIEL NORTON ESTATE.
Lots #146 & 155.
PITTSFIELD-TWP.
T. L. GIBSON C. E. May, 22, 1913.
Scale 1" = 200'

P-331