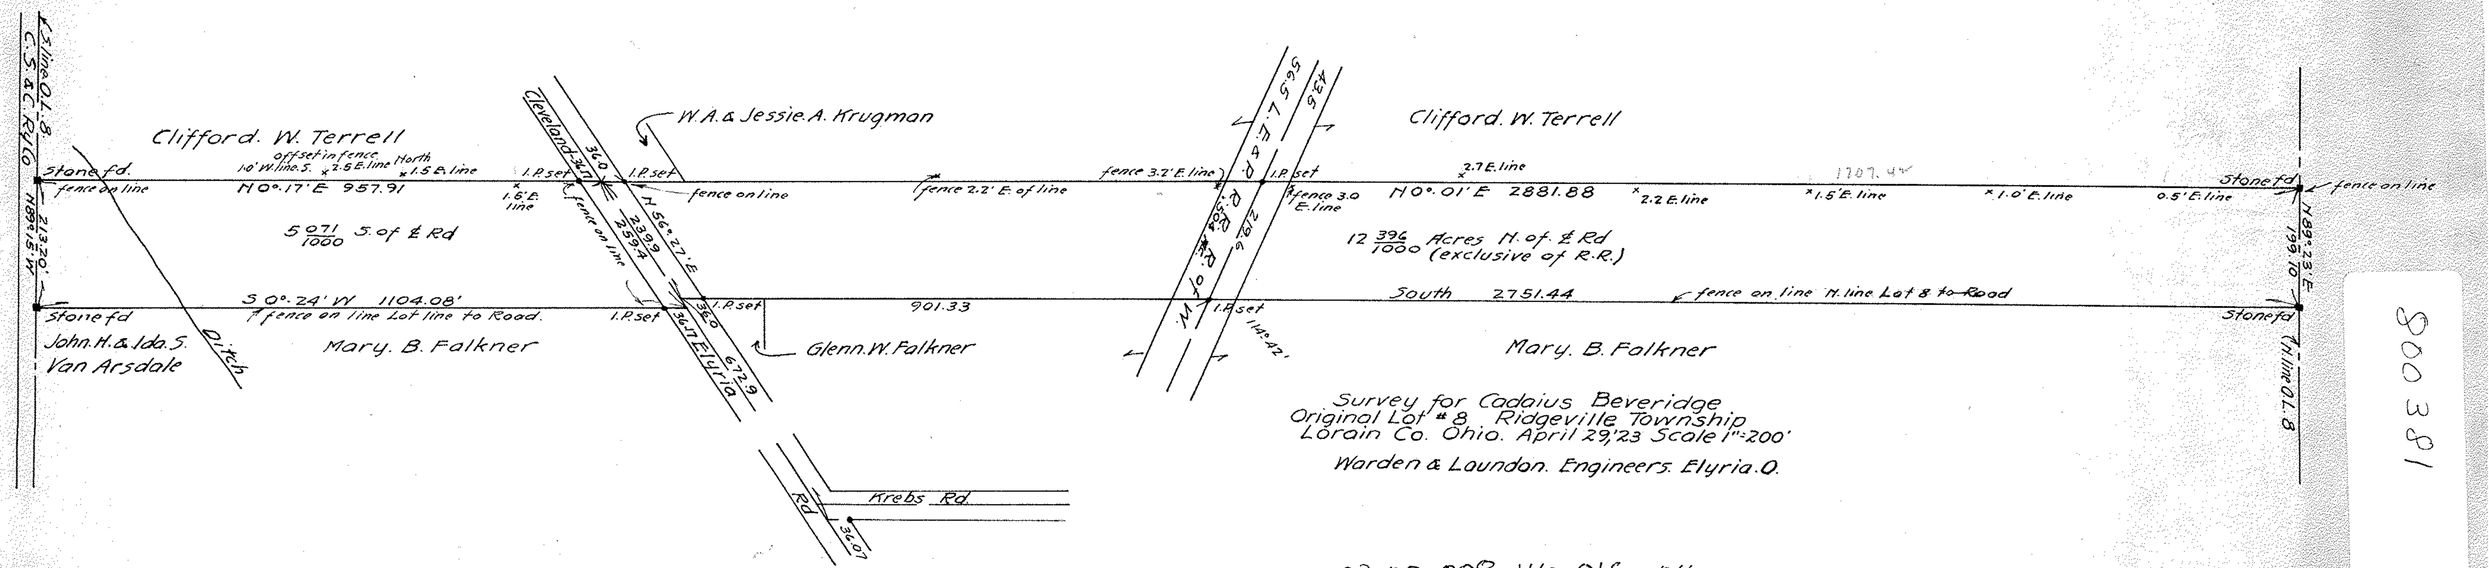

Survey for Cadaius Beveridge
Original Lot # 8 Ridgeville Township
Lorain Co. Ohio. April 29, '23 Scale 1"=200'
Warden & Laundon. Engineers. Elyria. O.

07-00-008-116-015, -016
07-00-008-117-037

MAP PG: 7-00-008-C

800 381