


Survey of
WALTON PROPERTY
 O.L. #106-107 East of East Branch
 of Black River
 CITY OF ELYRIA - LORAIN CO. OHIO.
 Oct. 30-1913 T.L. Gibson C.E.
 Scale 1" = 50ft.

600103D

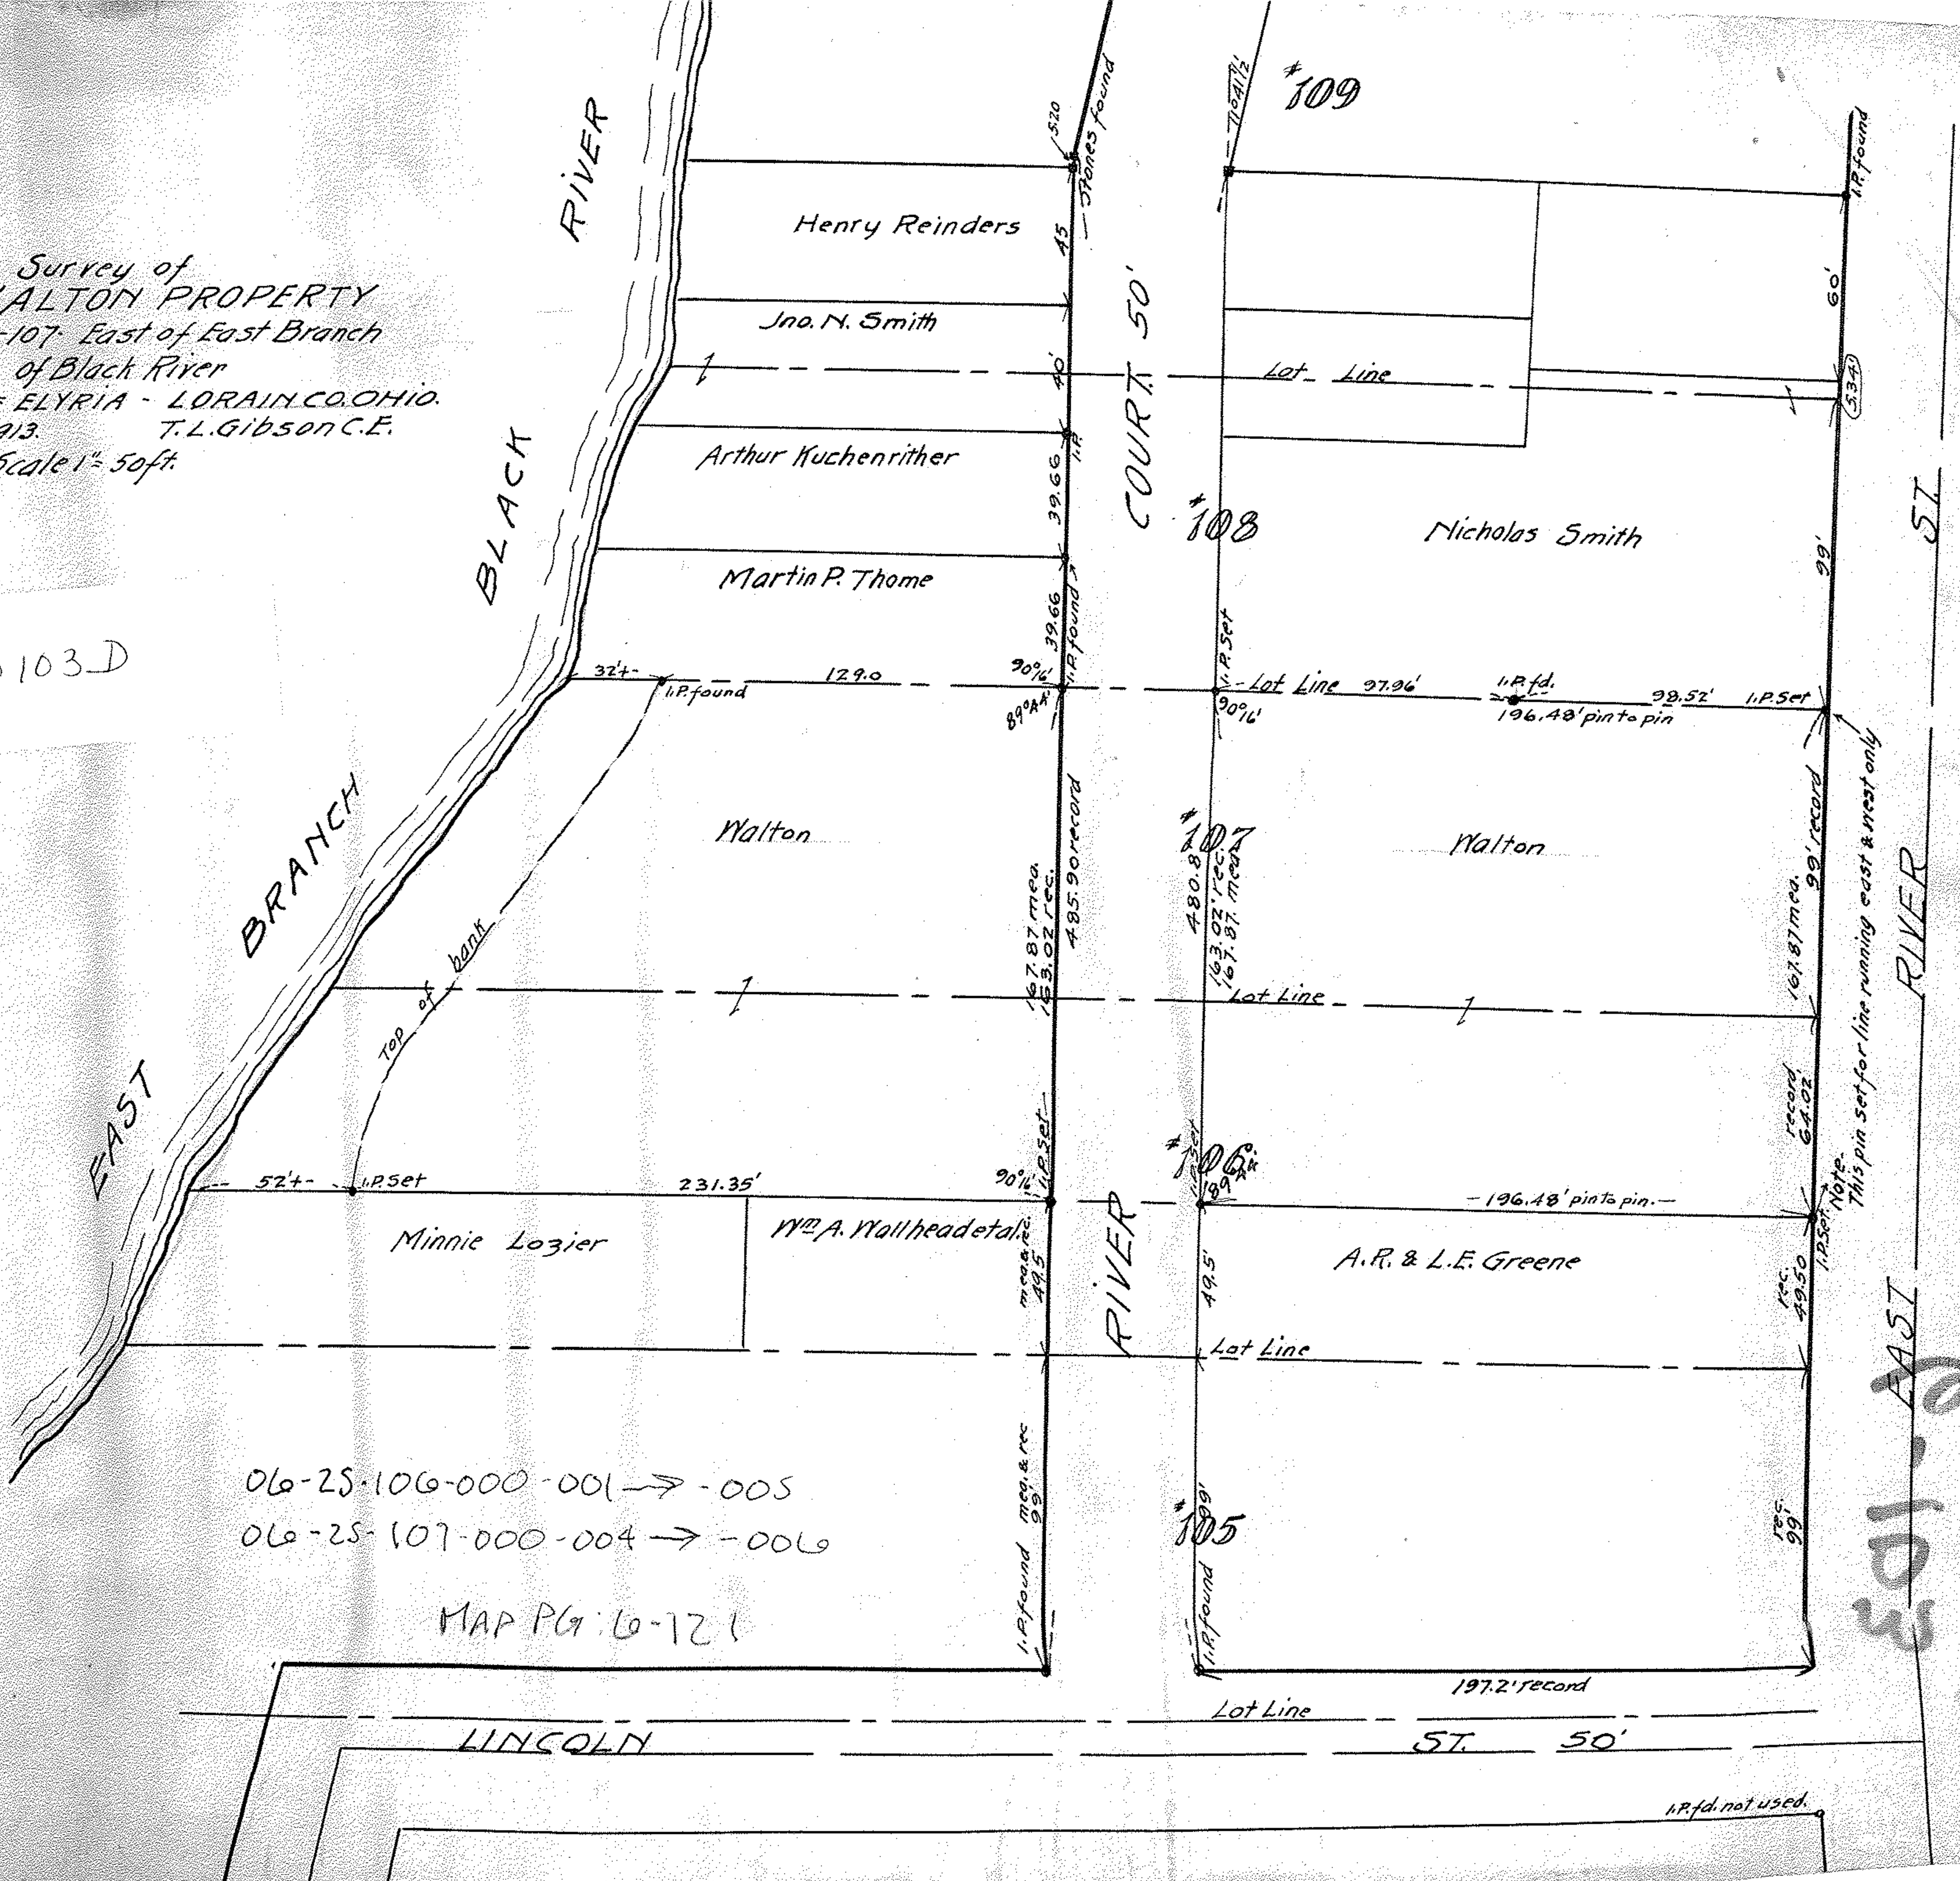

06-25-106-000-001 → -005
 06-25-107-000-004 → -006

MAP PG. 6-121

601-015

I.P. fd. not used.