600699

Survey on East Third Street showing lots as occupied at present time
For A. Boynton Elyria Ohio
May 13. 1907. Scale 1 inch = 40 feet.
C. Lawrence

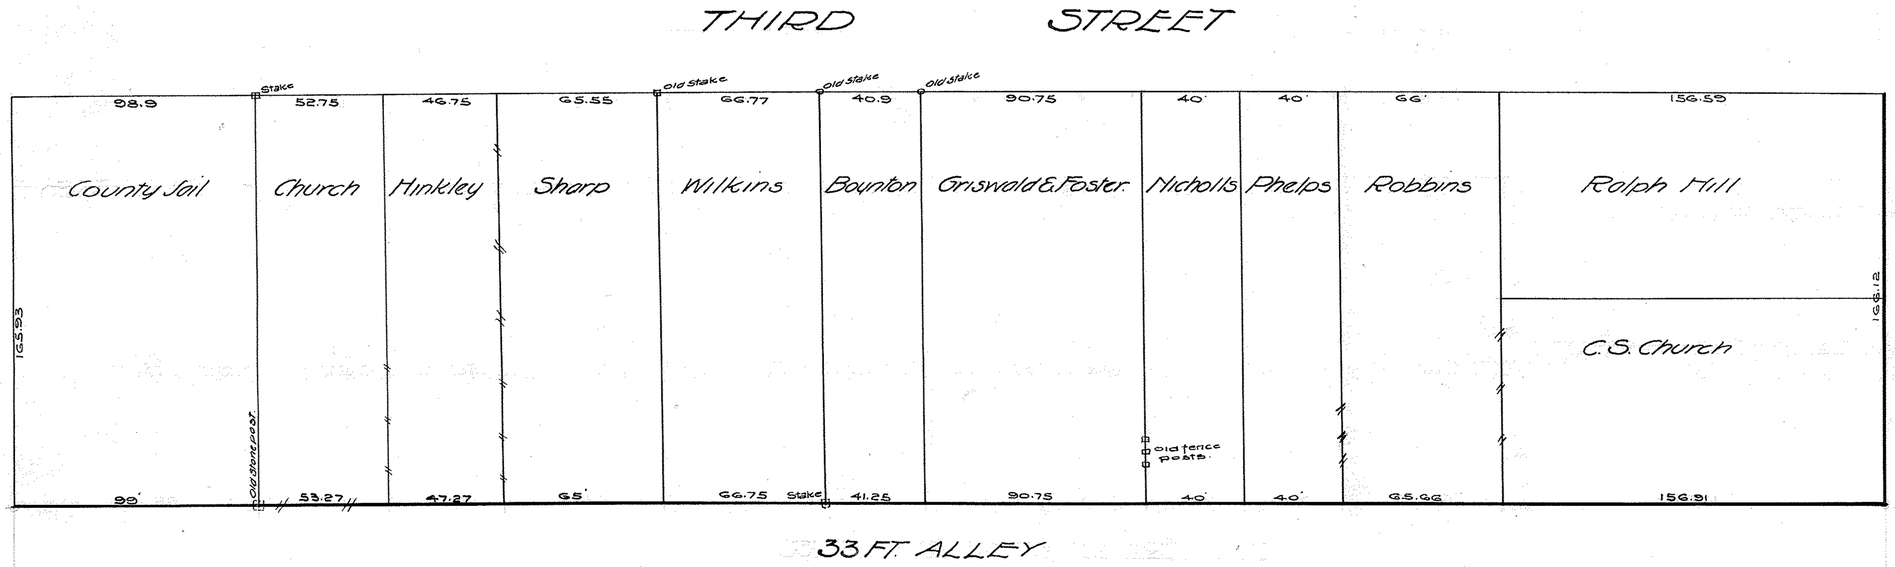

MAP PG: 6-120
06-26-051-000-001 → -007
-016 → -022