05-00-015-000-078

5-00-015-B -077

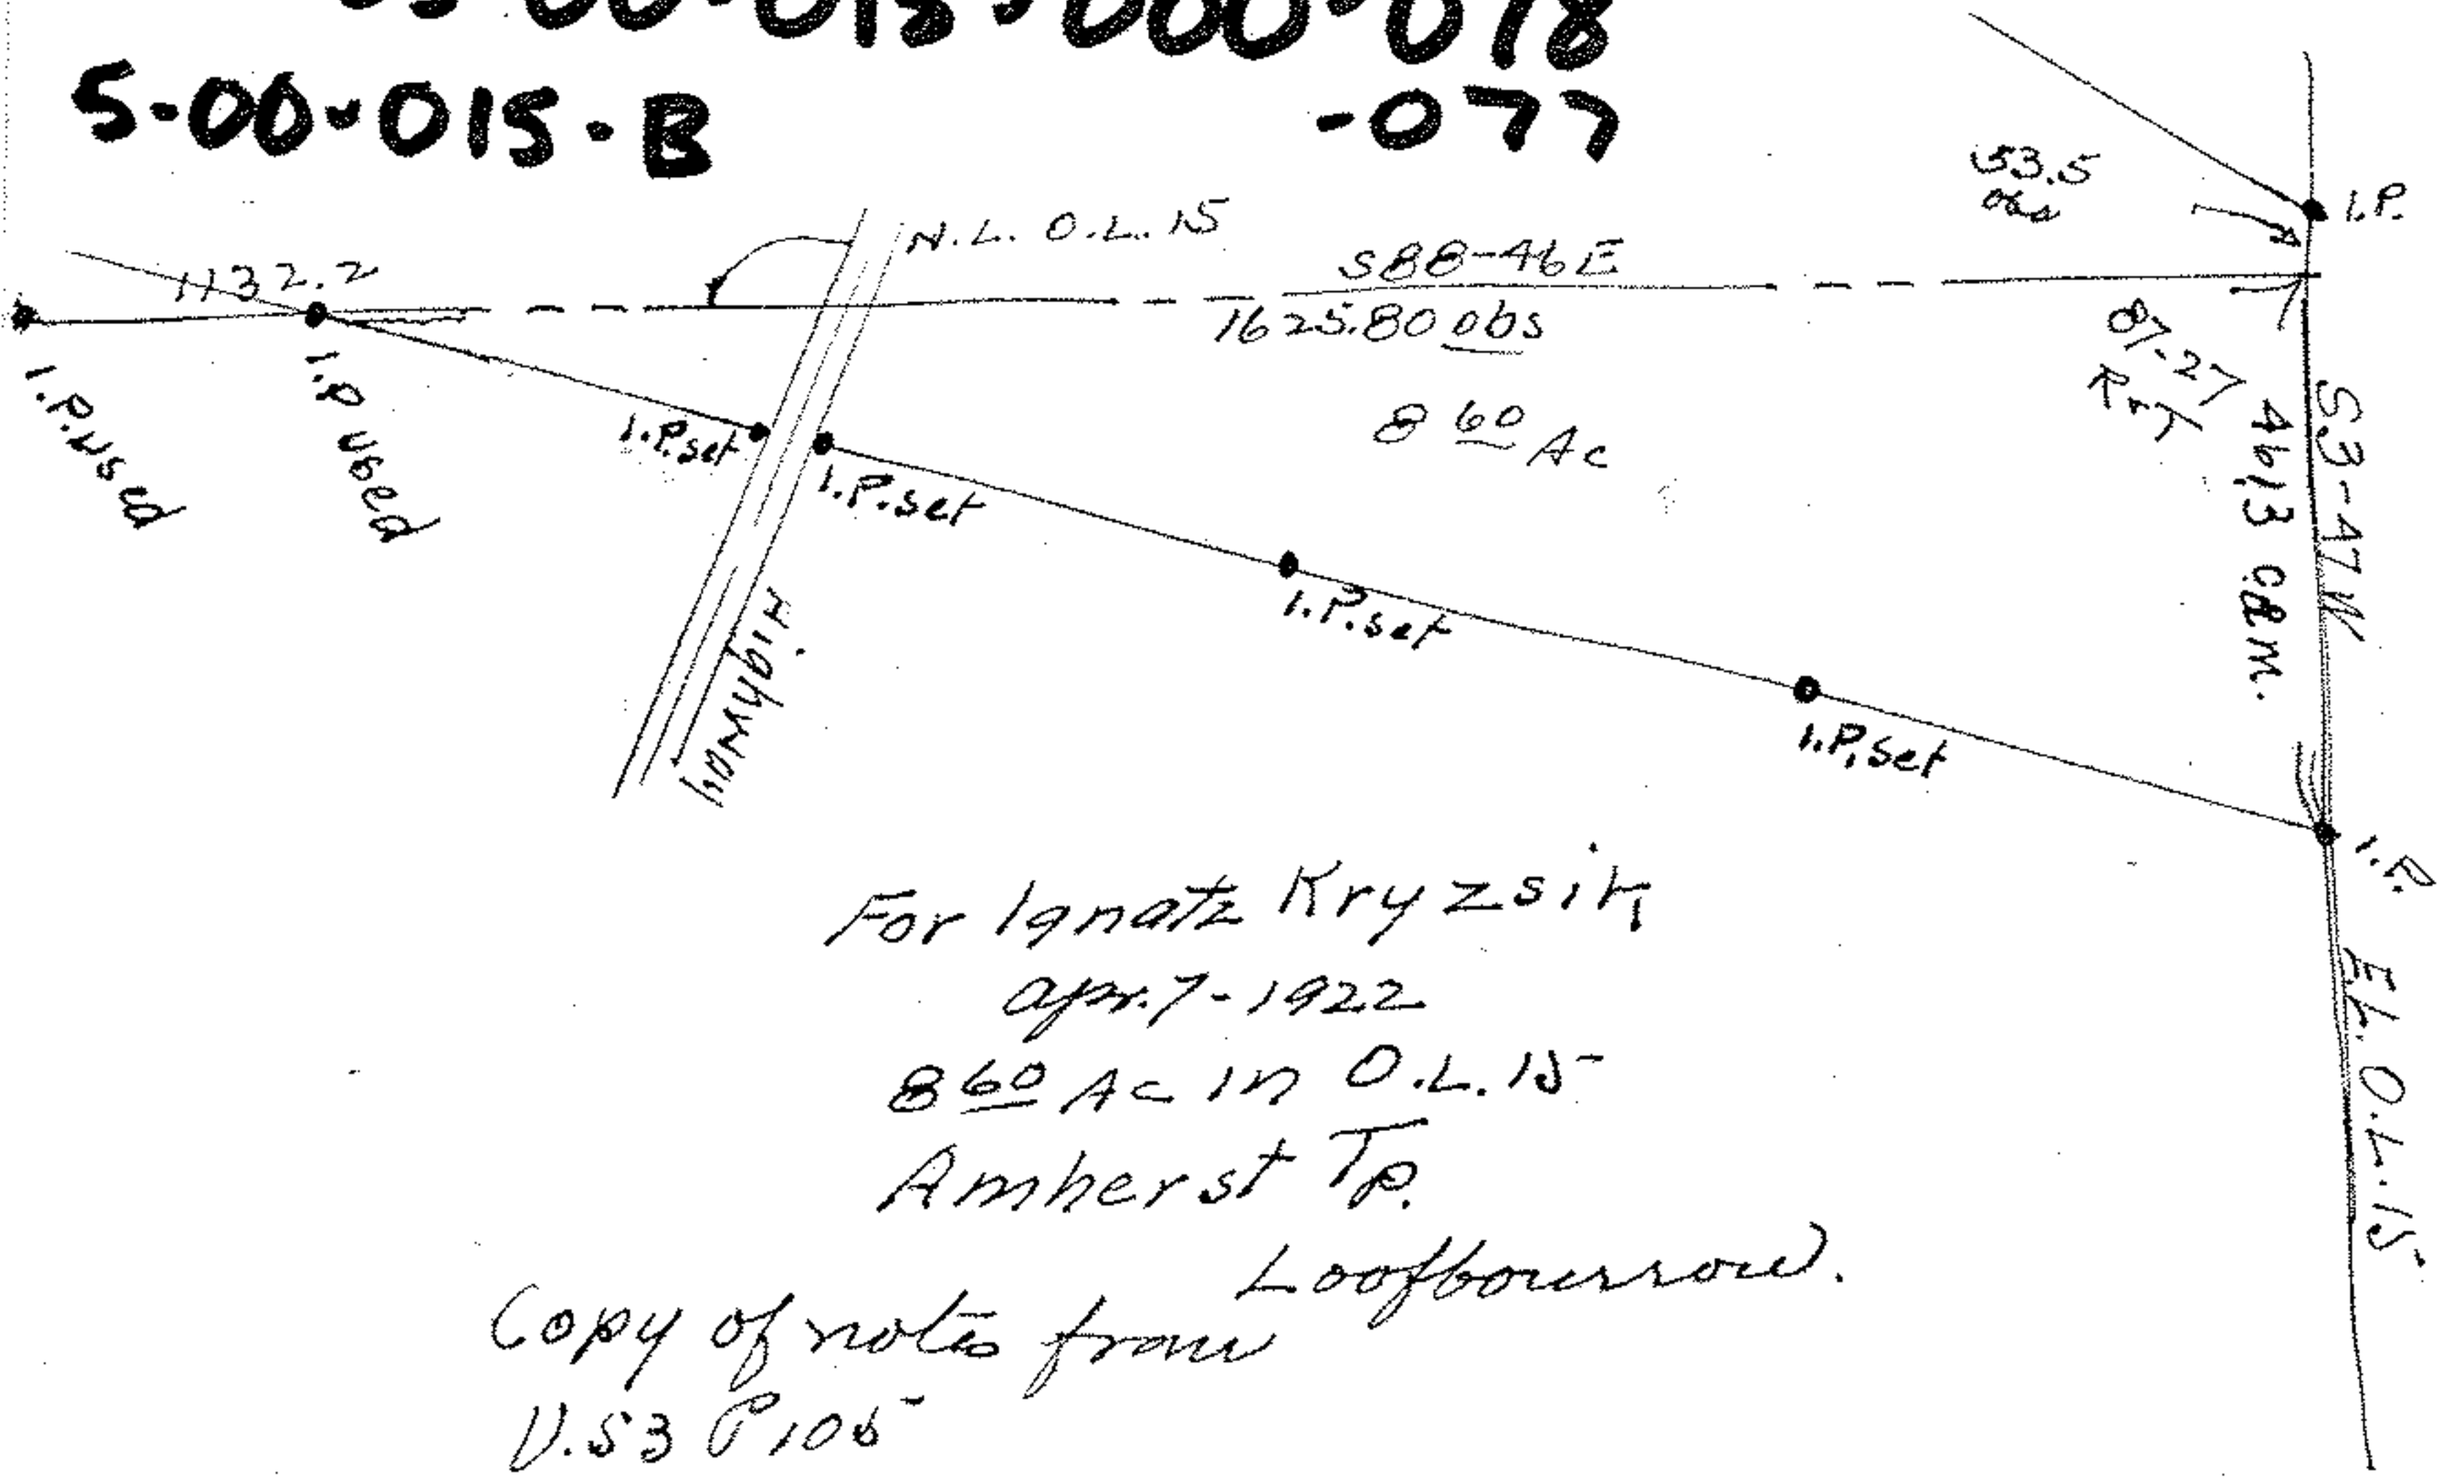

For Ignatz Kryzsik
apr. 7-1922
8 60 Ac in O.L. 15
Amherst Tp.
Loofbourrow.

Copy of note from
V.53 P105