


$\frac{676.32}{1144.58}$   
 38  
 0.105

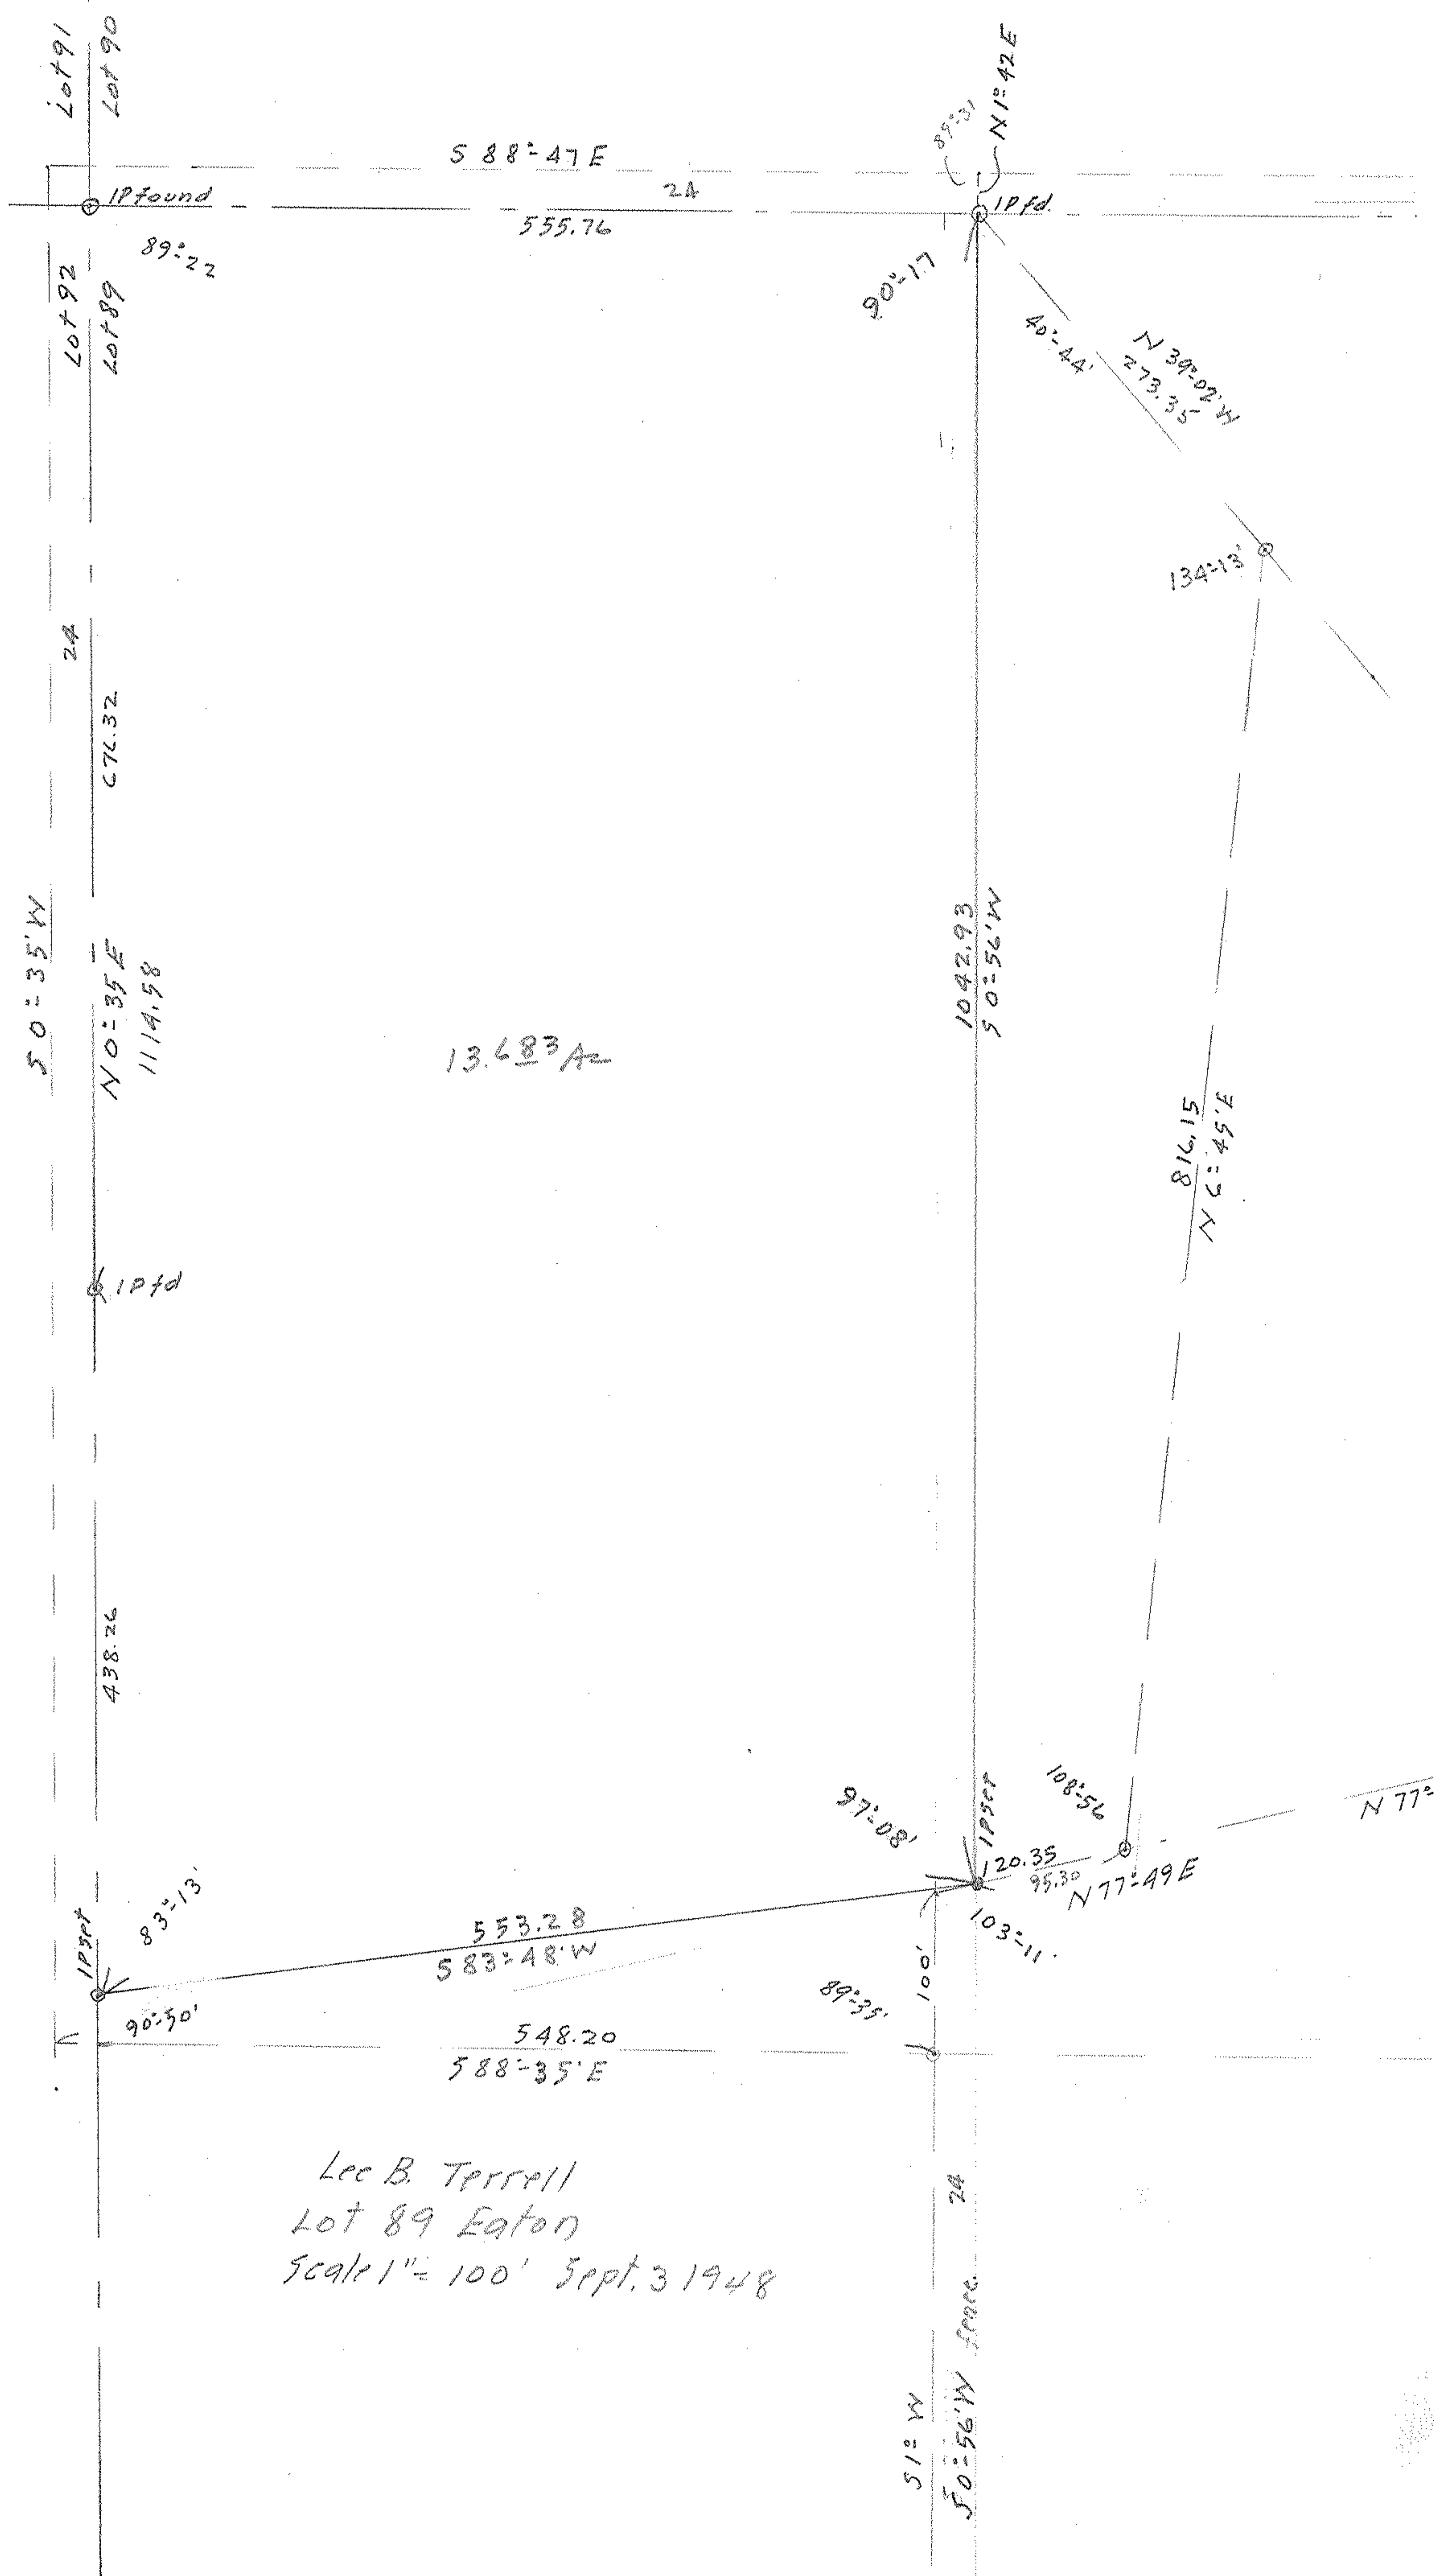

Lee B. Terrill  
 Lot 89 Eaton  
 Scale 1" = 100' Sept. 3 1948

MAP PG: 11-00-089-A  
 11-00-089-000-124, 125