TAYLOR'S ADDITION
TO THE
VILLAGE OF AMHERST, O.

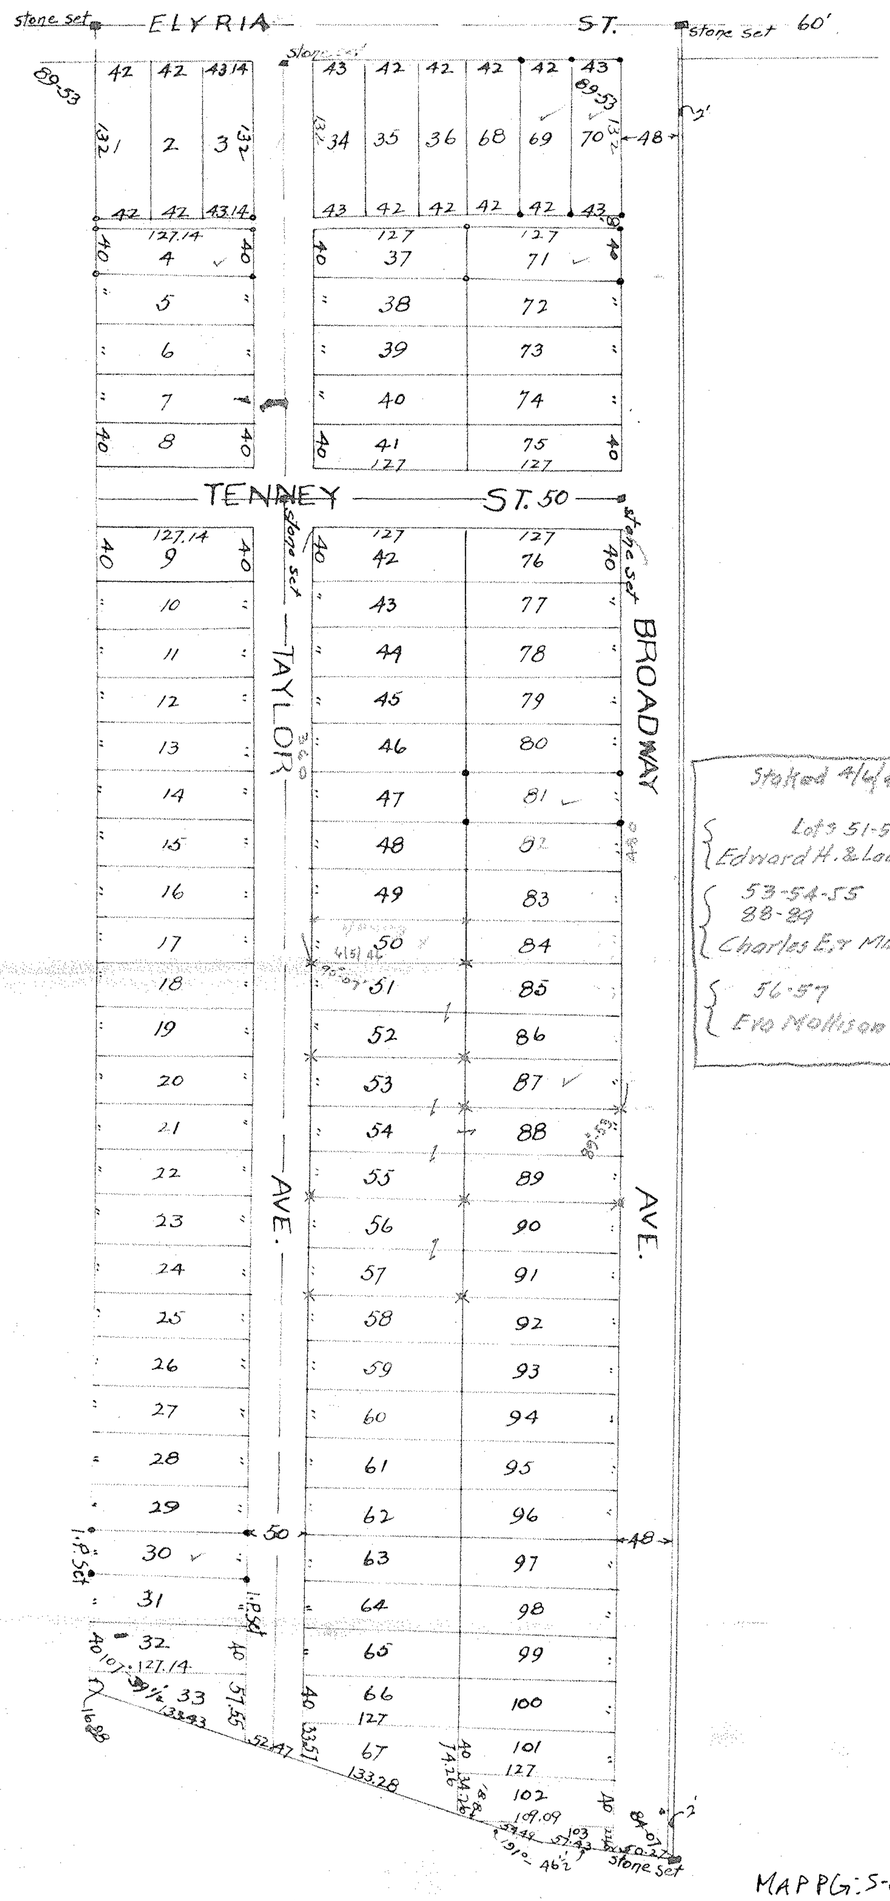

MAP PG: 5-00-037 A B

VOL. 7 Pg. 4

6-912

H 31