Jeanette & Mary Kathryn Conry - D. Vol-407-585 Feb 20-1947

193-545 - Beg. 99' N 29x70 - 9/26/23
197-235 - Beg 645.0 Sly fr NL.166 1/10/24
Sline 66' " " " "
70' deep

158-309=66

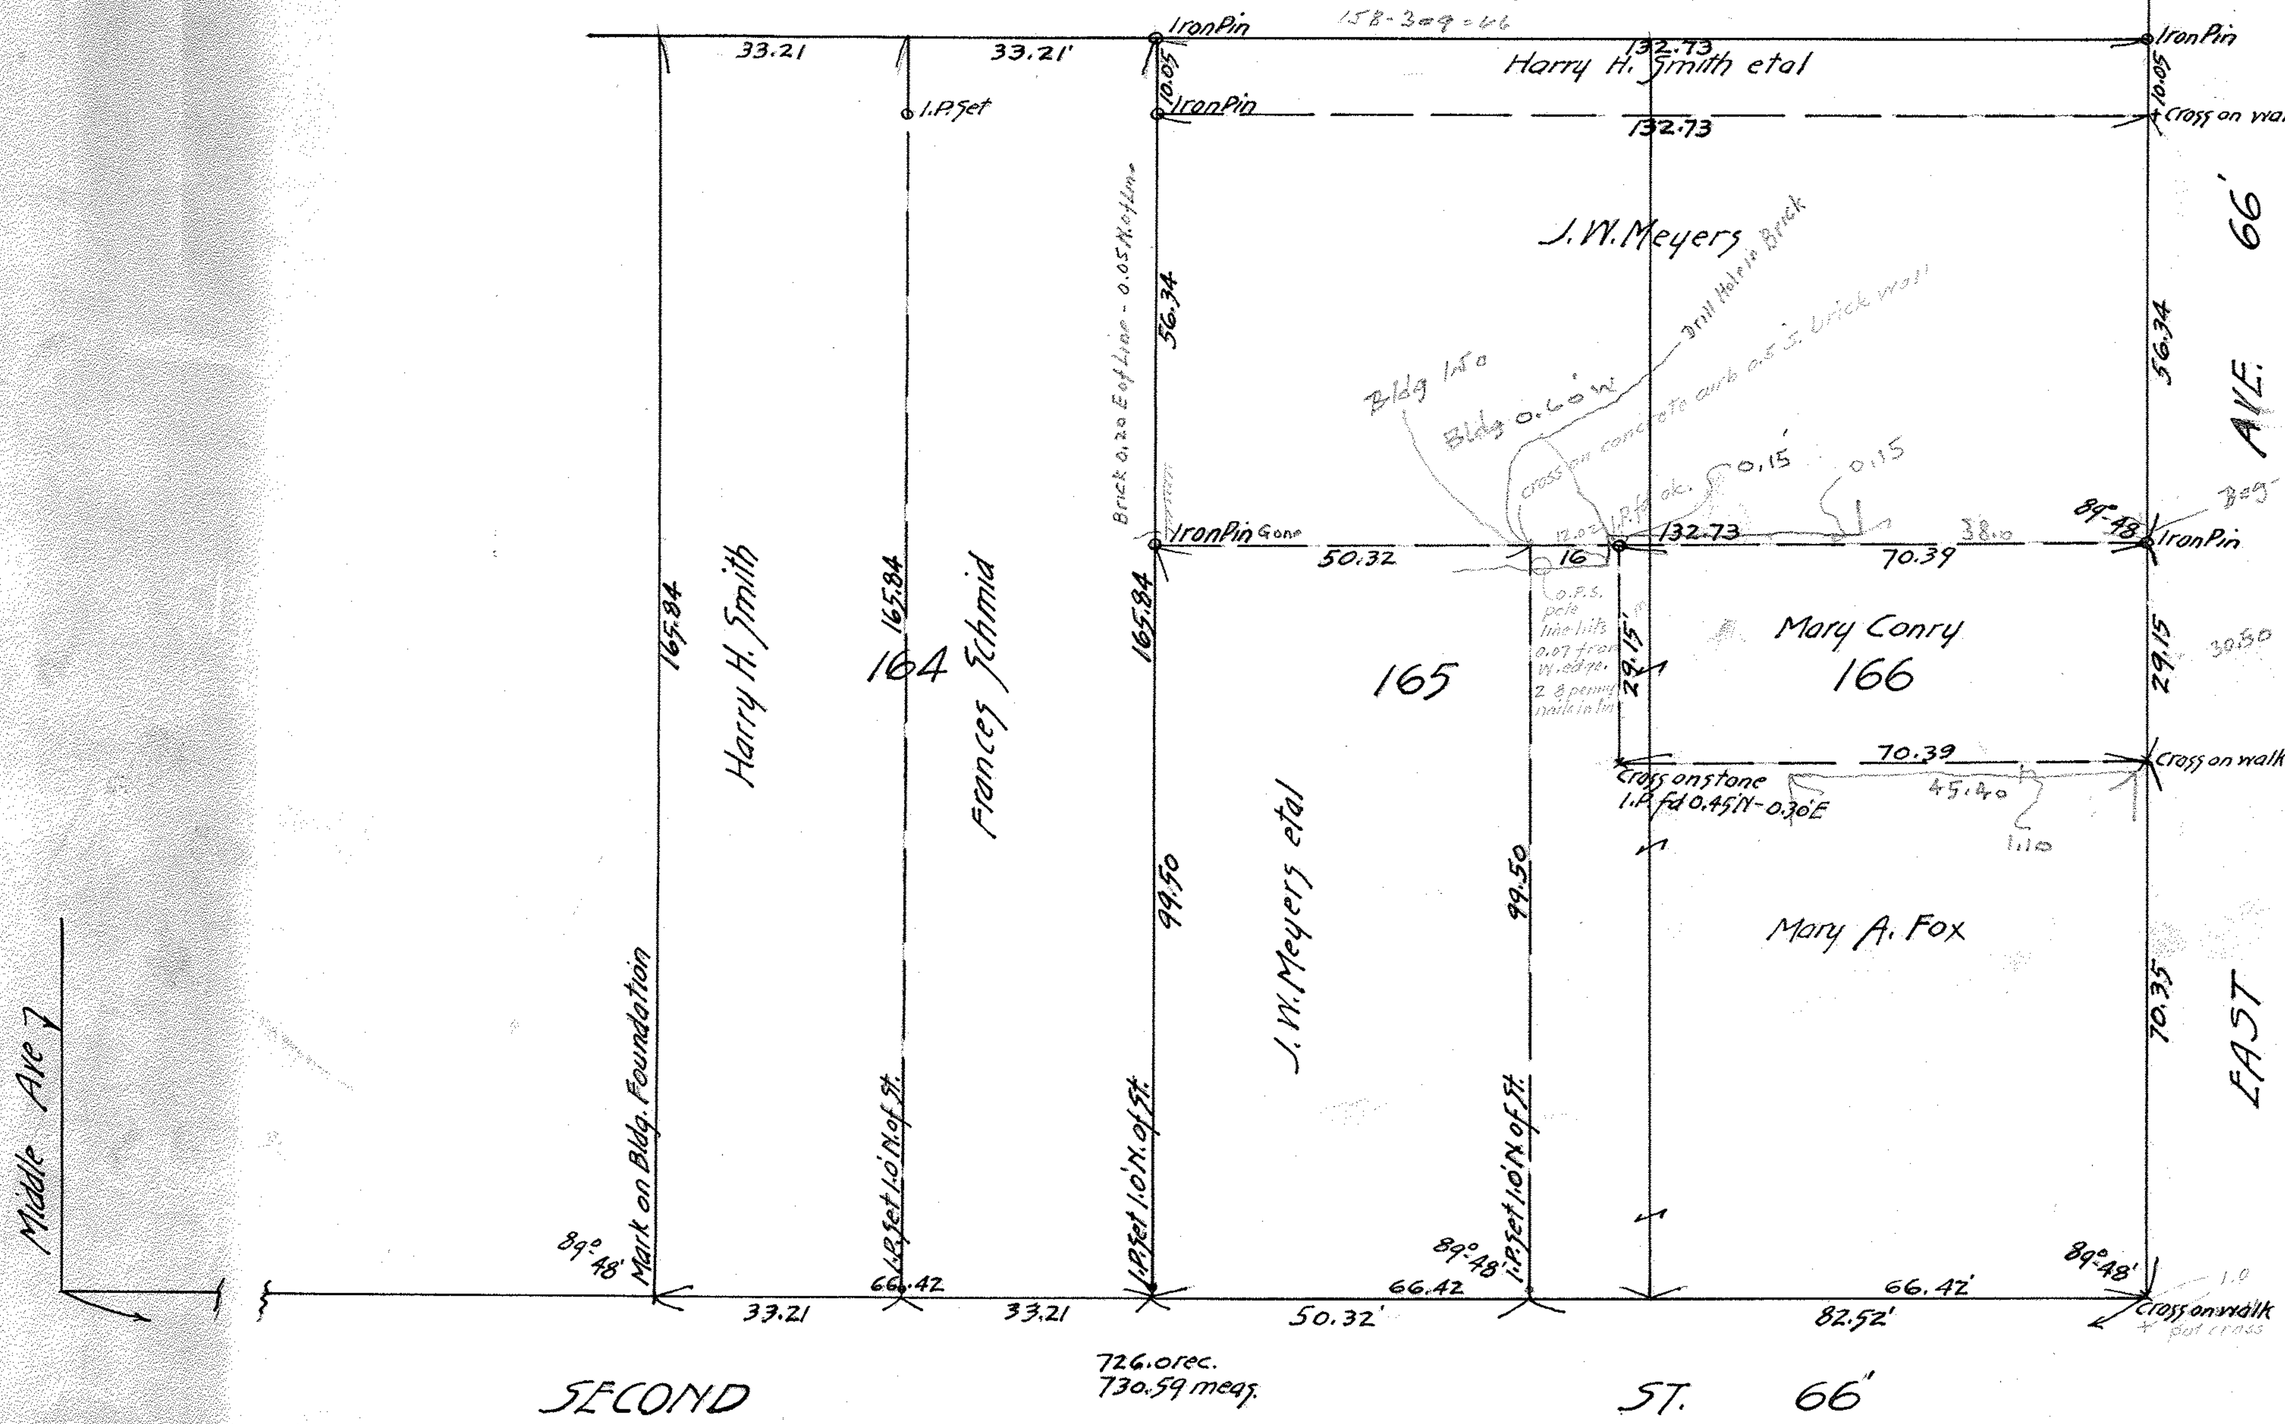

Survey for
J. W. Meyers
Lot 165-166 Blk 63
Original Village Plat of Elyria
Elyria-Lorain Co., Ohio.
Jan. 15, 1924.
Scale 1 inch = 20 ft.
Warden & Laundon
Civil Engineers.

600 393

MAP PG: 6-120
06-26-063-000-051, -050, -054
-053, -058, -057