600103C

P-103

06-25-100-000-005
-105-000-009
-010
-011

06-121
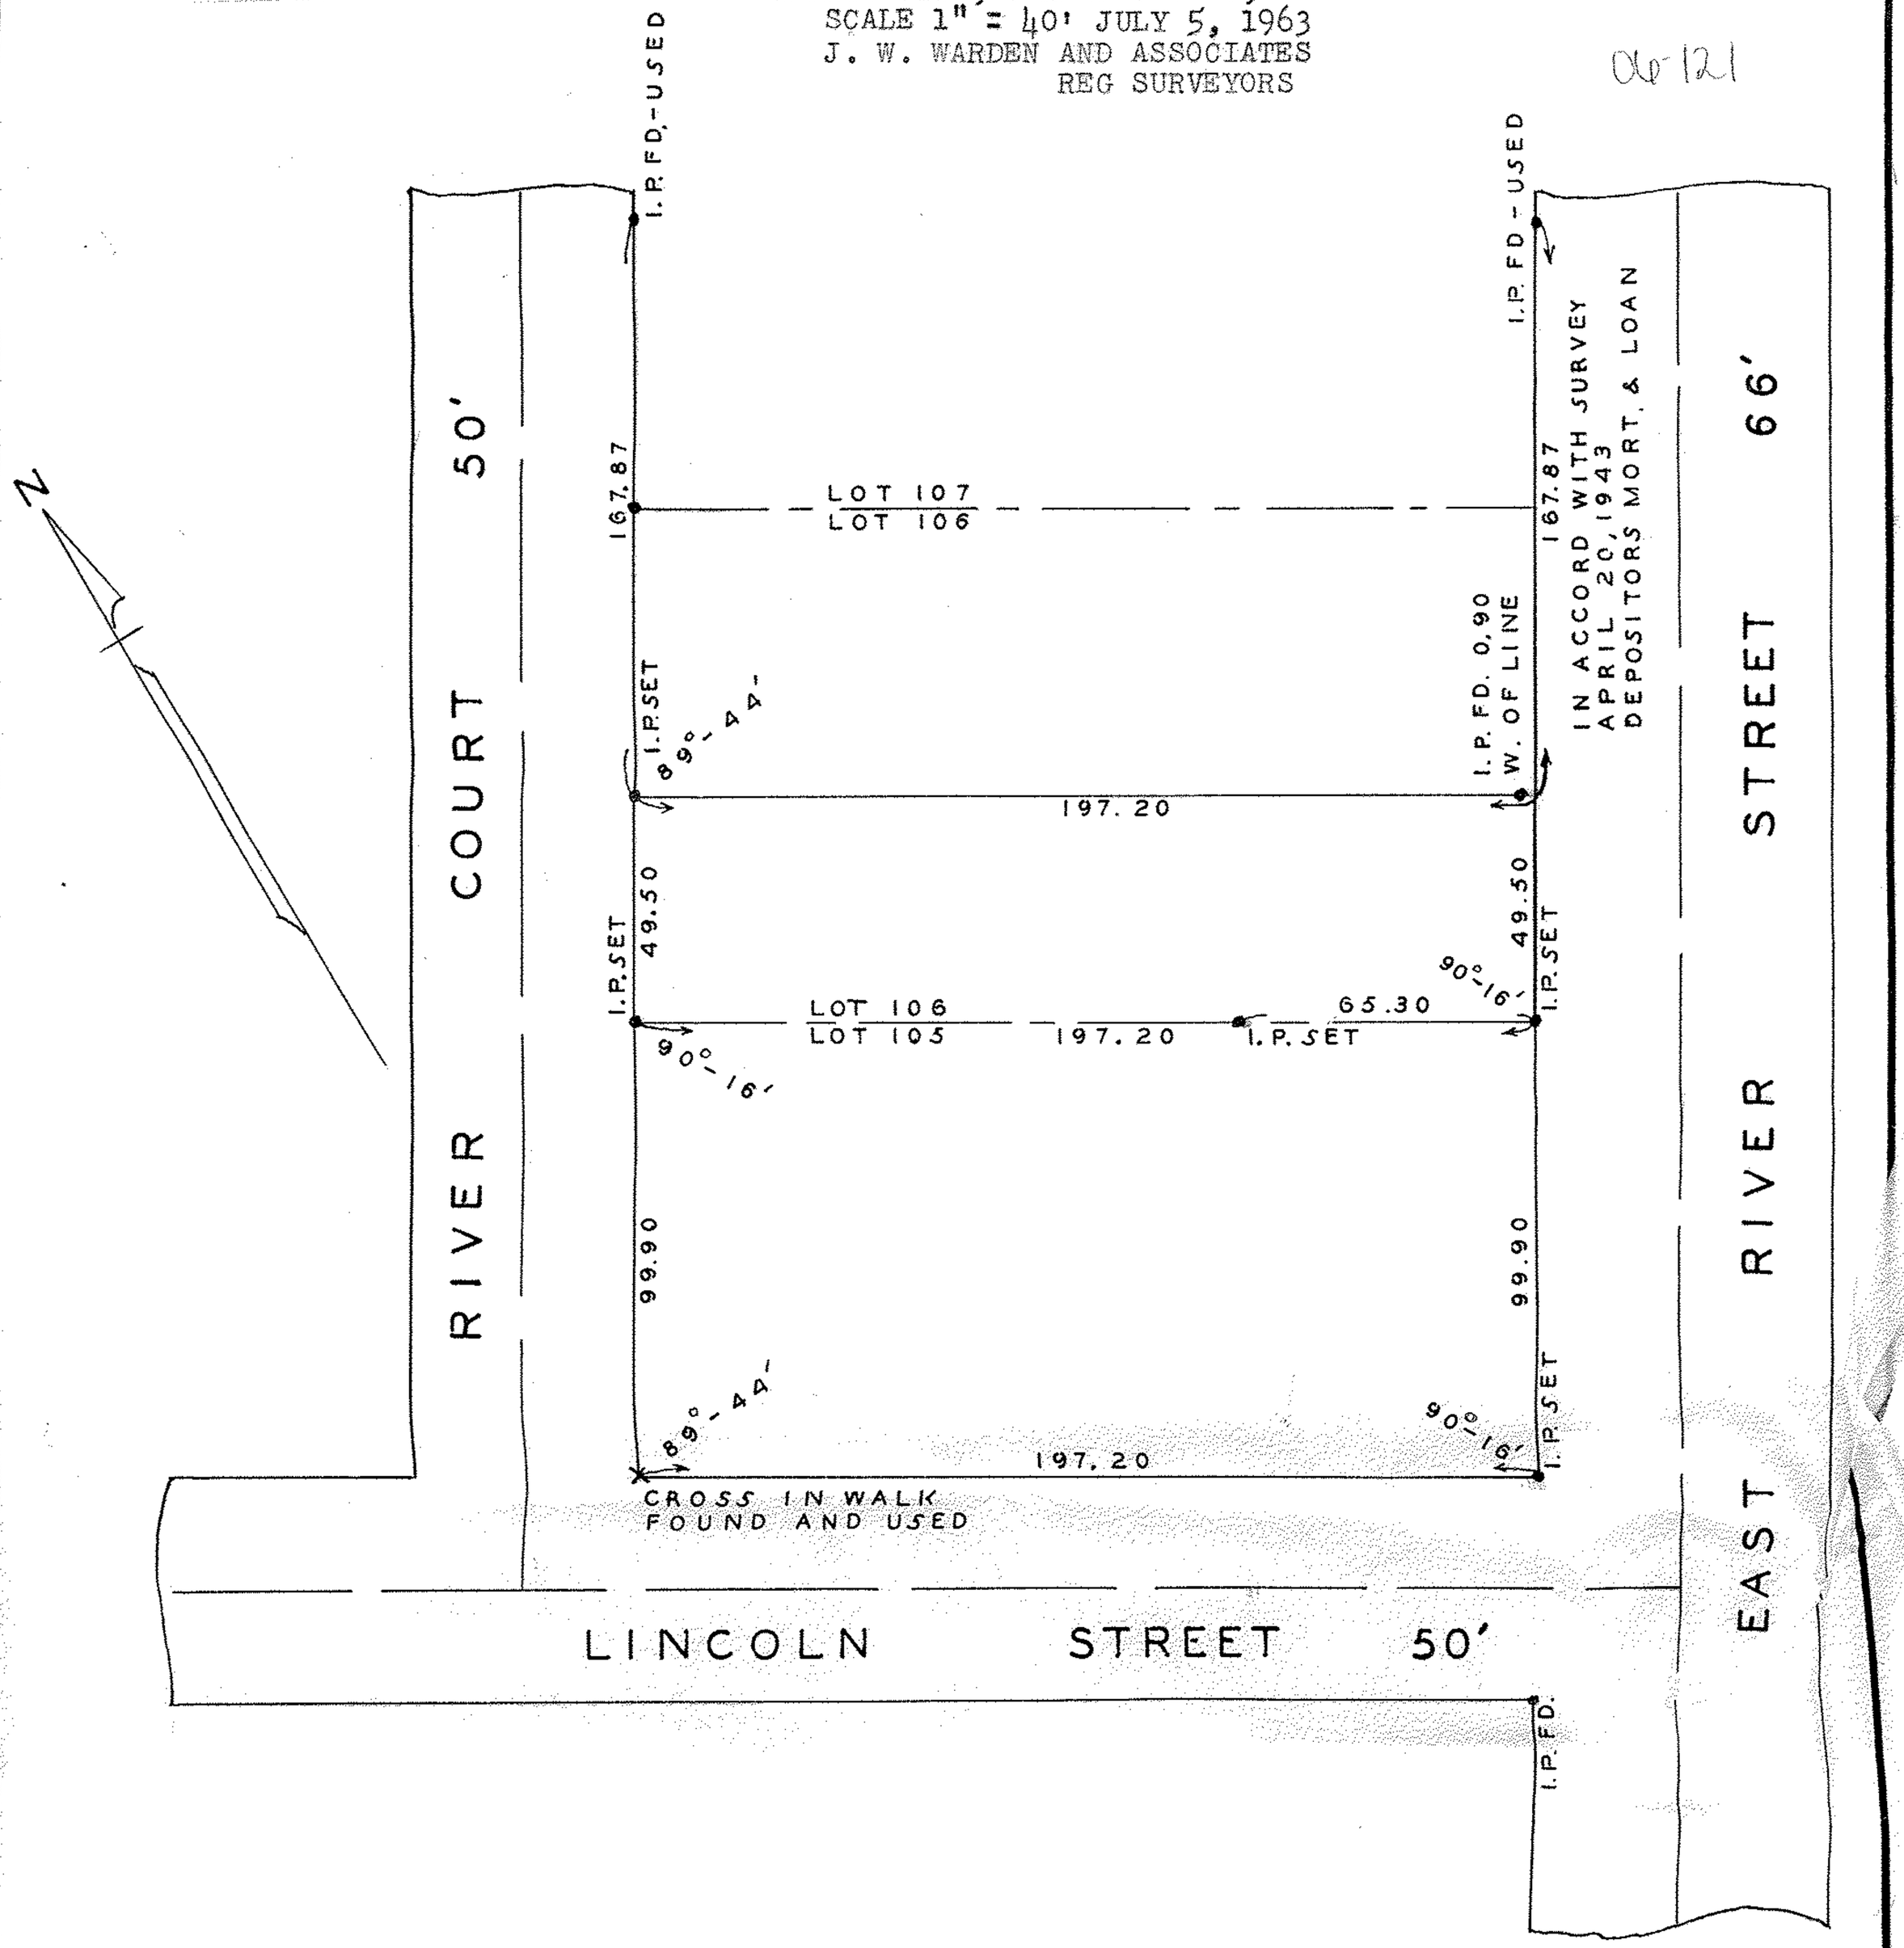
SURVEY FOR
L. E. DAVIS
D-VOL 685 PG 273 DEC 26, 1956
LOT 106 E OF EAST BRANCH OF BLACK RIVER
ELYRIA CITY, LORAIN COUNTY, OHIO
SCALE 1" = 40' JULY 5, 1963
J. W. WARDEN AND ASSOCIATES
REG SURVEYORS