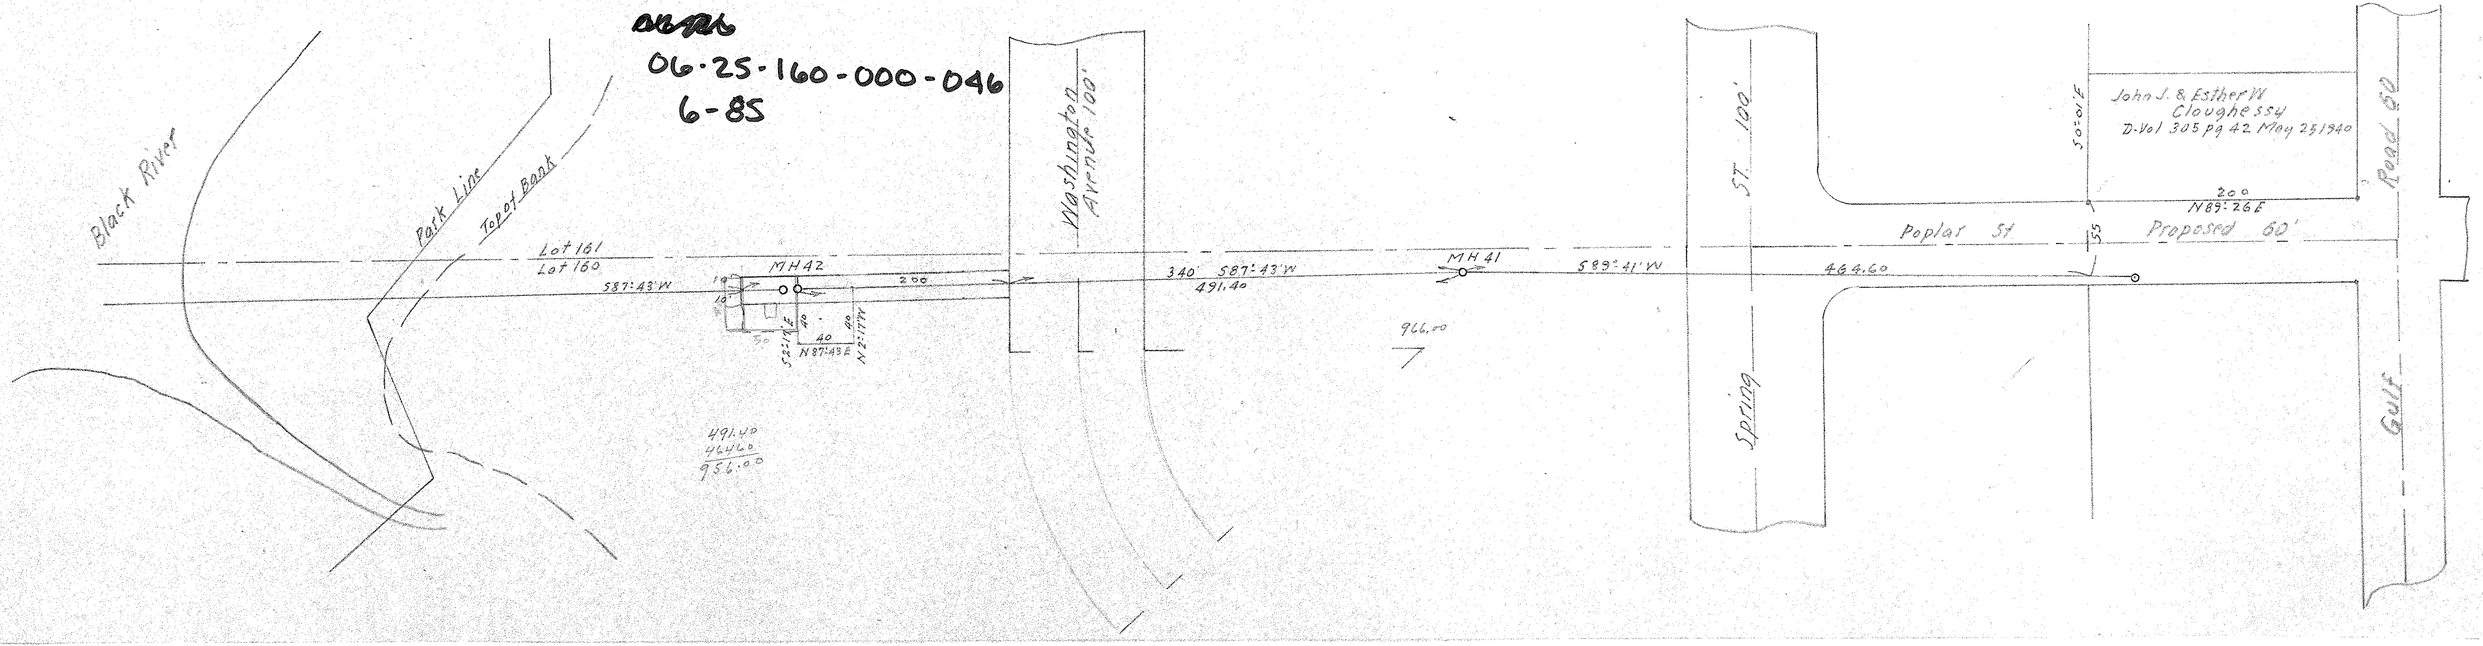06-25-160-000-046
6-85