


PPN 04-00-022-103-???

MAP P, 4-00-022-E
43656

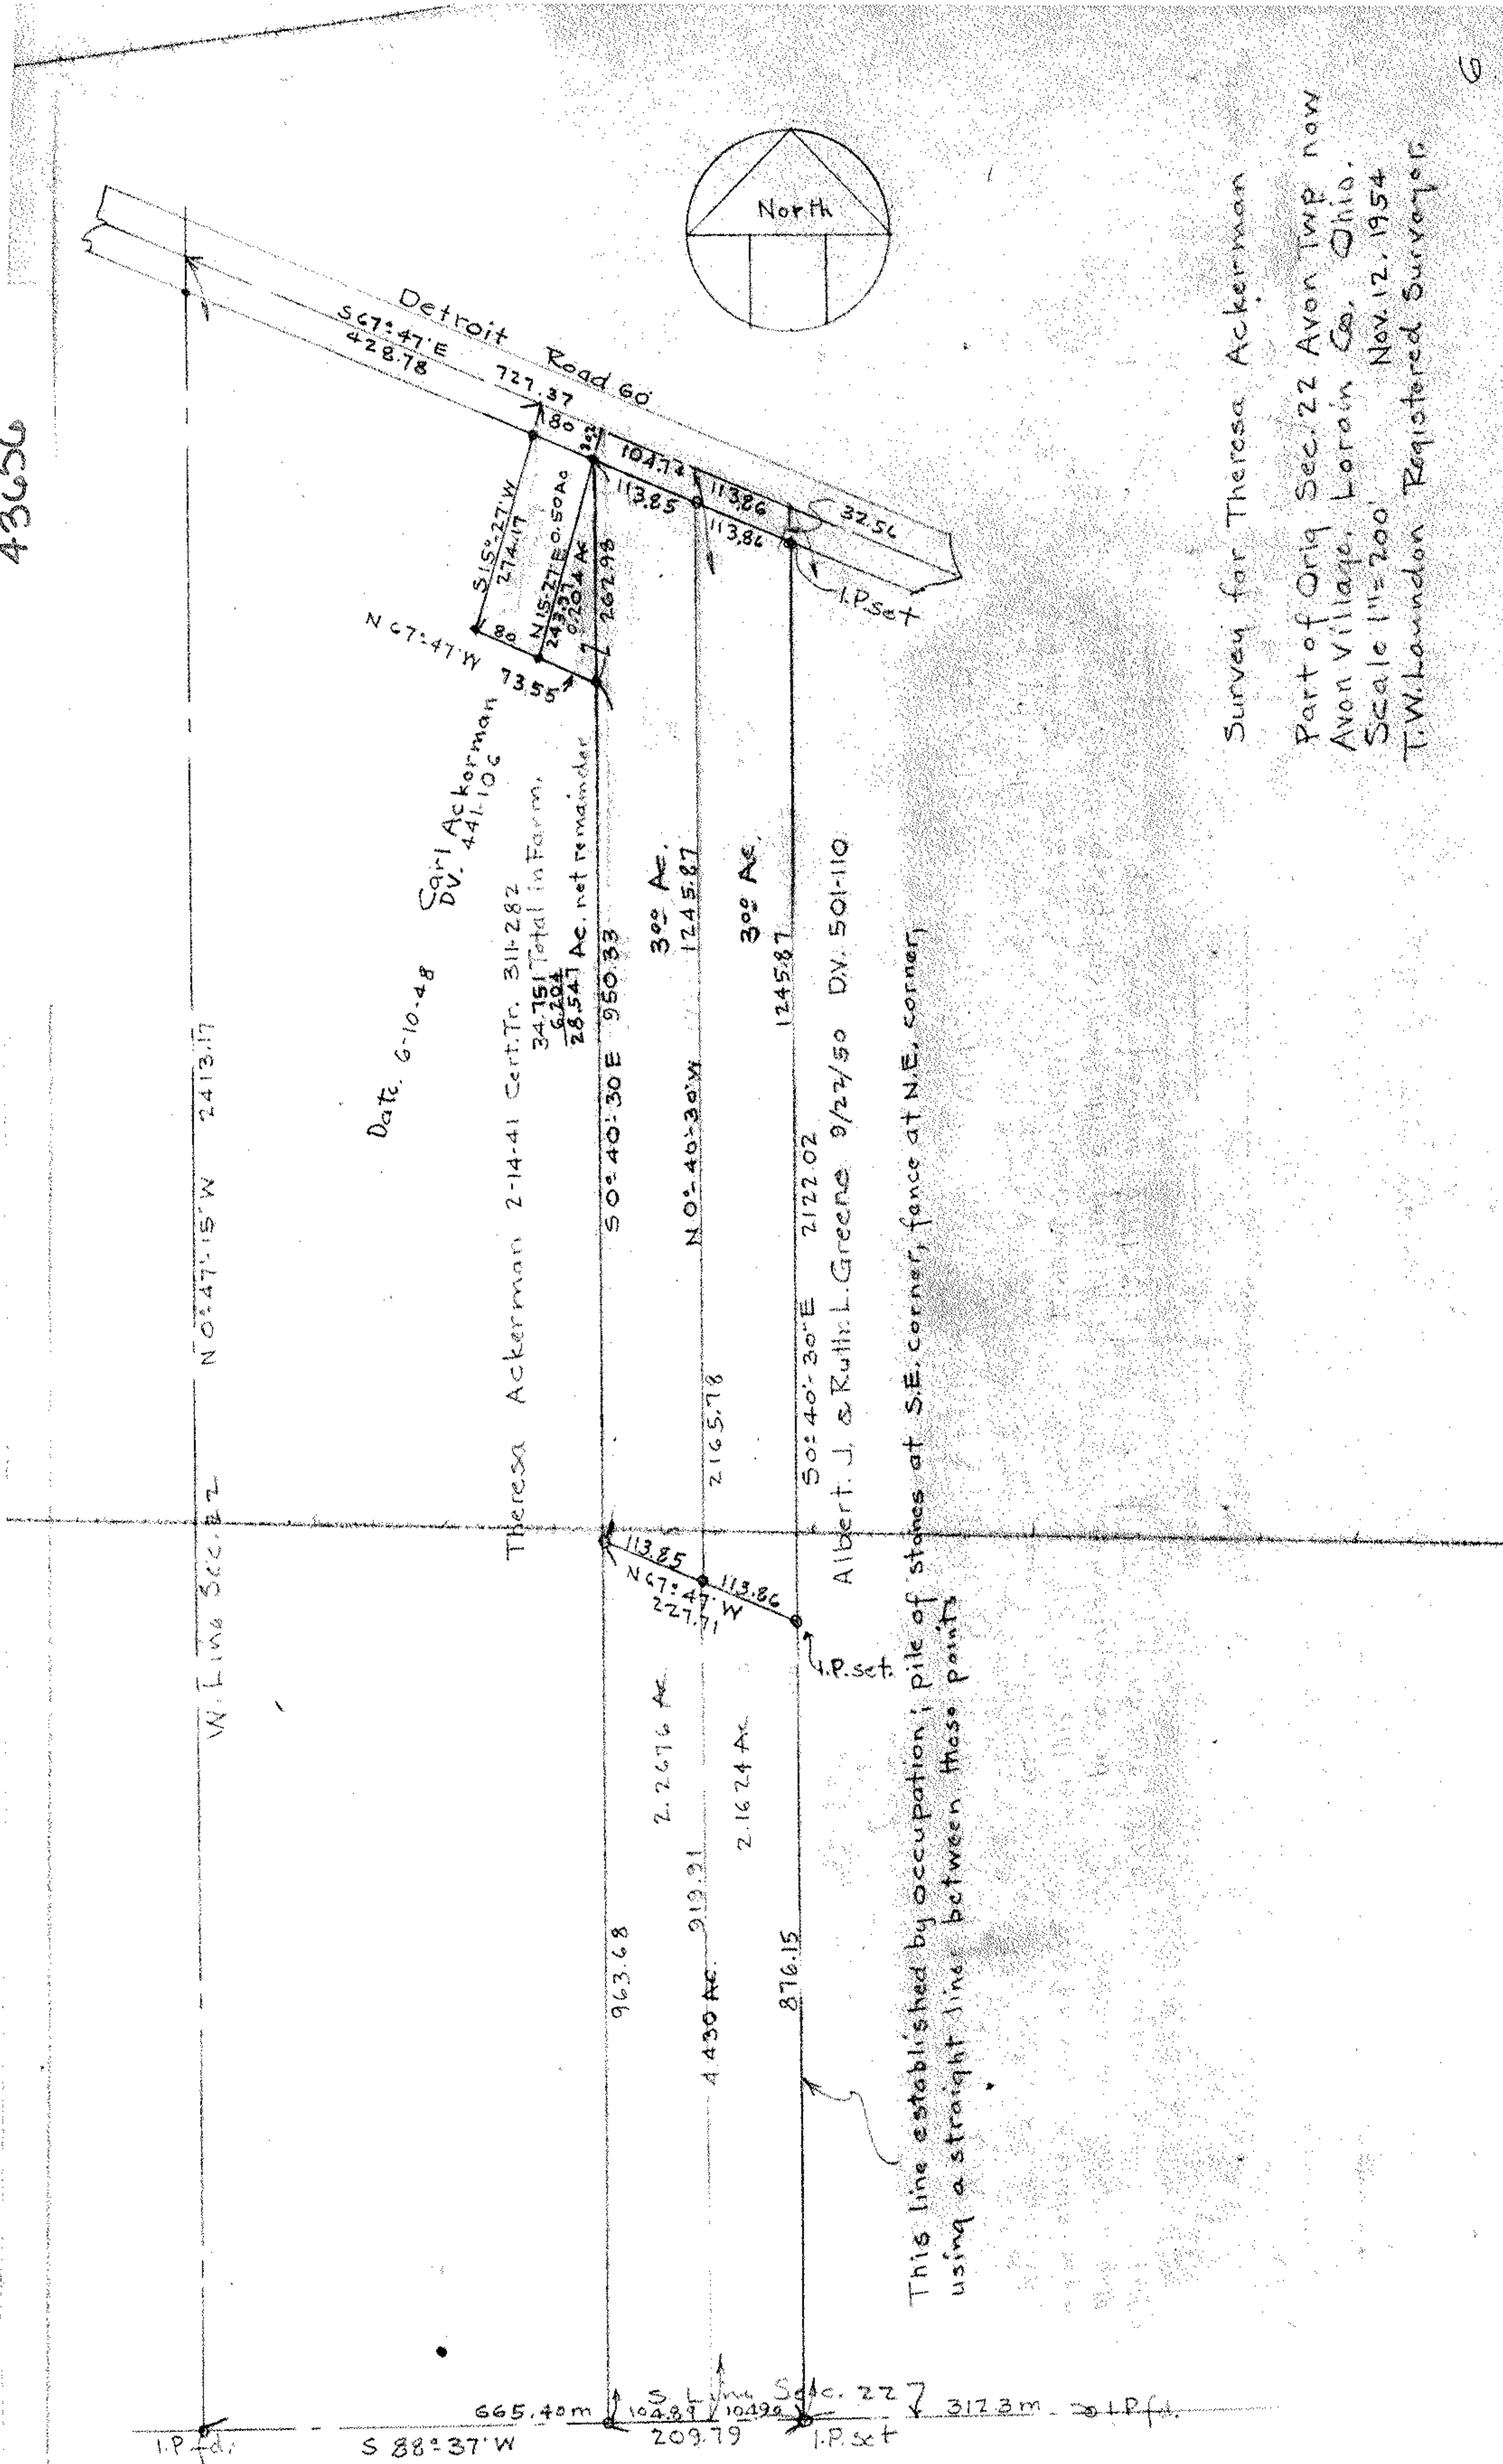

Survey for Theresa Ackerman

Part of Orig. Sec. 22 Avon Twp. now
Avon Village, Lorain Co., Ohio.
Scale 1" = 200' Nov. 12, 1954
T.W. Landon Registered Surveyor