


4-00-011-108-02A
 4-00-011-108-025
 4-00-011-108-045
 4-00-012-103-02A
 4-00-011-H
 4-00-012-D

Survey for
 John B Dechant Hrs.
 Sec 11 & 12 Aron Village
 Scale 1"=200
 Warden & Laundon
 Civil Engineers

Note
 This tracing made
 from Blue Print
 furnished us by
 Lawrence Dechant
 Jan 22, 1931.
 OFF Palmer
 Map Draftsman

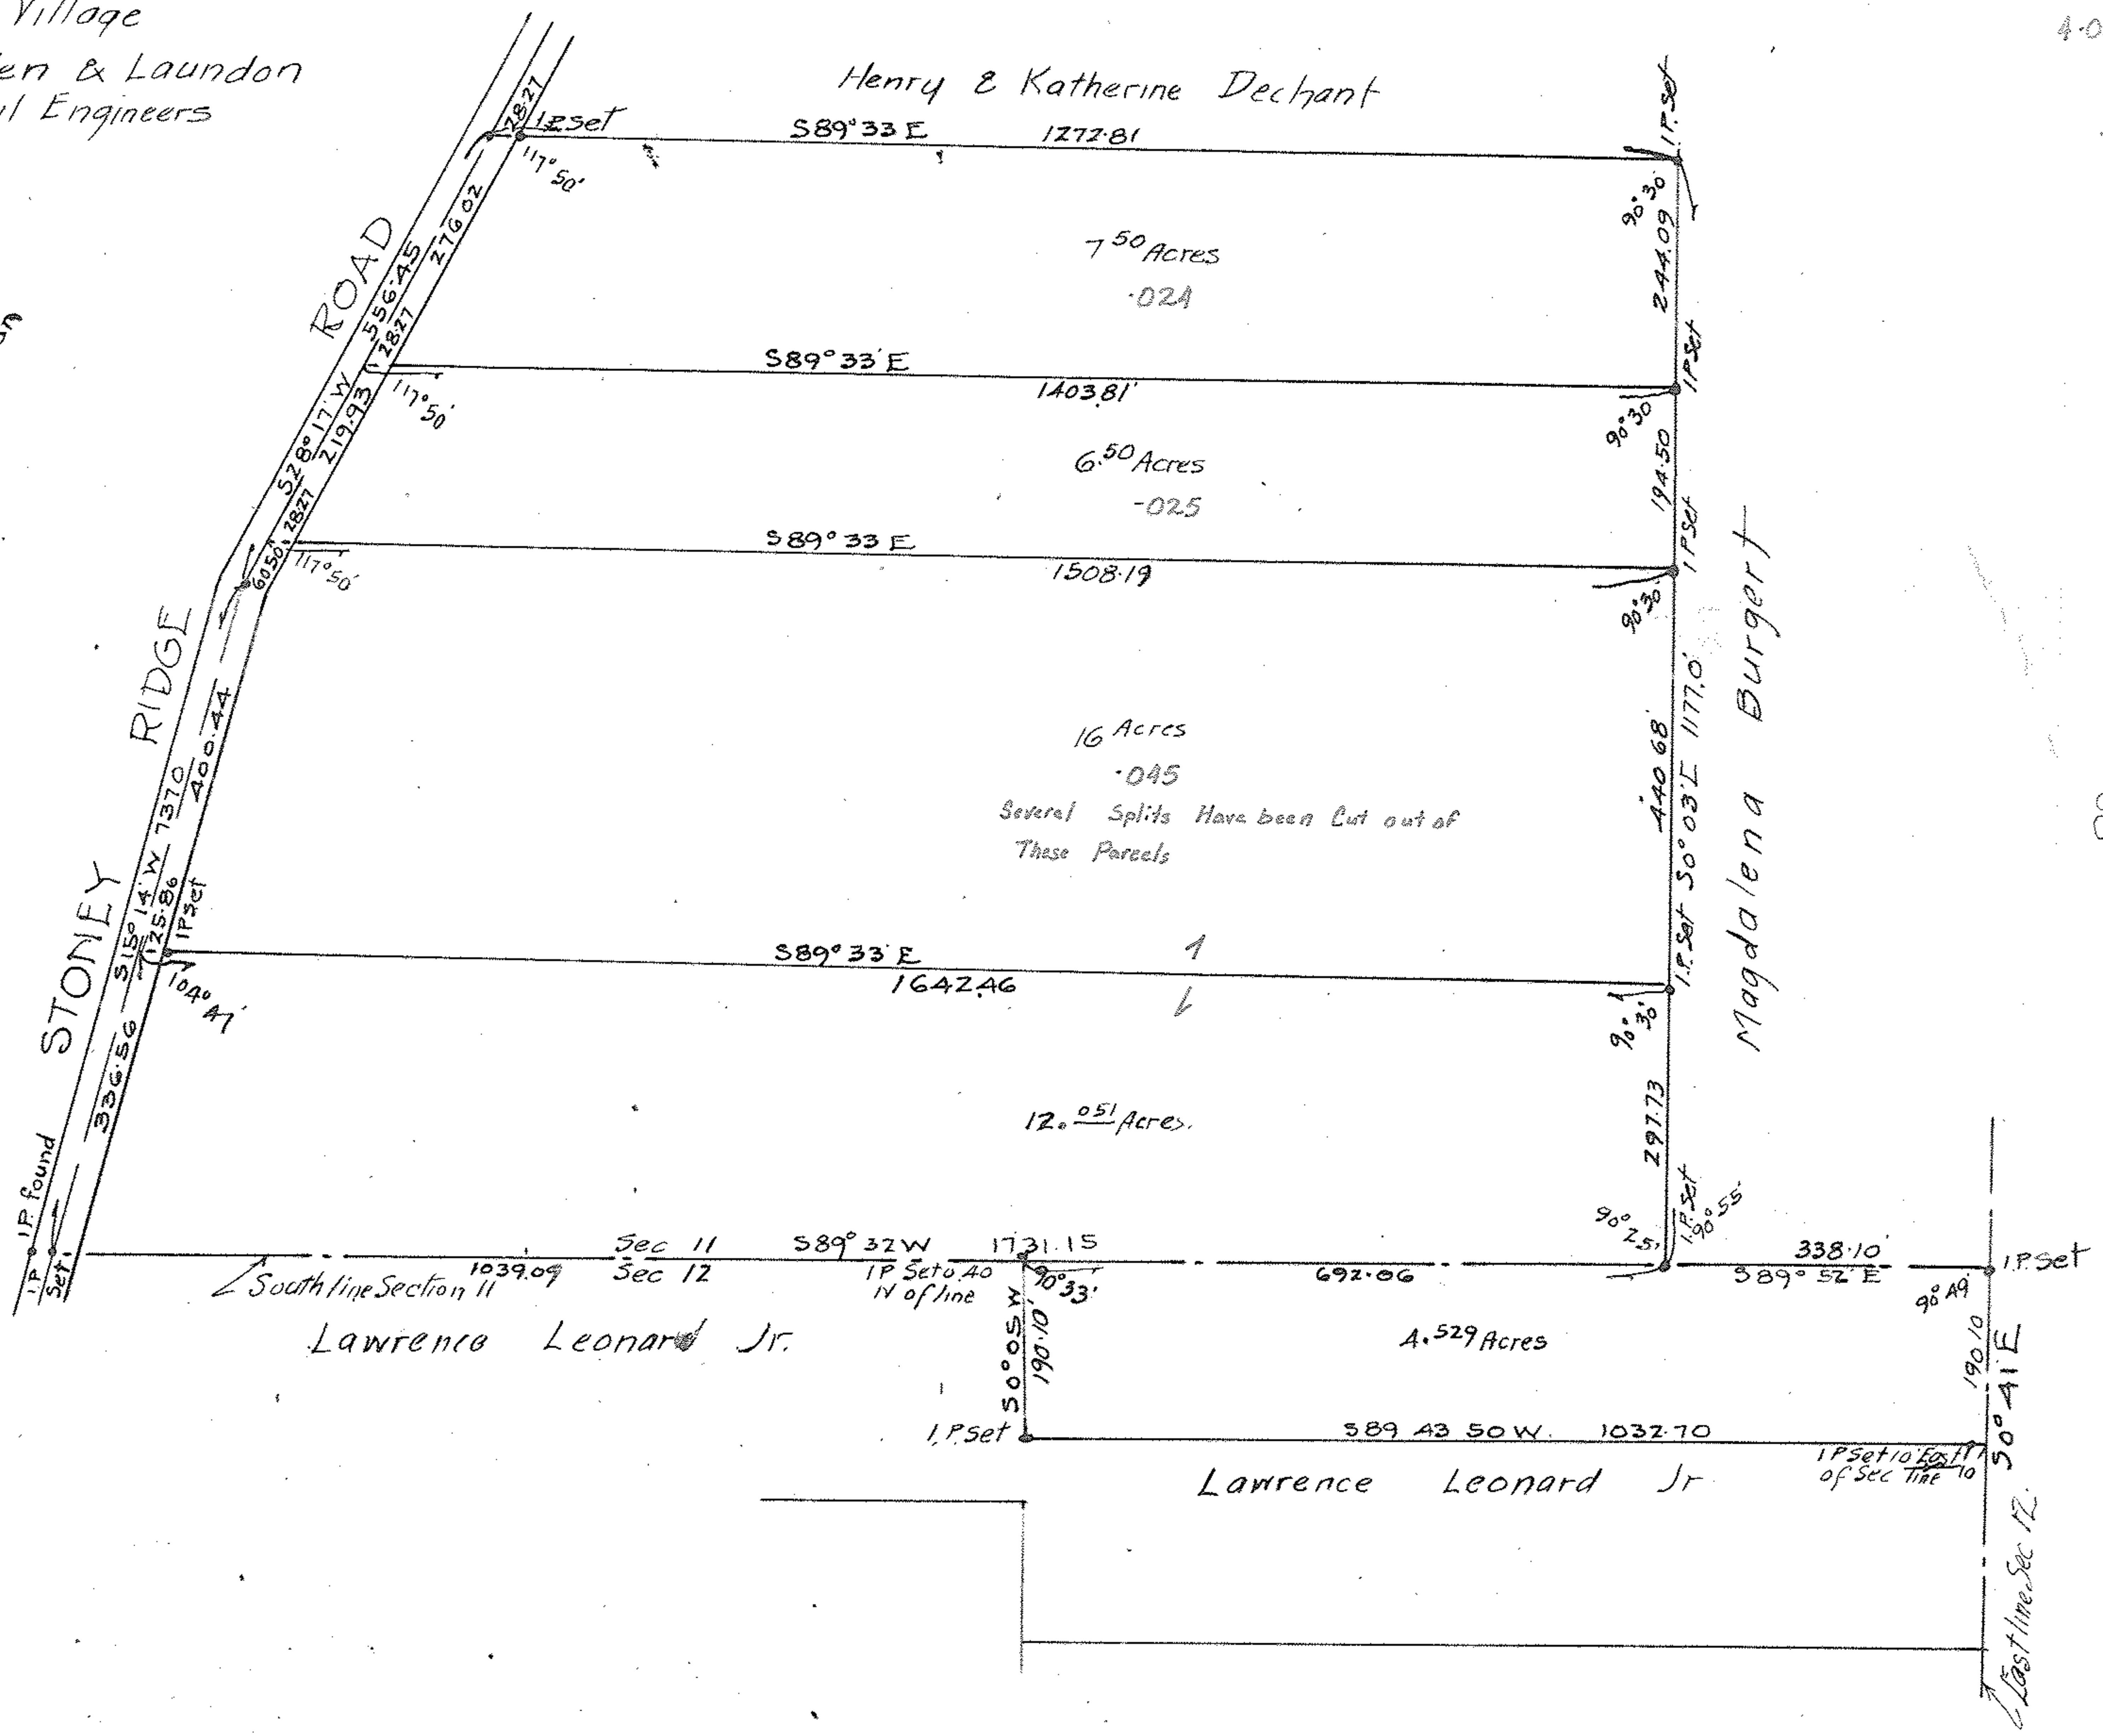

PPN 04-00-011-108-024
 025
 045
 04-00-012-103-024

43659

MAP PG 400-011-H, 04-00-012-D