
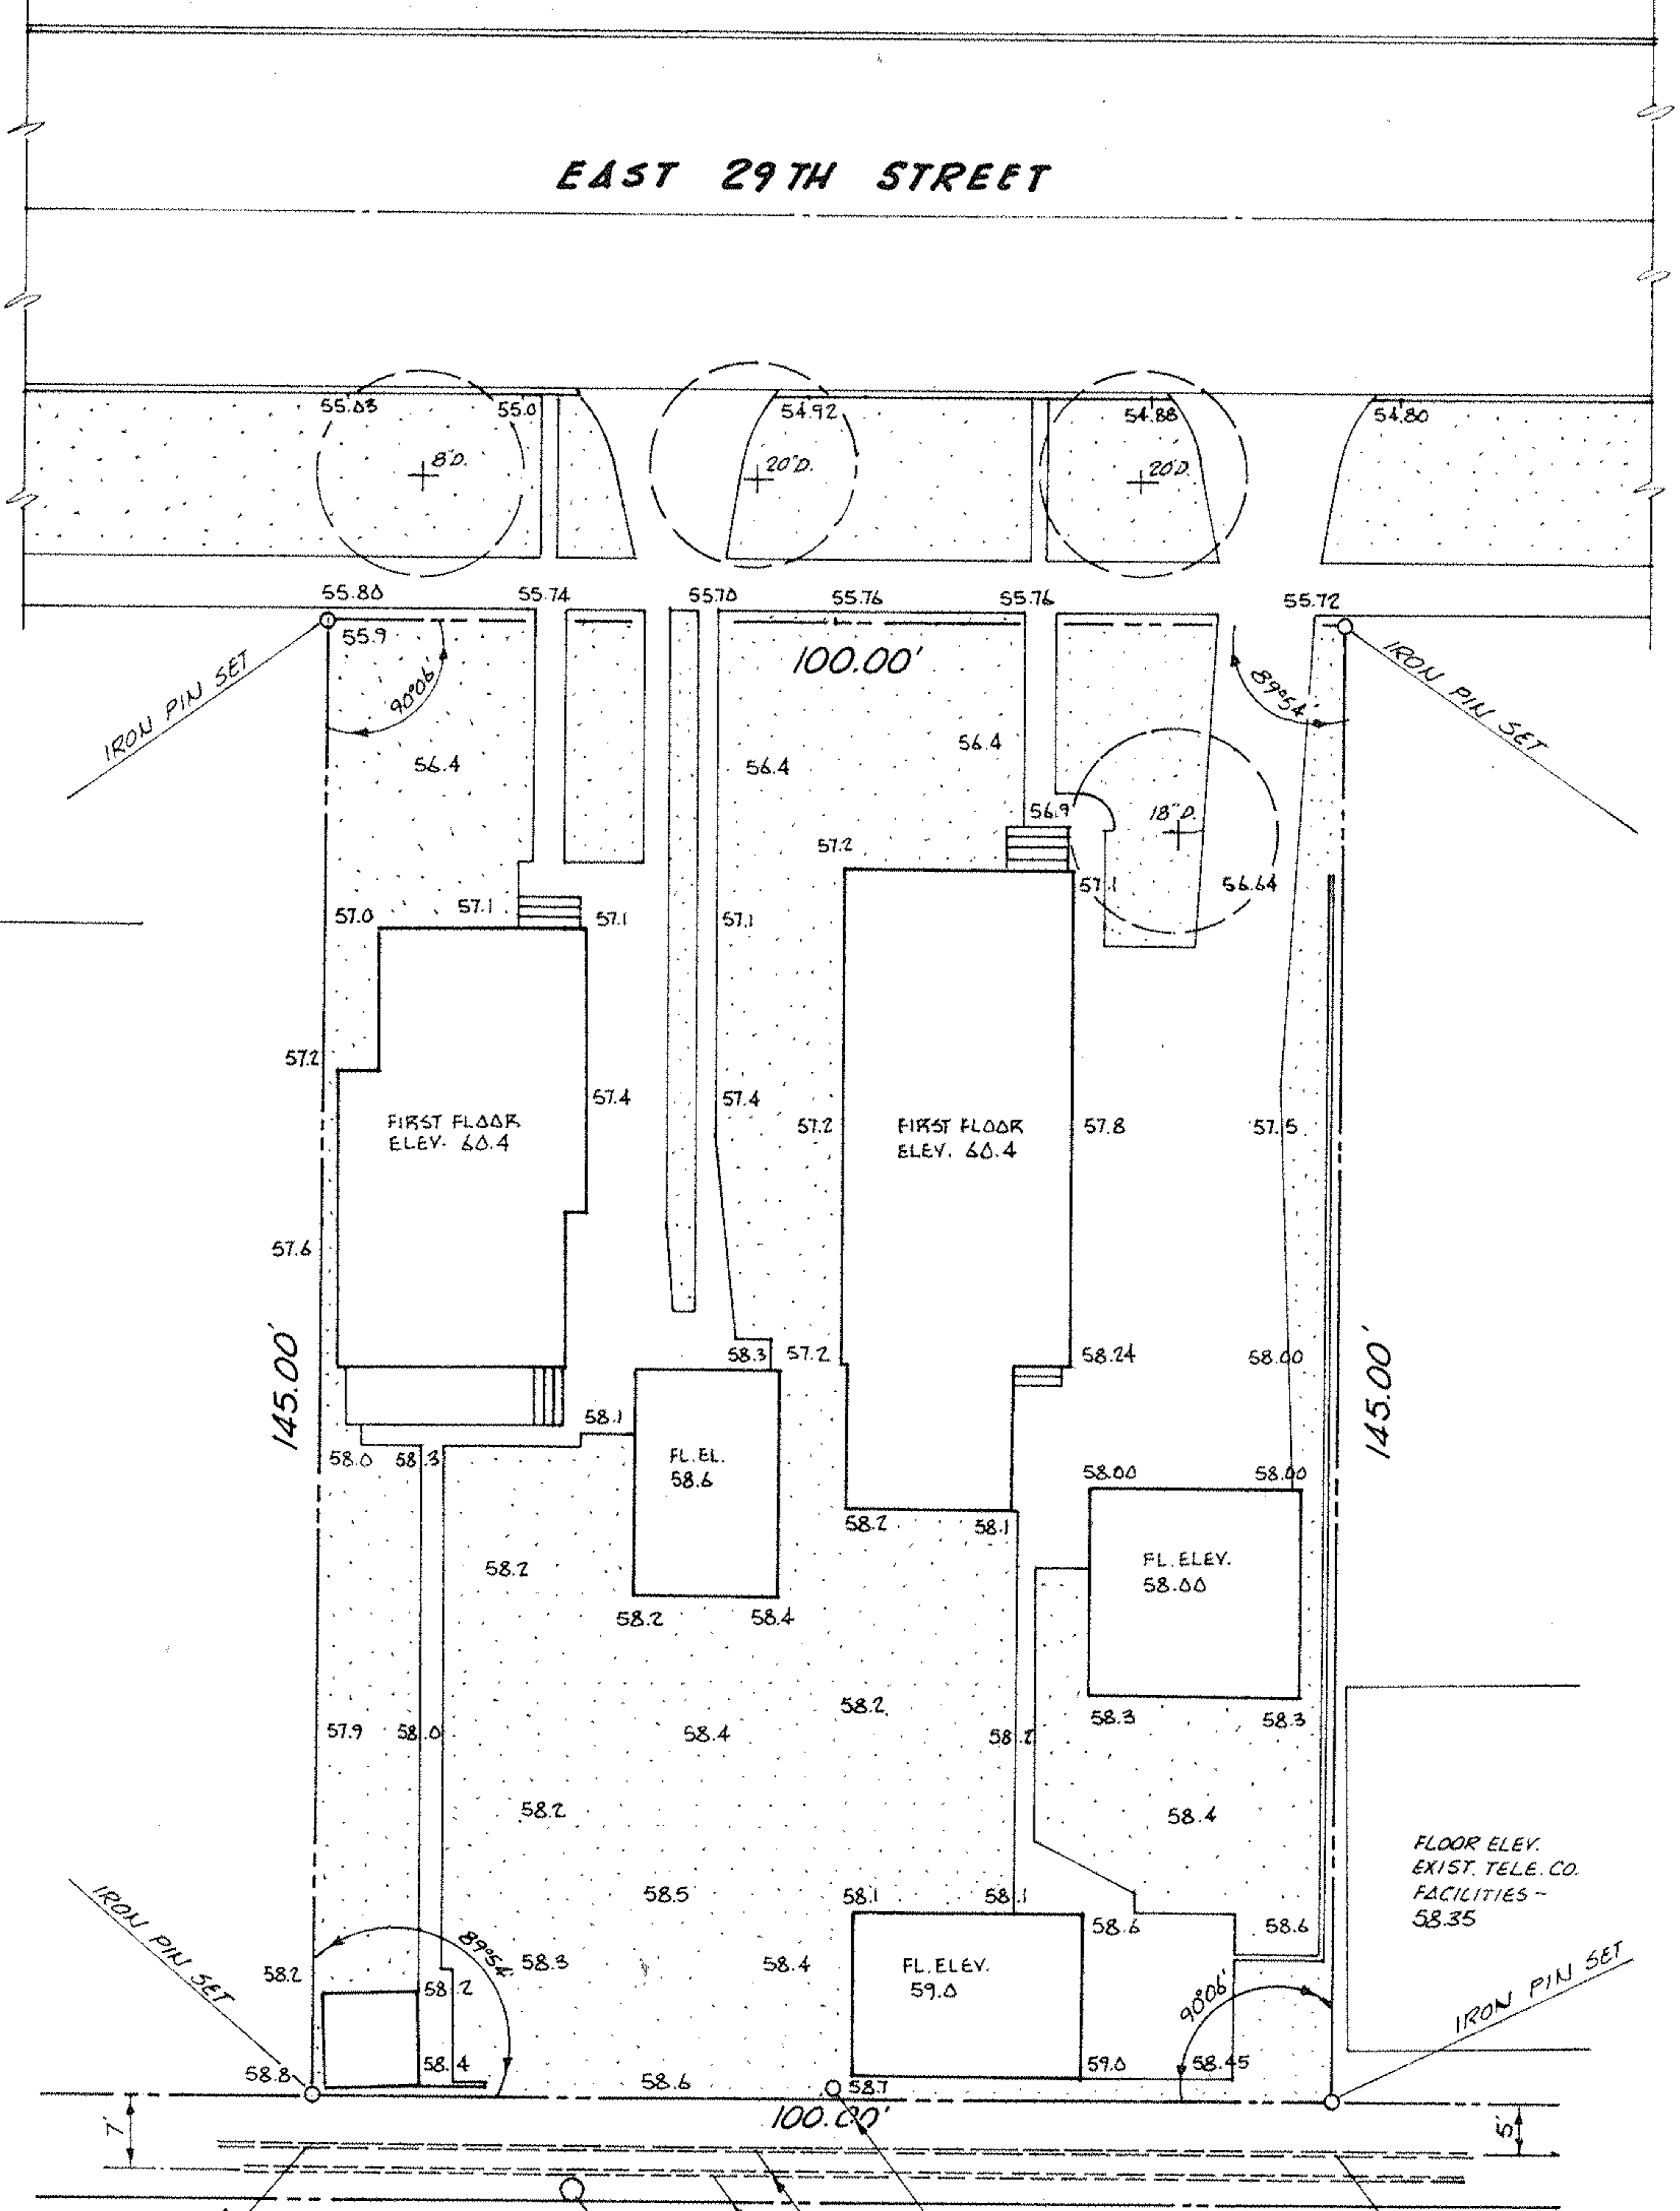


03-00-095-102-015
03-00-095-102-016
3-00-095-A

MAP PG 3-00-095-A
PPN 03-00-095-102-015
016


43064

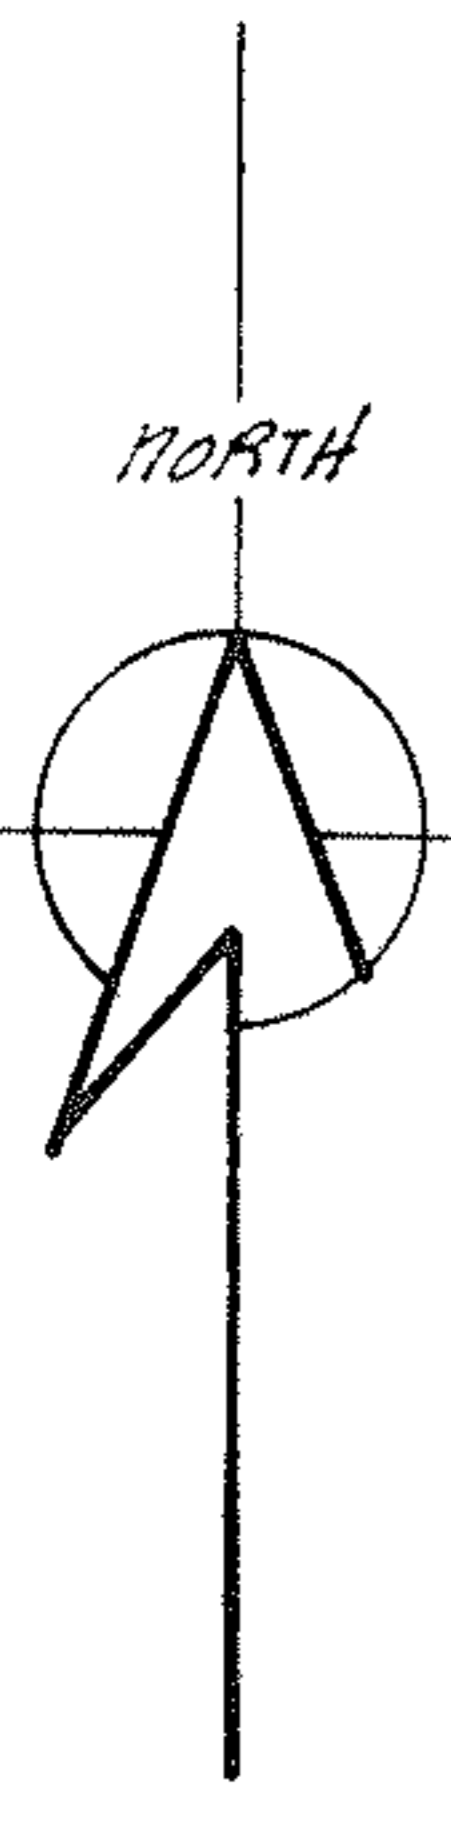

INV. EL. 49.32
UTILITY POLE - SERVICES BOTH EXISTING HOMES WITH POWER & TELE.
EXIST. GAS SHUT-OFF SERVICE FROM ALLEY
EXISTING 8" V.C. SAN. SEWER
EXISTING 6" C.I. WATERLINE
INV. EL. 49.75

BENCH MARK:
TOP OF IRON PIN NORTHEAST CORNER,
ELEV. 55.81
BENCH MARK:
TOP OF IRON PIN SOUTHEAST CORNER,
ELEV. 58.41

TOPOGRAPHIC & PHYSICAL FEATURES
SUBLOTS 319 & 320 - SHEFFIELD
LAND CO.'S SUBDIVISION N:1
CITY OF LORAIN, LORAIN CO., OHIO

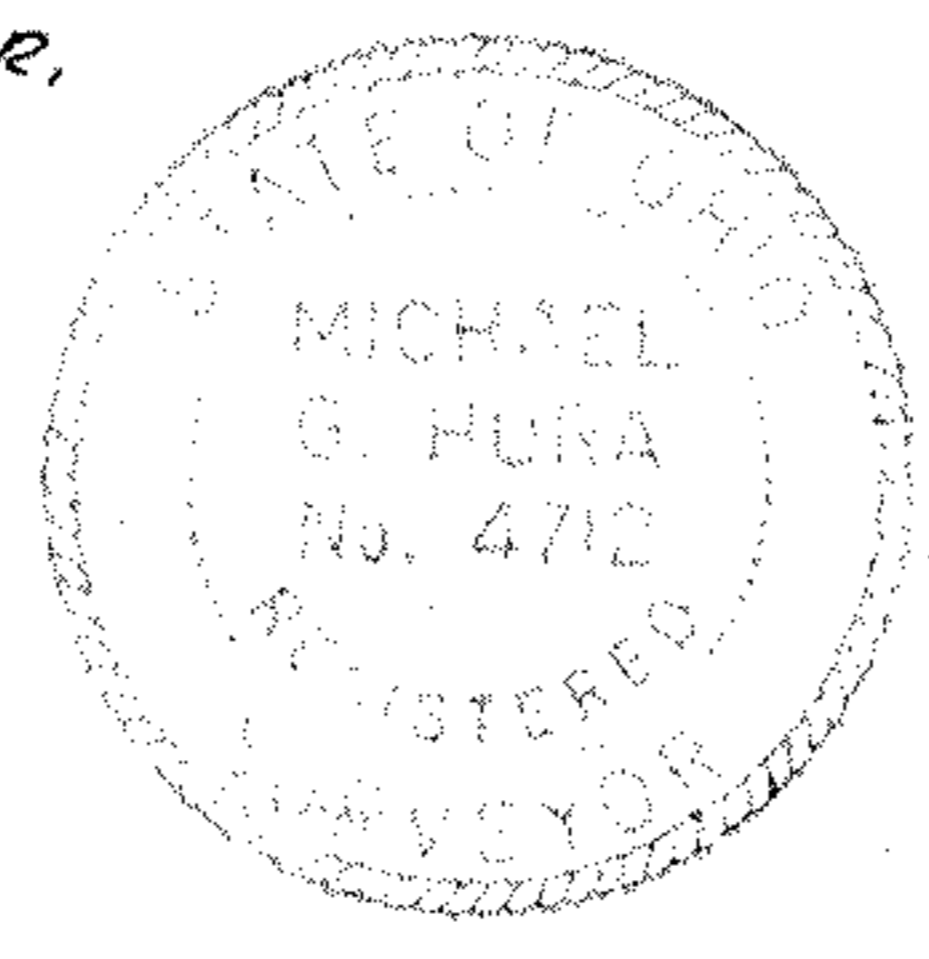

MARCH 1973 SCALE 1" = 20'