03-00-074-102
3-00-073-A

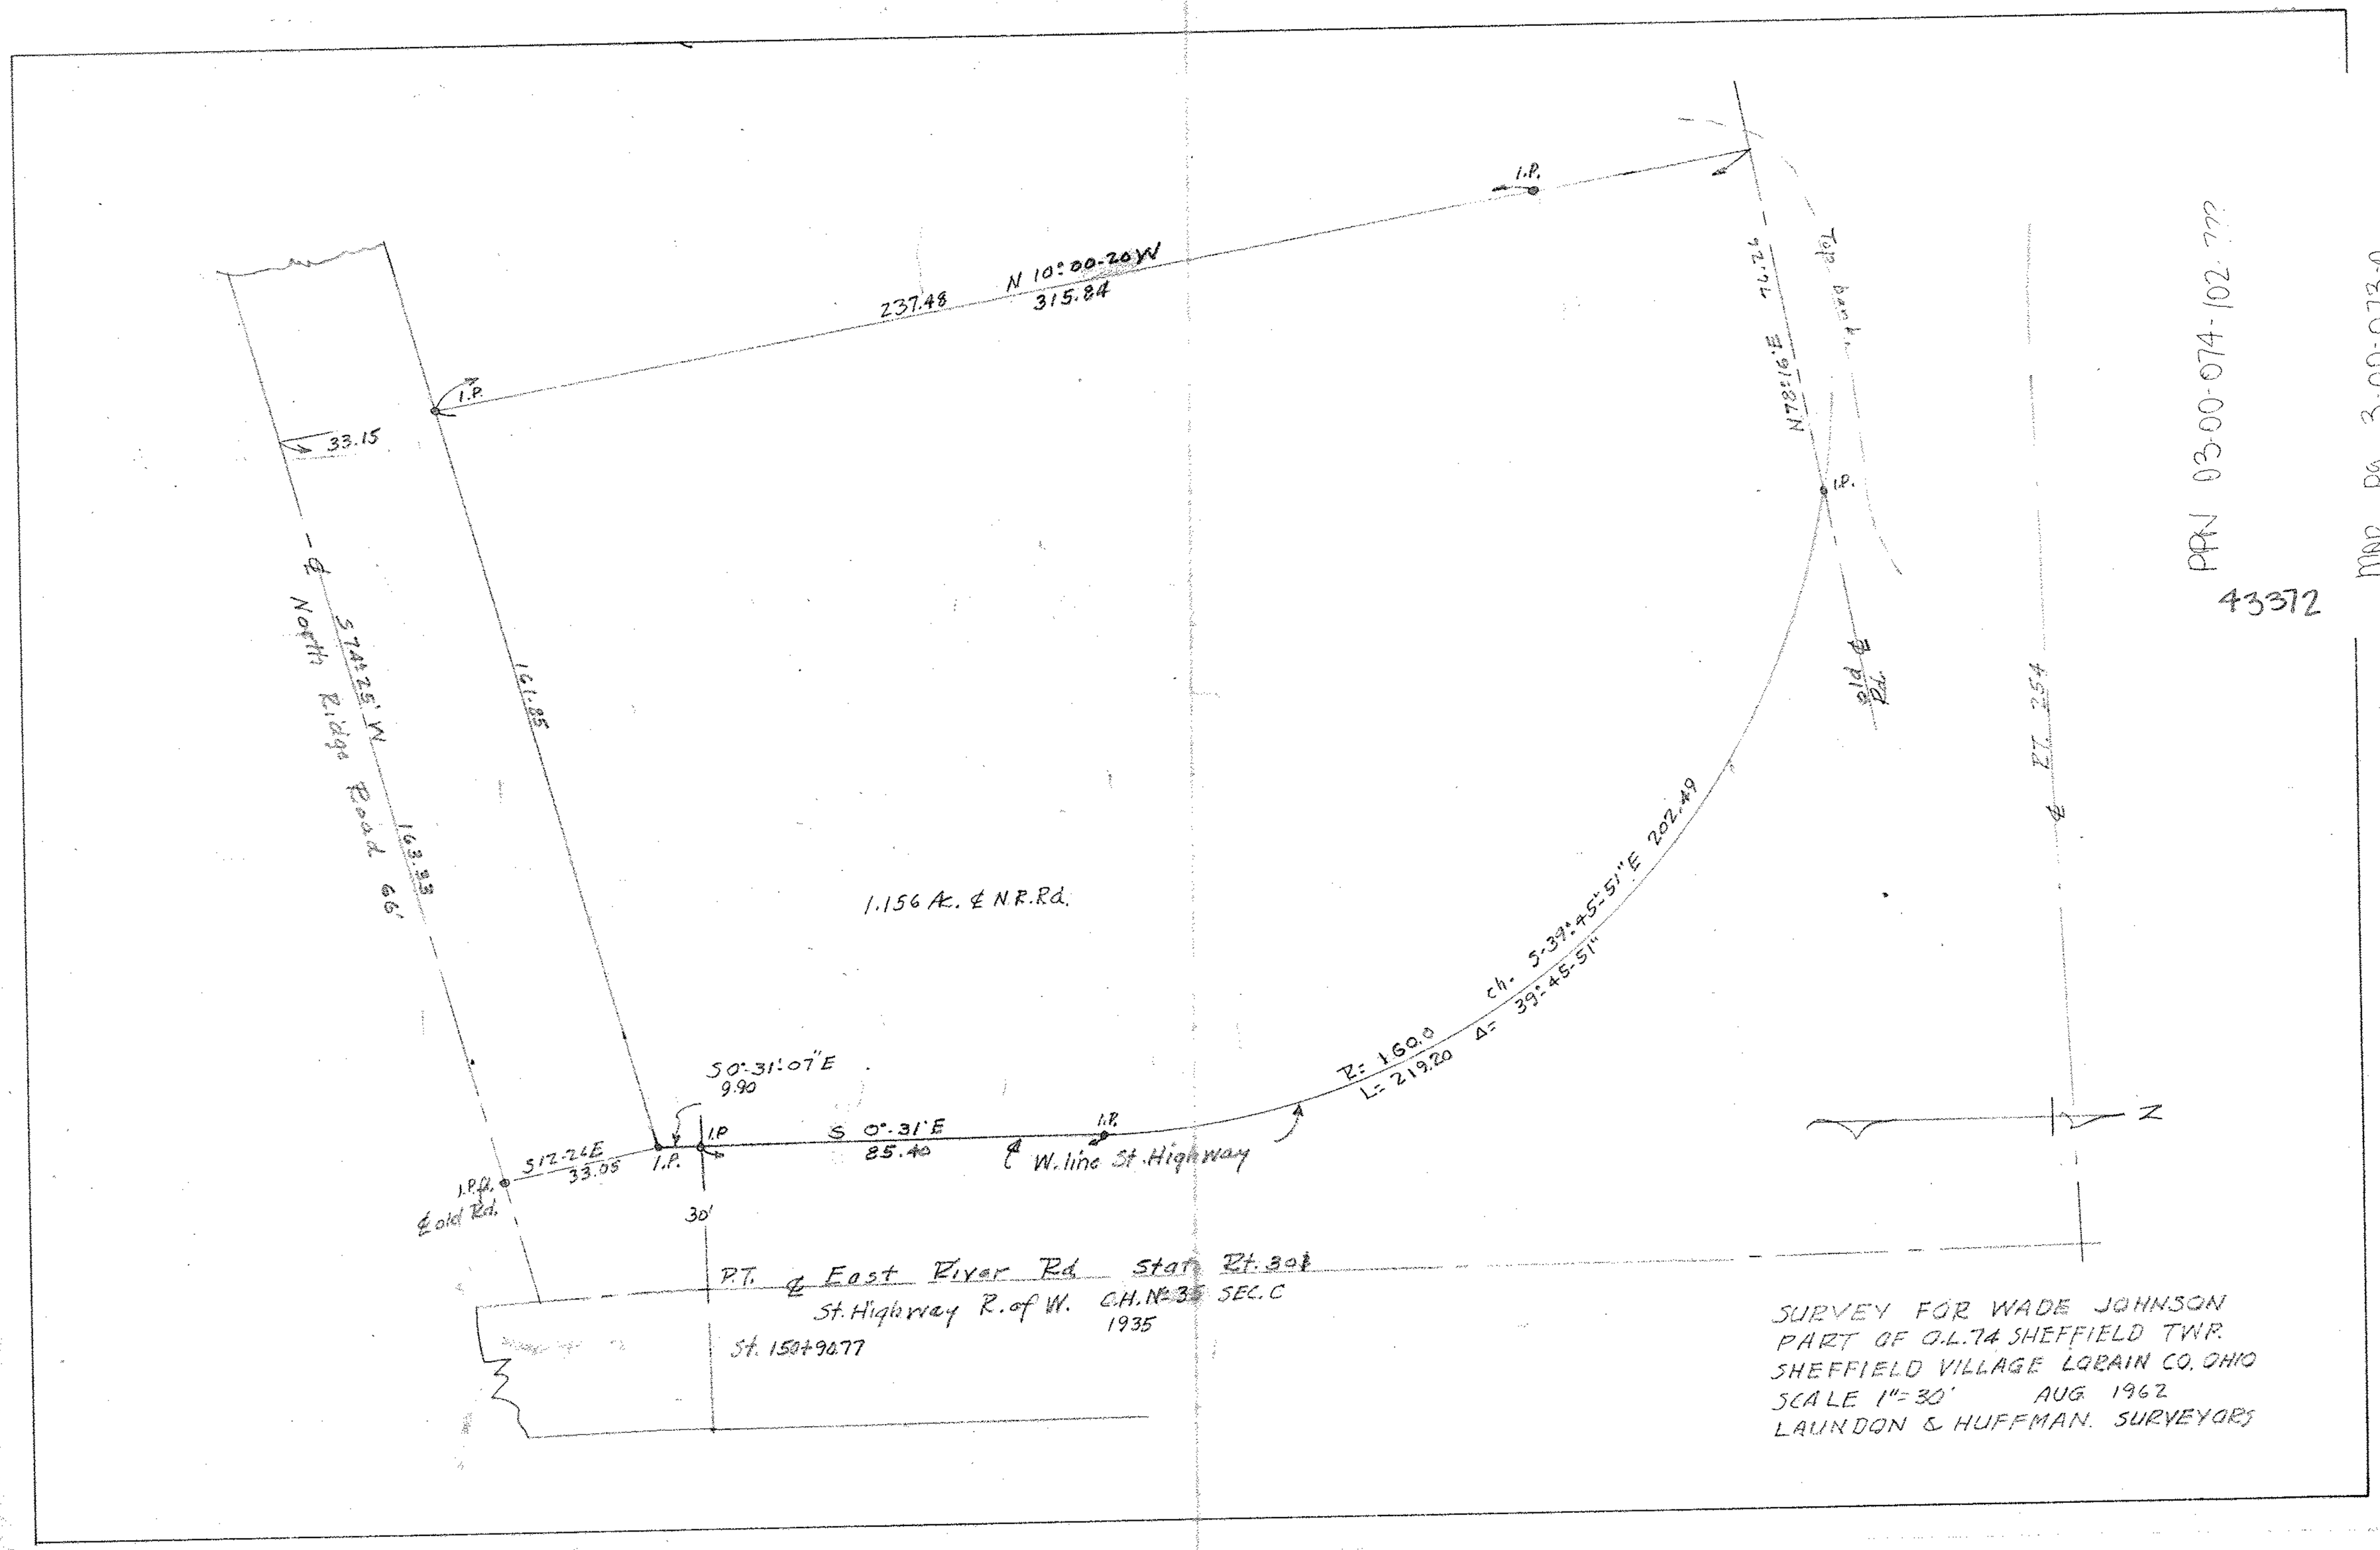

SURVEY FOR WADE JOHNSON
PART OF O.L. 74 SHEFFIELD TWP.
SHEFFIELD VILLAGE LORAIN CO. OHIO
SCALE 1"=30' AUG 1962
LAUNDON & HUFFMAN. SURVEYORS

PPN 03-00-074-102 ???
43372
MAP PG 3-00-073-A