


MAP PG 3-00-073-A
FPN 03-00-073-102-005

43373

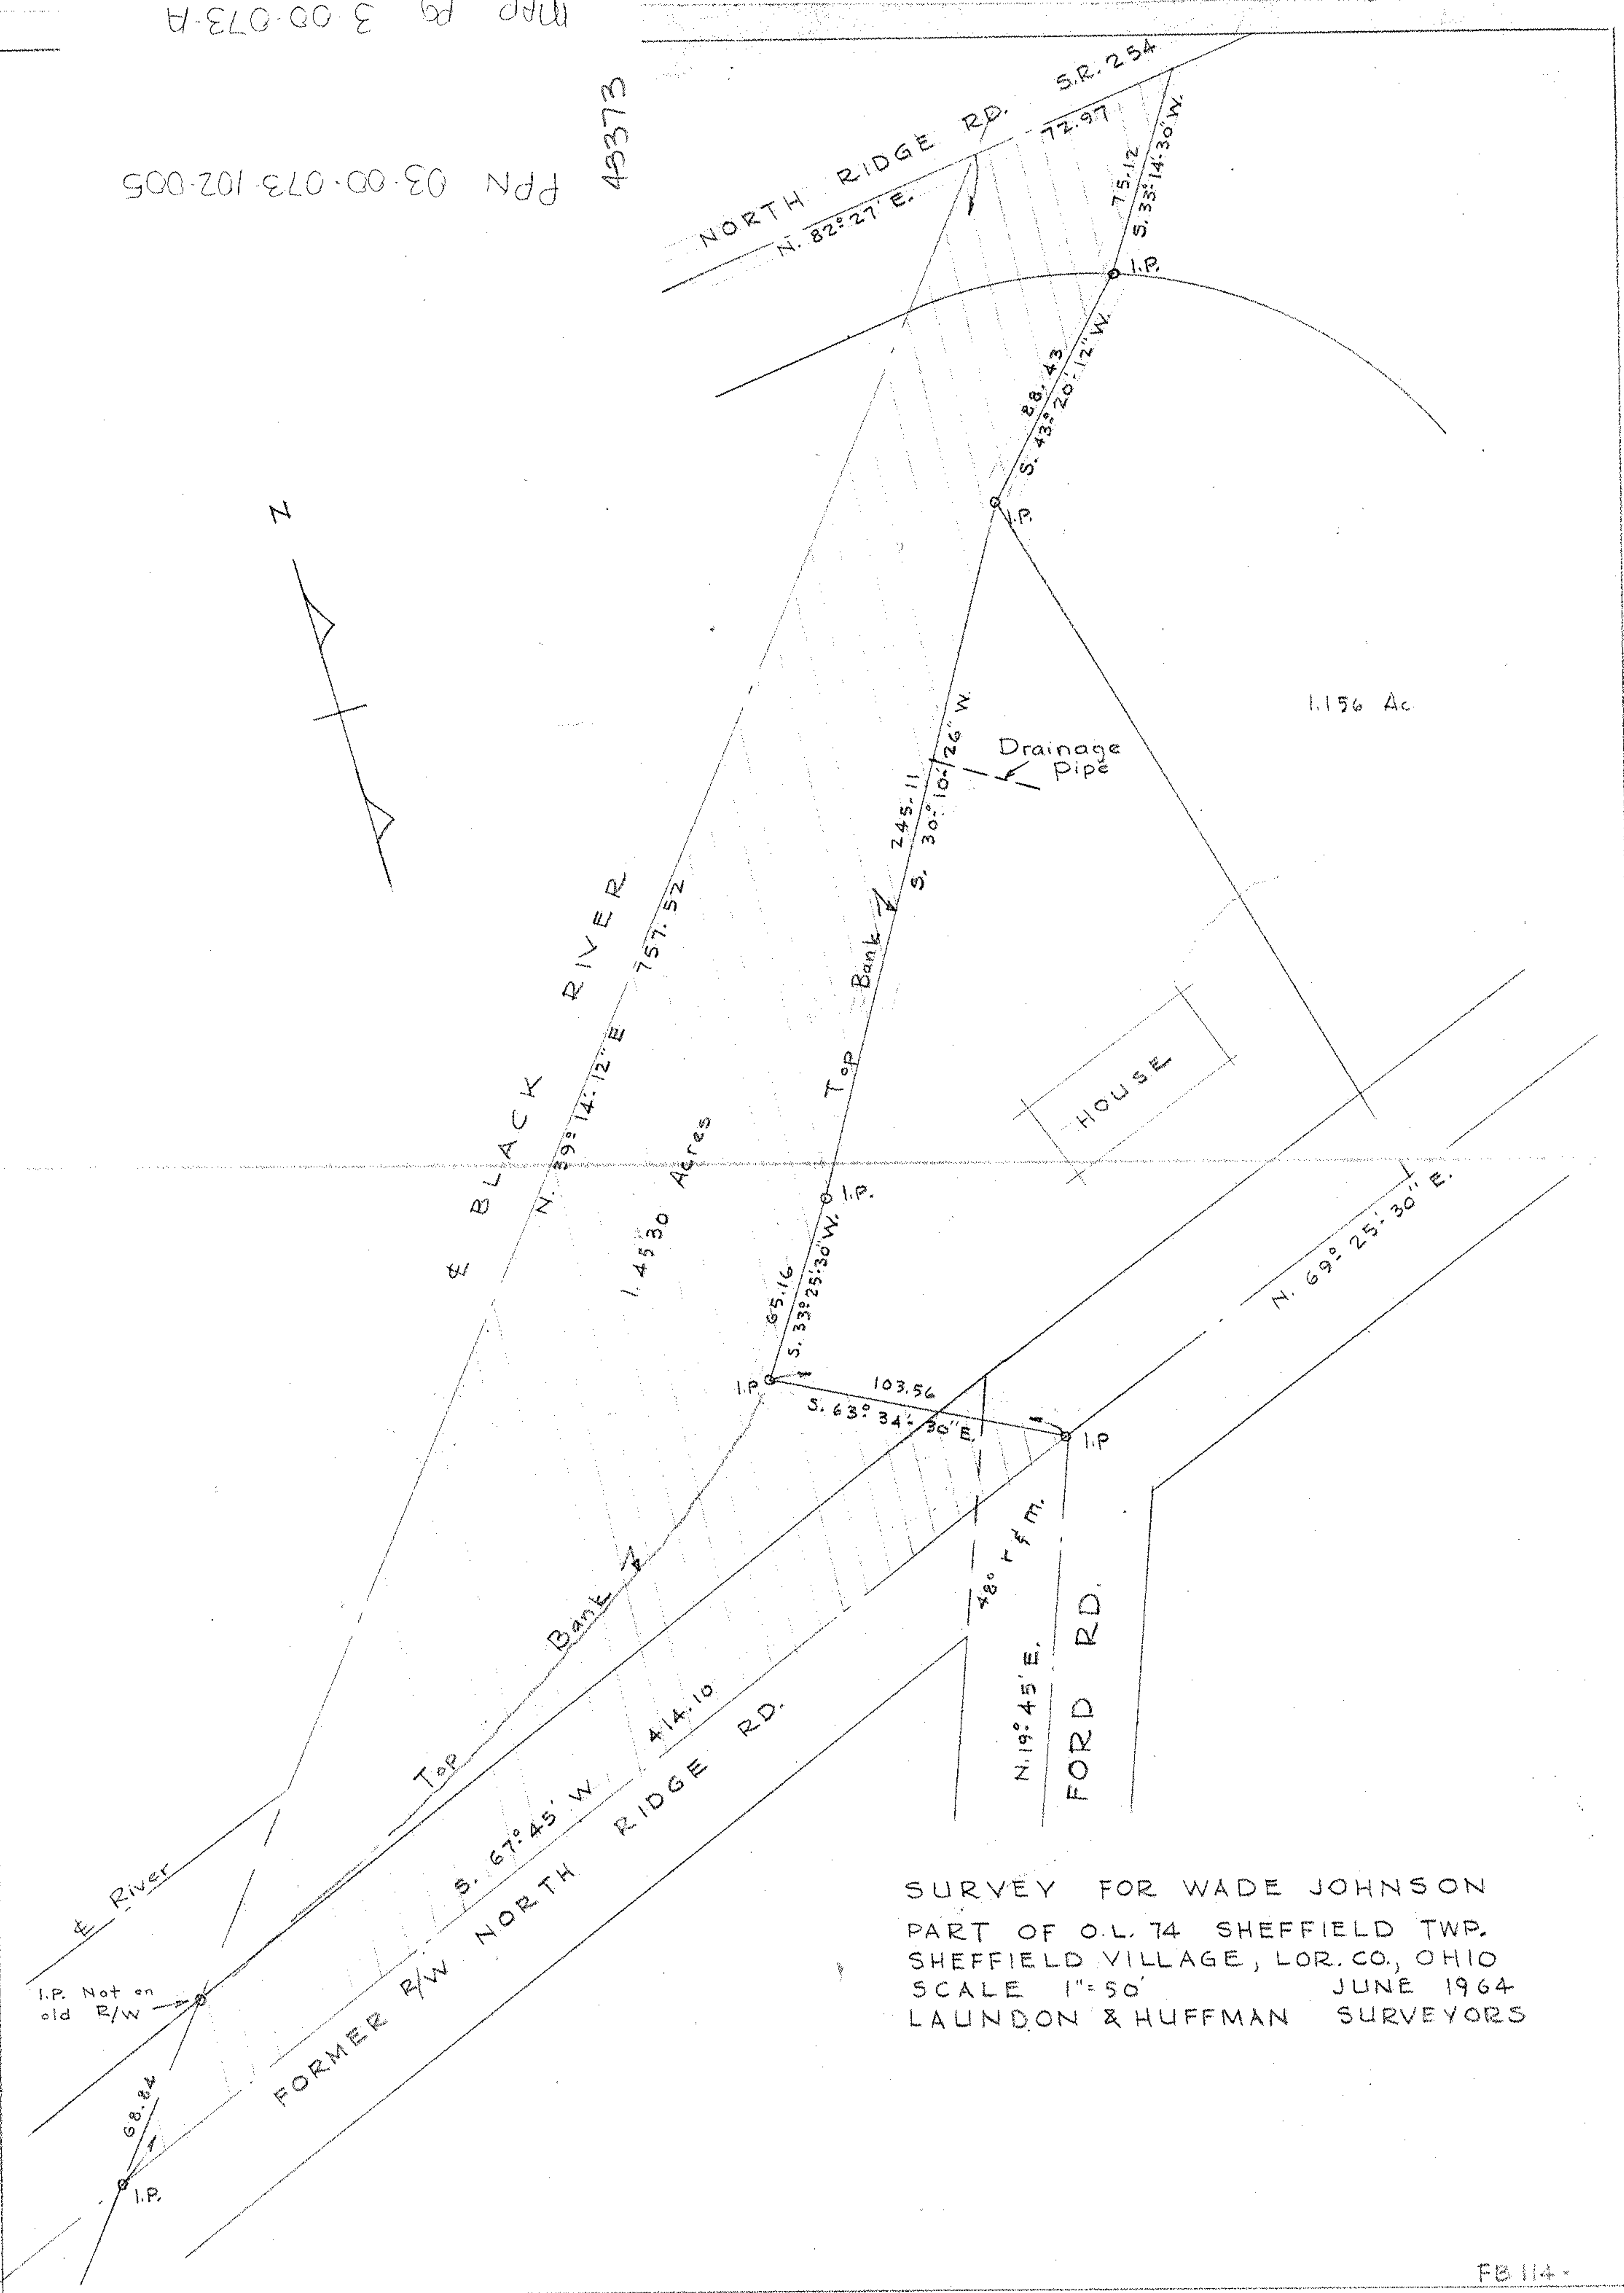

SURVEY FOR WADE JOHNSON
 PART OF O.L. 74 SHEFFIELD TWP.
 SHEFFIELD VILLAGE, LOR. CO., OHIO
 SCALE 1"=50' JUNE 1964
 LAUNDON & HUFFMAN SURVEYORS

I.P. Not on
old R/W