03-00-073-000
03-00-074-101
3-00-073-A

PN 93-00-073.000 ???

43374

PN 3-00-073.A

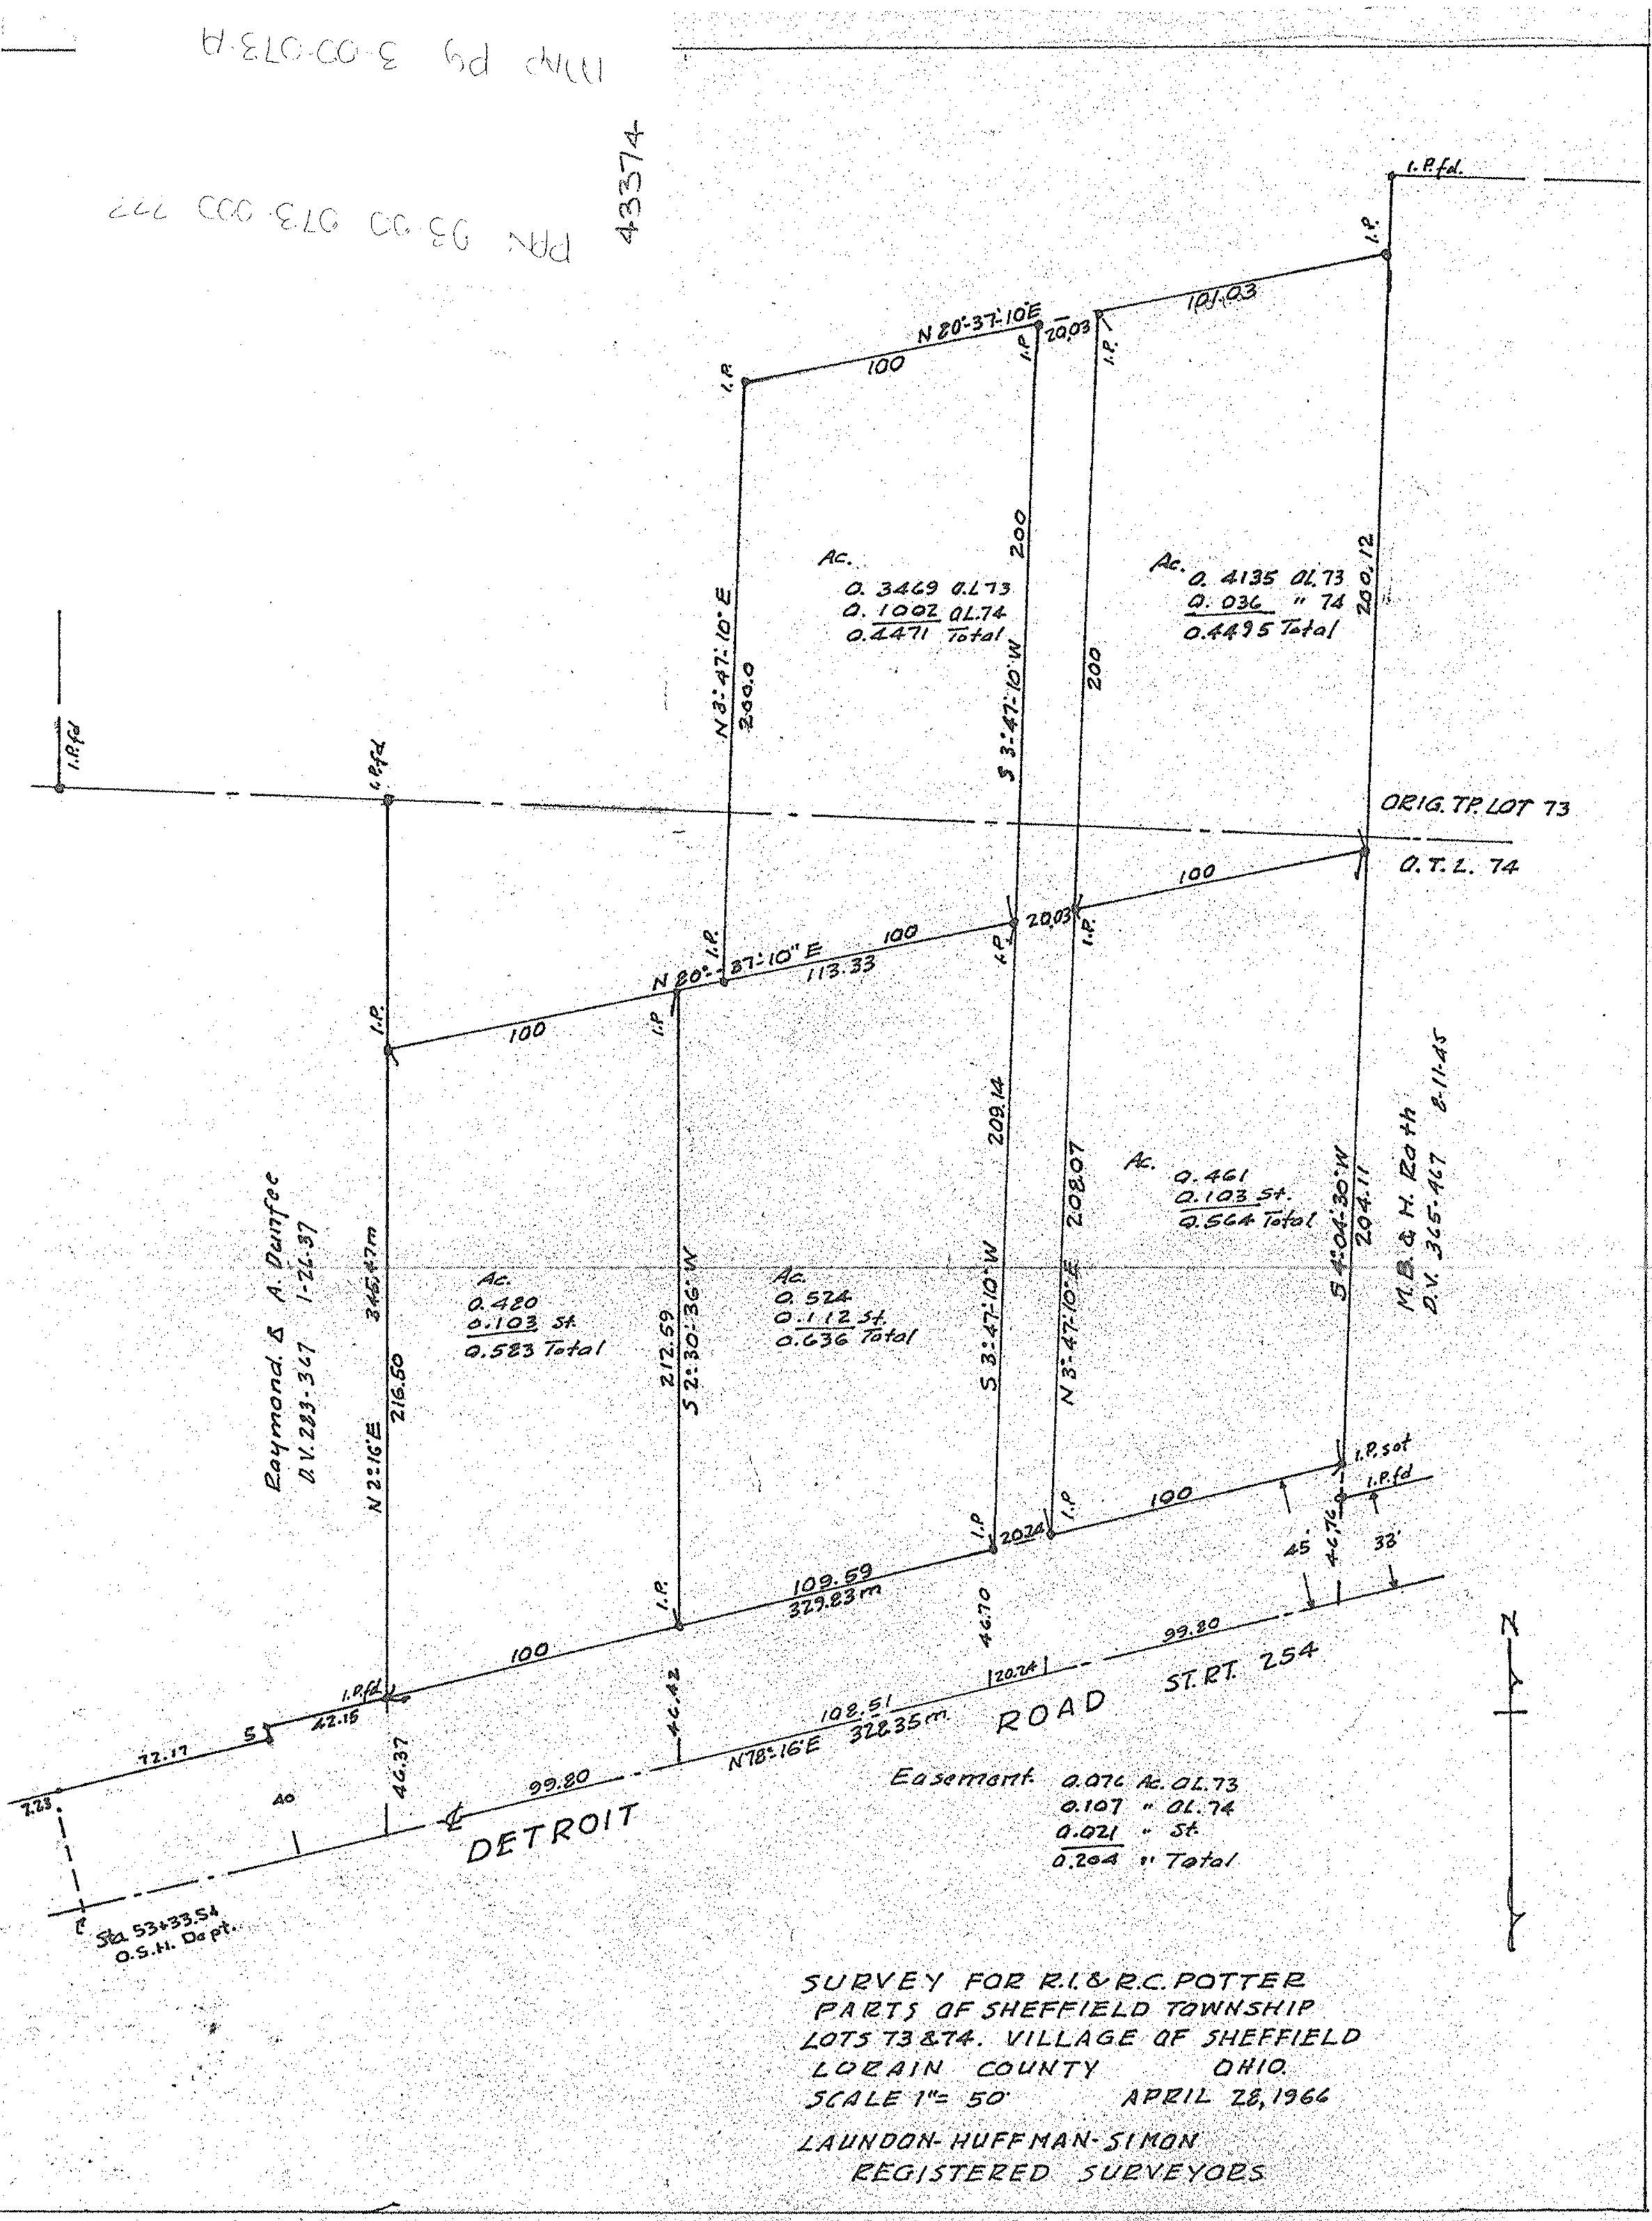


SURVEY FOR R.I. & R.C. POTTER
PARTS OF SHEFFIELD TOWNSHIP
LOTS 73 & 74. VILLAGE OF SHEFFIELD
LORAIN COUNTY OHIO.
SCALE 1"= 50' APRIL 28, 1966

LAUNDON-HUFFMAN-SIMON
REGISTERED SURVEYORS