
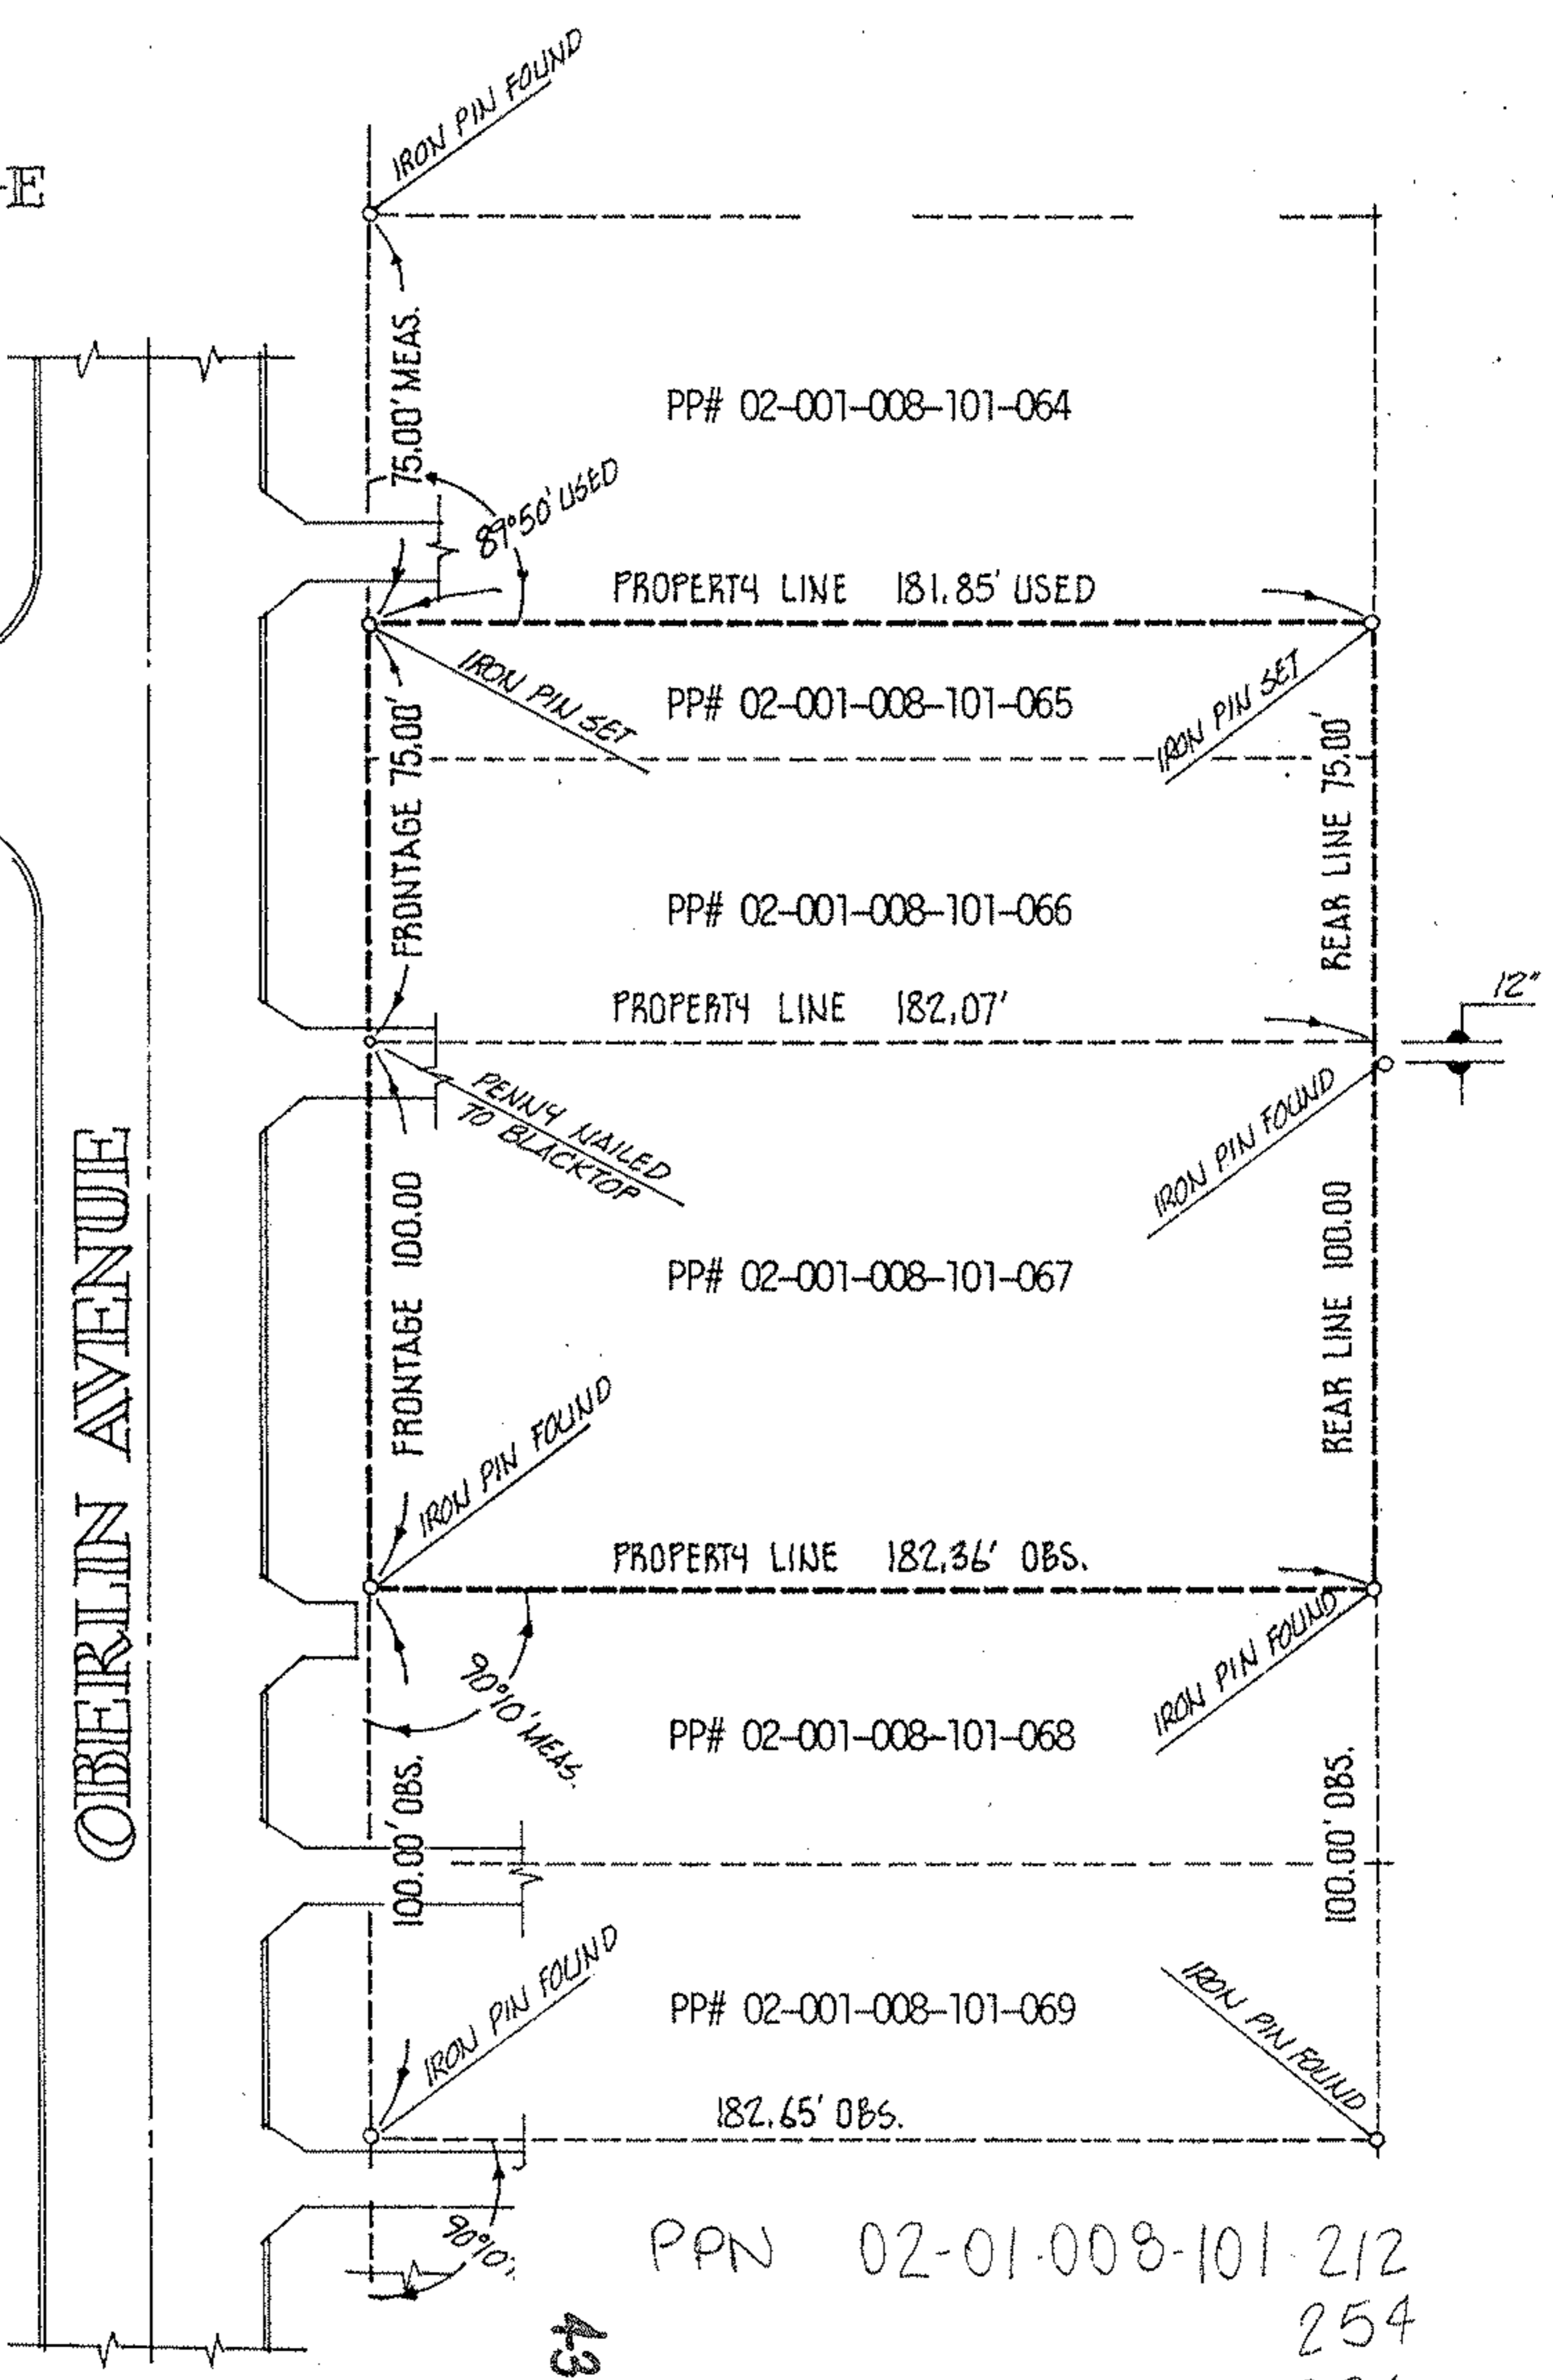


212
254
236
208
2-01-008-B

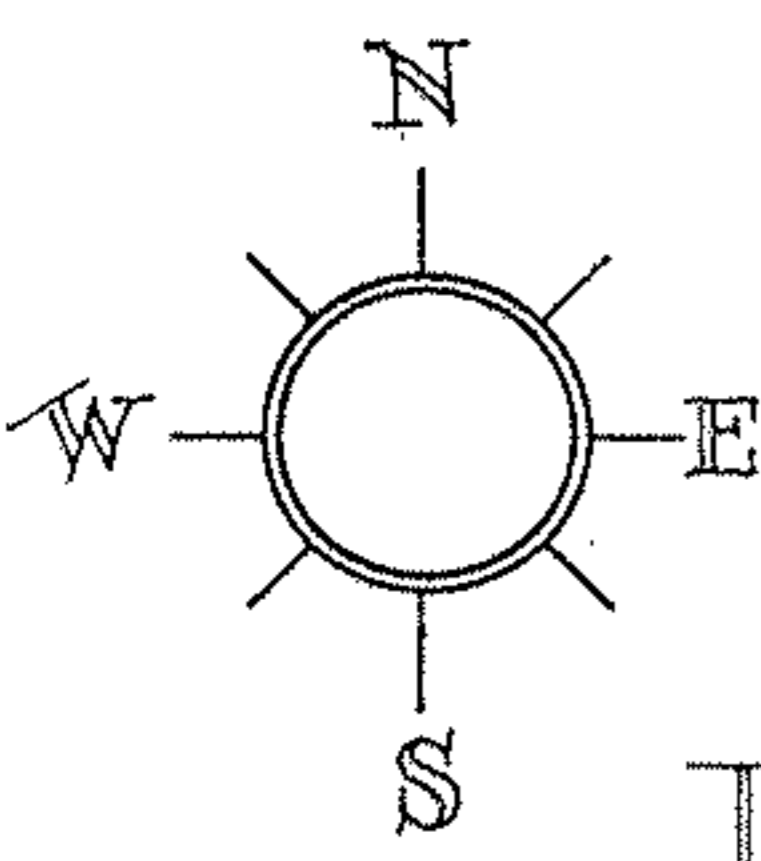

OBERLIN AVENUE

43389

PPN 02-01-008-101-212
254
236

MAP PG 2-01-008-B

ACREAGE
DATE 10-22-86
DRAWN MGH
SCALE 1" = 50 ft.

PREPARED FOR DR. JUN LAI SUN 282-7679
5305 OBERLIN AVE., LORAIN

MICHAEL G. HURA, registered surveyor
12706 MASON RD., VERMILION, O., Ph (216) 965 4040

CITY OF LORAIN

PERIMETER SURVEY

SUBLOT(s) MISC. ACREAGE of _____
Volume _____ Page _____ of PLATS
PART OF O.L. 8 TRACT 1 SECTION _____ OF
BLACK RIVER TOWNSHIP LORAIN CO., OHIO
PERMANENT PARCEL No 2-01-008-101-065
066
067



2-01-008-B 02-01-008-101-212, 254, 236