
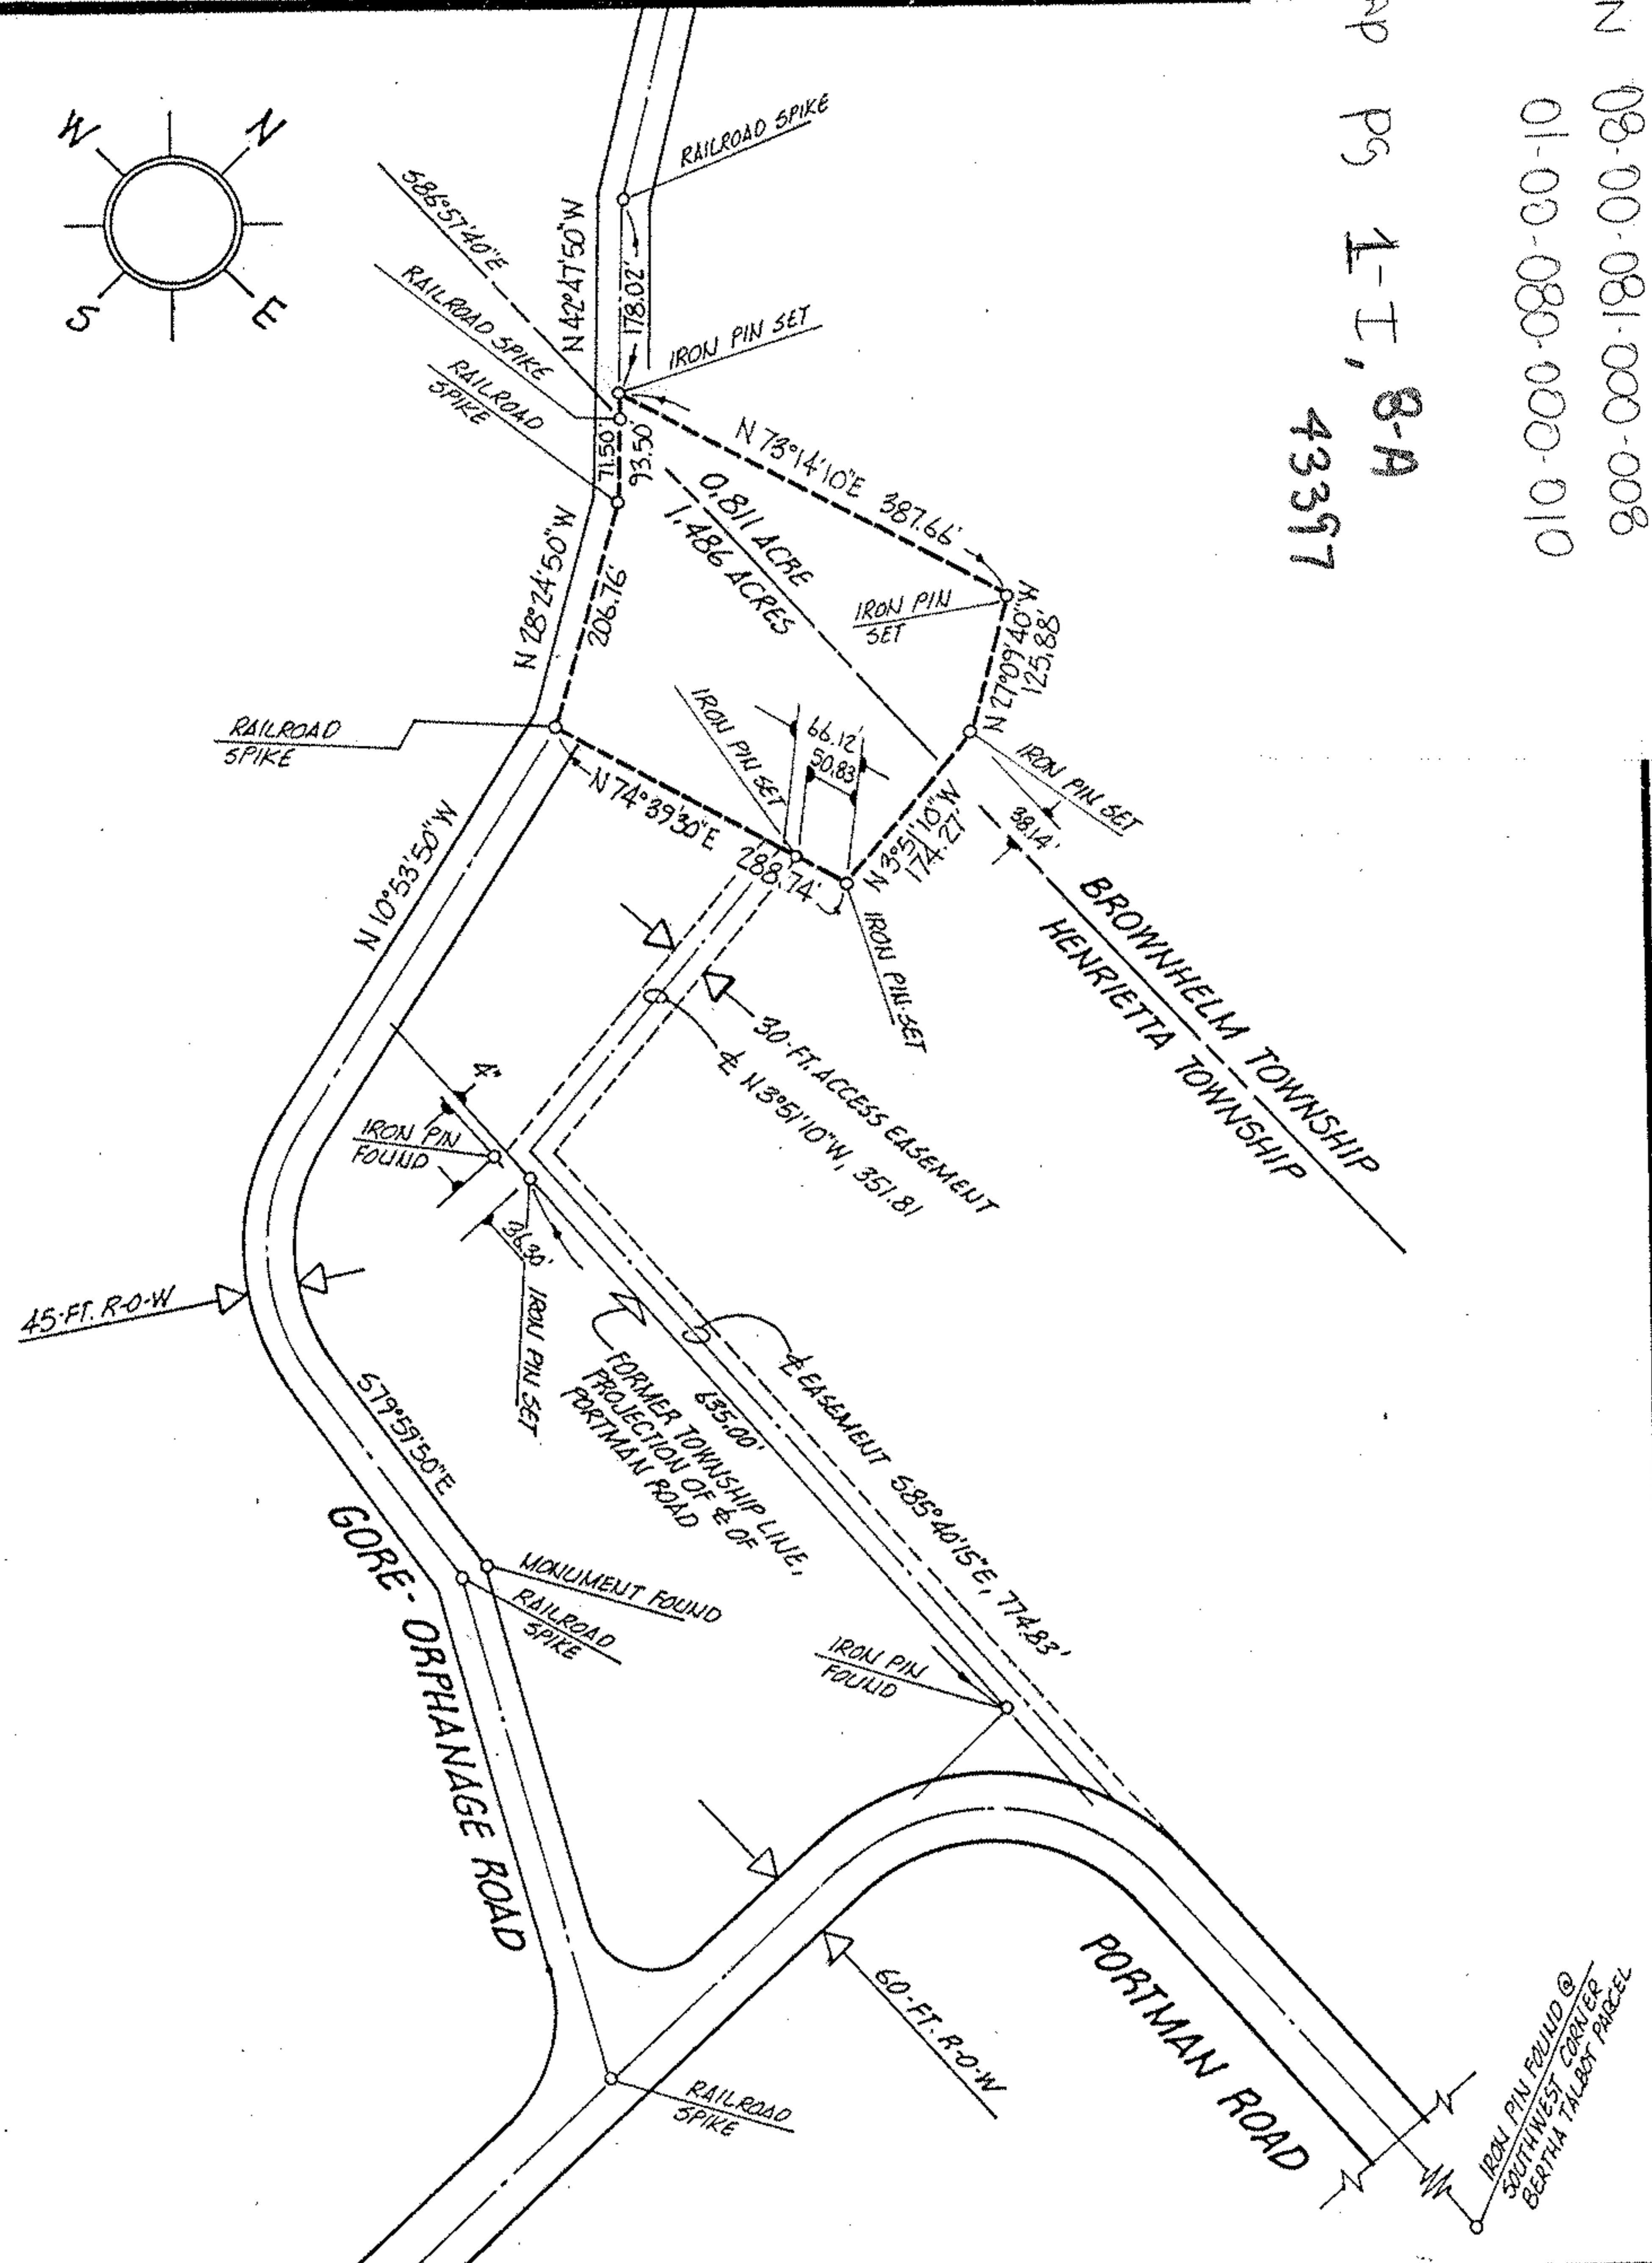


PPN 08-00-081-000-008

01-00-080-000-010

MAP PG 1-I, 8-A  
43397

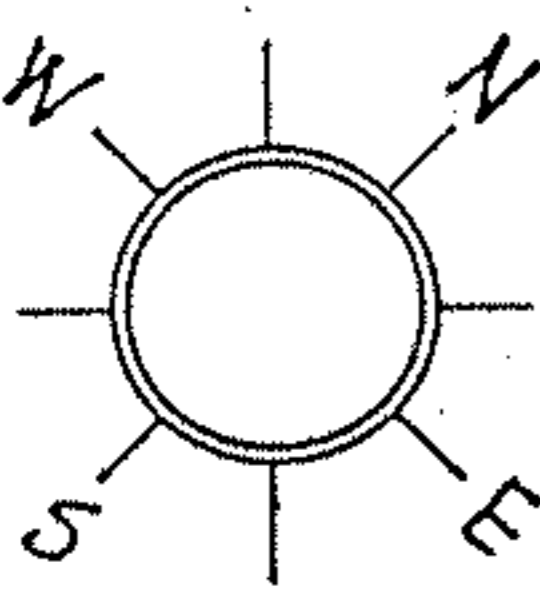

ACREAGE 2.297	PREPARED FOR <u>ROL ANGERSBACH</u> 965.7141
DATE <u>OCT 1986</u>	<u>51900 PORTMAN ROAD, AMHERST, OHIO</u>
DRAWN <u>MGH</u>	MICHAEL G. HURA, registered surveyor 12706 MASON RD., VERMILION, O., Ph (216) 965 4040
SCALE 1" = 200 ft.	
	<b>PERIMETER SURVEY</b>
	SUBLOT(s) _____ of _____, Volume _____ Page _____ of PLATS
	PART OF O.L. <u>80/81</u> TRACT _____ SECTION _____ OF <u>BROWNHELM &amp; HENRIETTA</u> TOWNSHIPS <u>LORAIN</u> CO., OHIO
	PERMANENT PARCEL NO. _____

1-I  
08-00-081-000-008  
01-00-080-000-010  
13.80 A.