



1-00-004-115-005
1-00-004-B

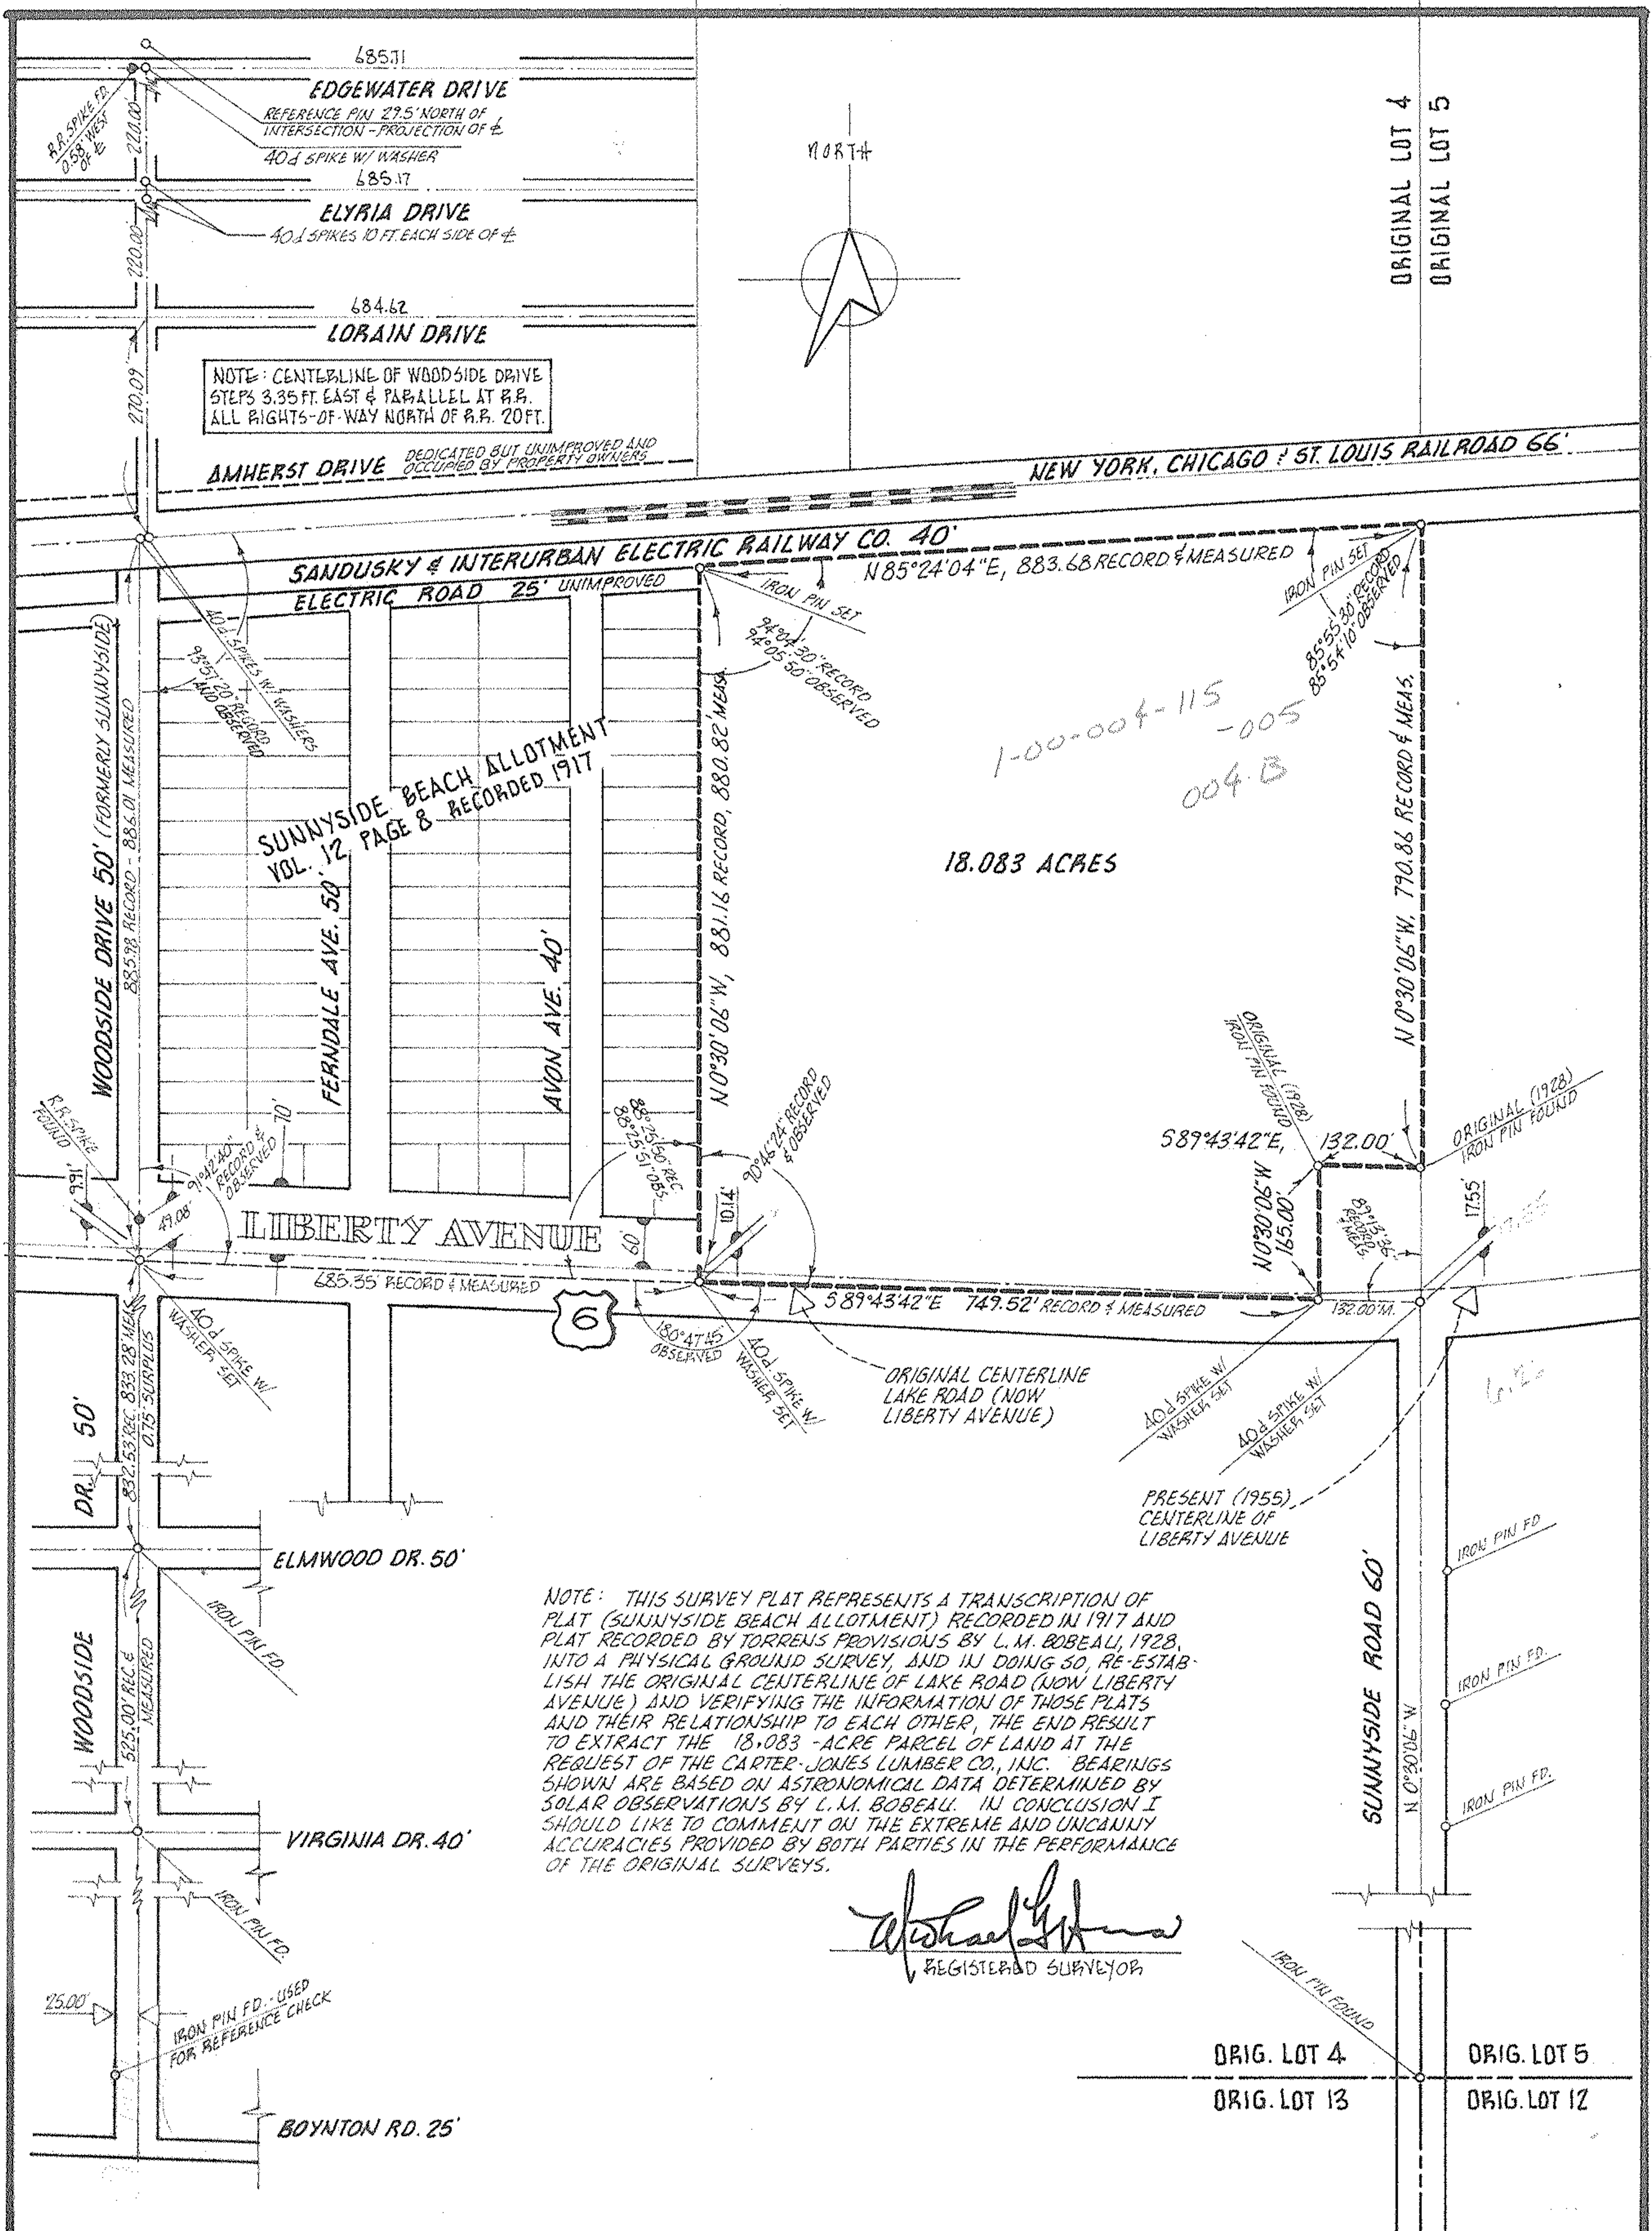

NOTE: THIS SURVEY PLAT REPRESENTS A TRANSCRIPTION OF PLAT (SUNNYSIDE BEACH ALLOTMENT) RECORDED IN 1917 AND PLAT RECORDED BY TORRENS PROVISIONS BY L. M. BOBEAL, 1928, INTO A PHYSICAL GROUND SURVEY, AND IN DOING SO, RE-ESTABLISH THE ORIGINAL CENTERLINE OF LAKE ROAD (NOW LIBERTY AVENUE) AND VERIFYING THE INFORMATION OF THOSE PLATS AND THEIR RELATIONSHIP TO EACH OTHER, THE END RESULT TO EXTRACT THE 18.083-ACRE PARCEL OF LAND AT THE REQUEST OF THE CARTER-JONES LUMBER CO., INC. BEARINGS SHOWN ARE BASED ON ASTRONOMICAL DATA DETERMINED BY SOLAR OBSERVATIONS BY L. M. BOBEAL. IN CONCLUSION I SHOULD LIKE TO COMMENT ON THE EXTREME AND UNCANNY ACCURACIES PROVIDED BY BOTH PARTIES IN THE PERFORMANCE OF THE ORIGINAL SURVEYS.

Michael G. Hura
REGISTERED SURVEYOR

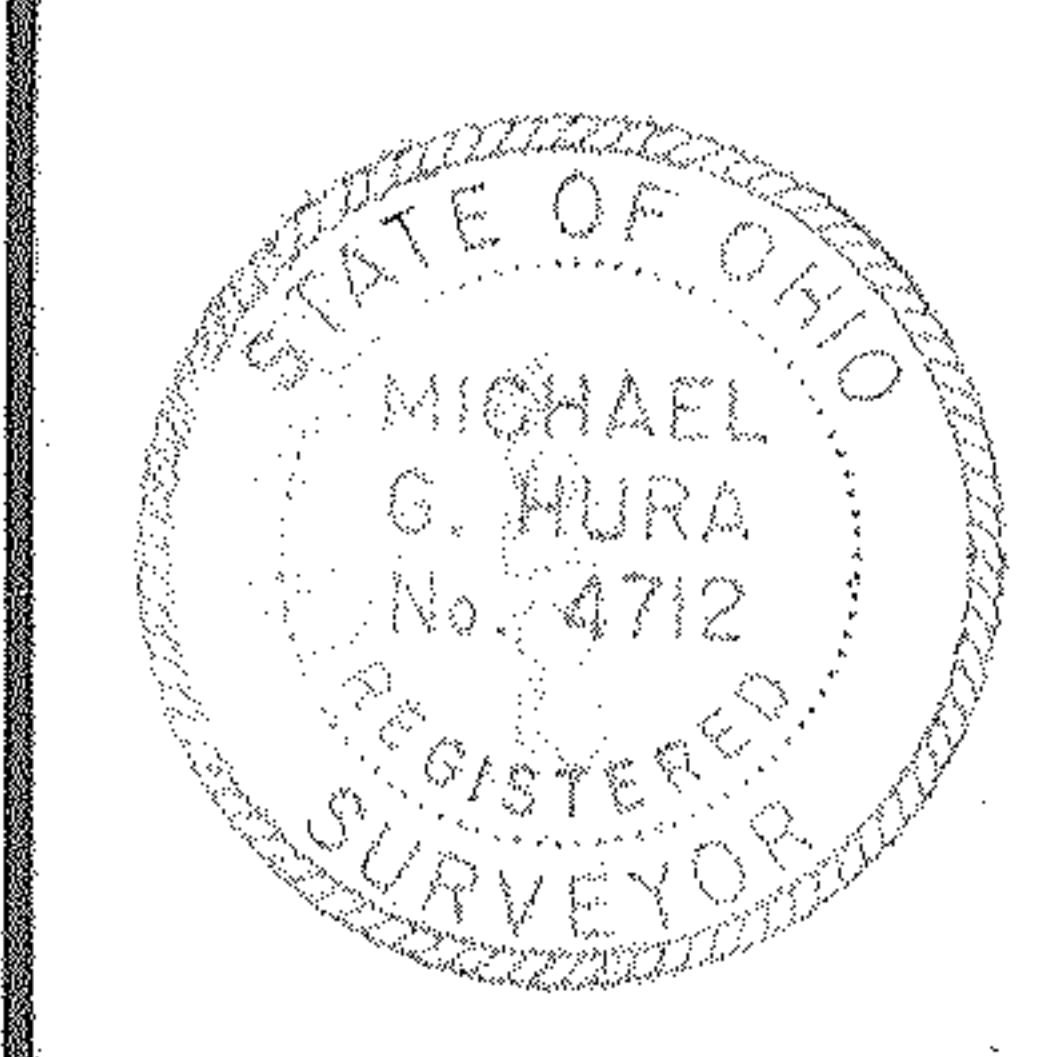

MICHAEL G. HURA & ASSOCIATES
3409 LIBERTY AVENUE VERMILION, OHIO 44089
(216) 967-6119

PREPARED FOR THE CARTER-JONES LUMBER CO., INC.

PERIMETER SURVEY - 18.083-ACRE
PARCEL, ORIGINAL LOT 4, BROWNHELM TWP.,
CITY OF VERMILION, LORAIN COUNTY, OHIO,
INCLUDING SUBSTANTIATING INFORMATION

DATE 08-13-82 CHECKED
DRAWN MGH SCALE 1"=200'

no.		date		REVISIONS	

ORIGINAL LOT 4
ORIGINAL LOT 5

ORIG. LOT 4
ORIG. LOT 13
ORIG. LOT 5
ORIG. LOT 12